

REFERENCE INFORMATION & FILE NO. OF SURVEYS

08/13/18 CHANGED FLASHING BEACON TO RRFB
(6) 12/19/14 NEW FLASHING BEACON ACTIVATED THRU 2003J
NO. DATE DESCRIPTION

TABLE OF REVISIONS
CHECK WITH TRACING TO SEE IF YOU HAVE LATEST REVISION

SHEET NOTES:

SCALE:


P.LOUIE 5/2013

CHECKED: DATE: D.CURTIS 5/2013 AS SHOWN

SHEET OF SHEETS

1 OF 1

JSF TECHNOLOGIES AB-9207 HYBRID SINGLE SIDED RAPID RECTANGULAR FLASHING BEACON ASSEMBLY

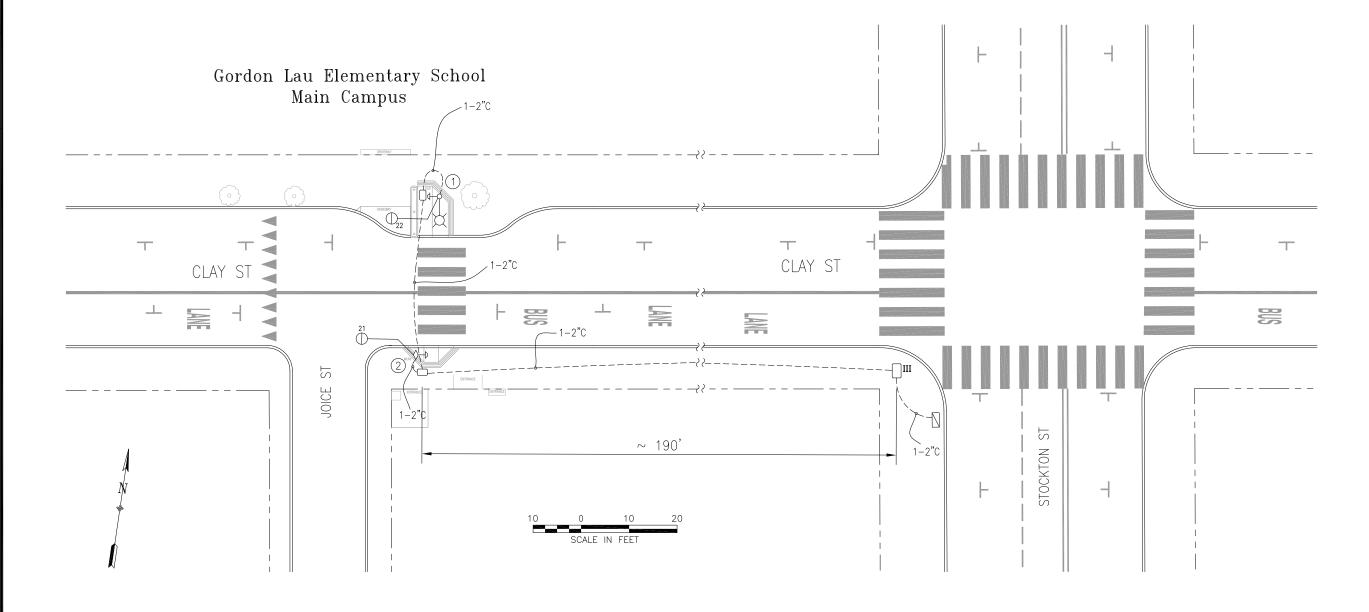

SAN FRANCISCO MUNICIPAL TRANSPORTATION AGENCY

CITY AND COUNTY OF SAN FRANCISCO

FILE NAME: DATE: --/--

25009000

TRAFFIC SIGNAL INVENTORY DIAGRAM

CLAY STREET AT JOICE STREET