


CLAY & KEARNY

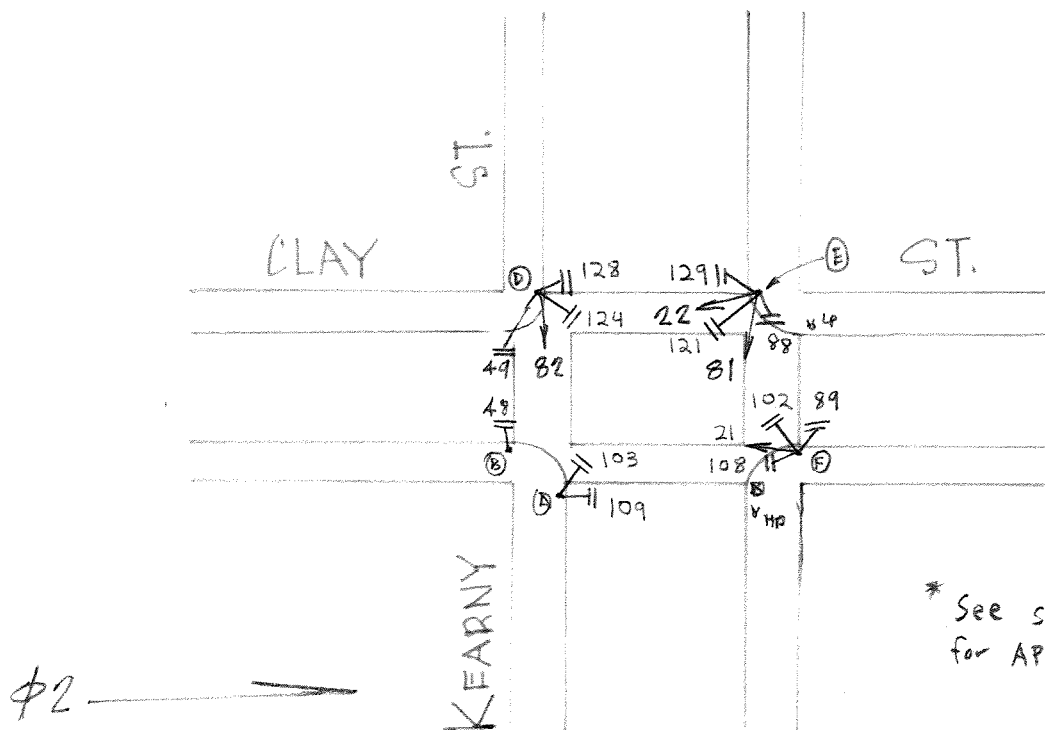

5-2-2023

POLE	FUNC.	MAT'L	SIGNAL NO.	MAKE	NO. OF SECT.	SIZE	VISOR	B.P. OR LOUVERS	MOUN'T	PED SIGNAL NO.	LEGEND	MESSAGE		MAKE	MOUN'T
												ELEMENT	COLOR		
A	L	S	82	EC	4	12" RYG GRA	T	NO	T	109	COUNT	LED	W/OR	ED	S
B	S	S	22	EC	4	12" RYG GLA	T	NO	S	48	COUNT	LED	W/OR	ED	T
			81	EC	4	12" RYG GRA	T	NO	S	49	COUNT	LED	W/OR	ED	S
D	S	S	21	EC	4	12" RYG GLA	T	NO	S	128	COUNT	LED	W/OR	ED	S
E	L	S								129	COUNT	LED	W/OR	ED	S
F	L	S								88	COUNT	LED	W/OR	ED	S
										89	COUNT	LED	W/OR	ED	S
										108	COUNT	LED	W/OR	ED	S
										121	COUNT	LED	W/OR		S
										102	COUNT	LED	W/OR		S
										103	COUNT	LED	W/OR		S
										124	COUNT	LED	W/OR		S

CONTROLLER CABINET SIZE : ORDINARY BASE CABINET: YES

COMMENTS : Install new APS per SRC 2022-199

- D. Yeung 5-2-2023