


CLAY & MONTGOMERY

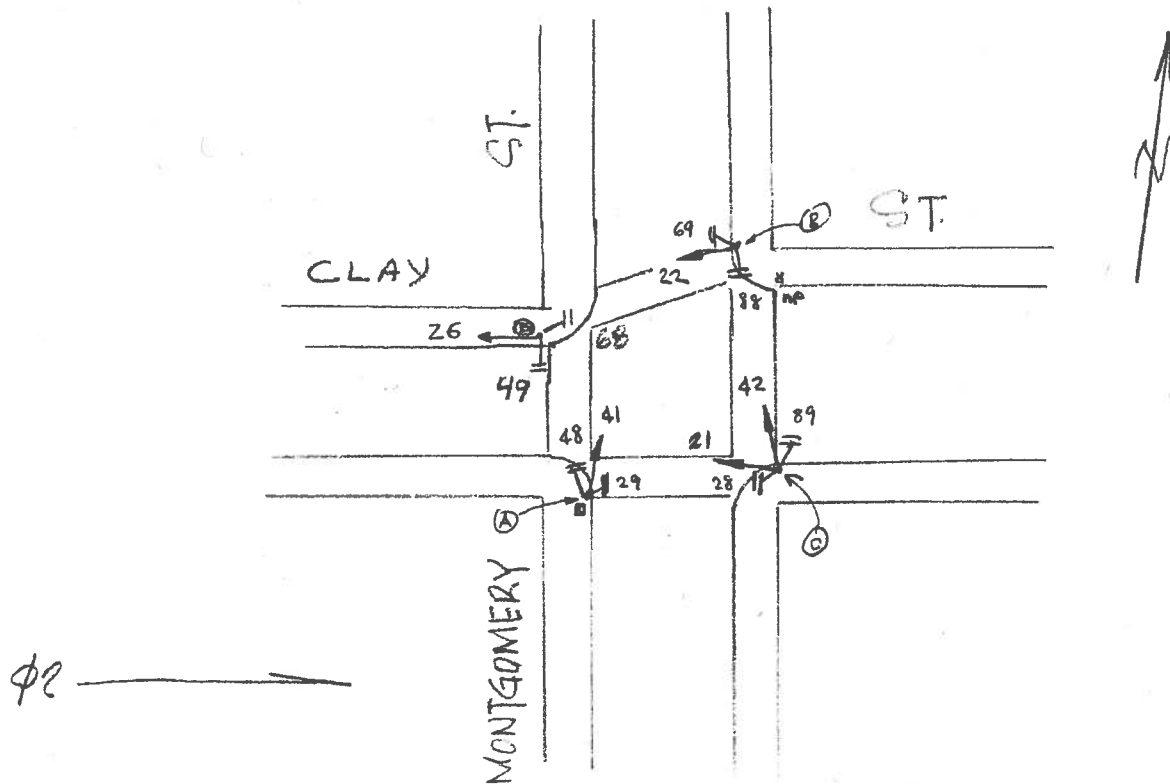

AS OF 09/18/2019

[illegible]

CONTROLLER CABINET SIZE : ORDINARY BASE CABINET: YES

COMMENTS :

per. SRC 2018-417, upgrade signals 21, 22, 41, 42 to 12" A.kim