


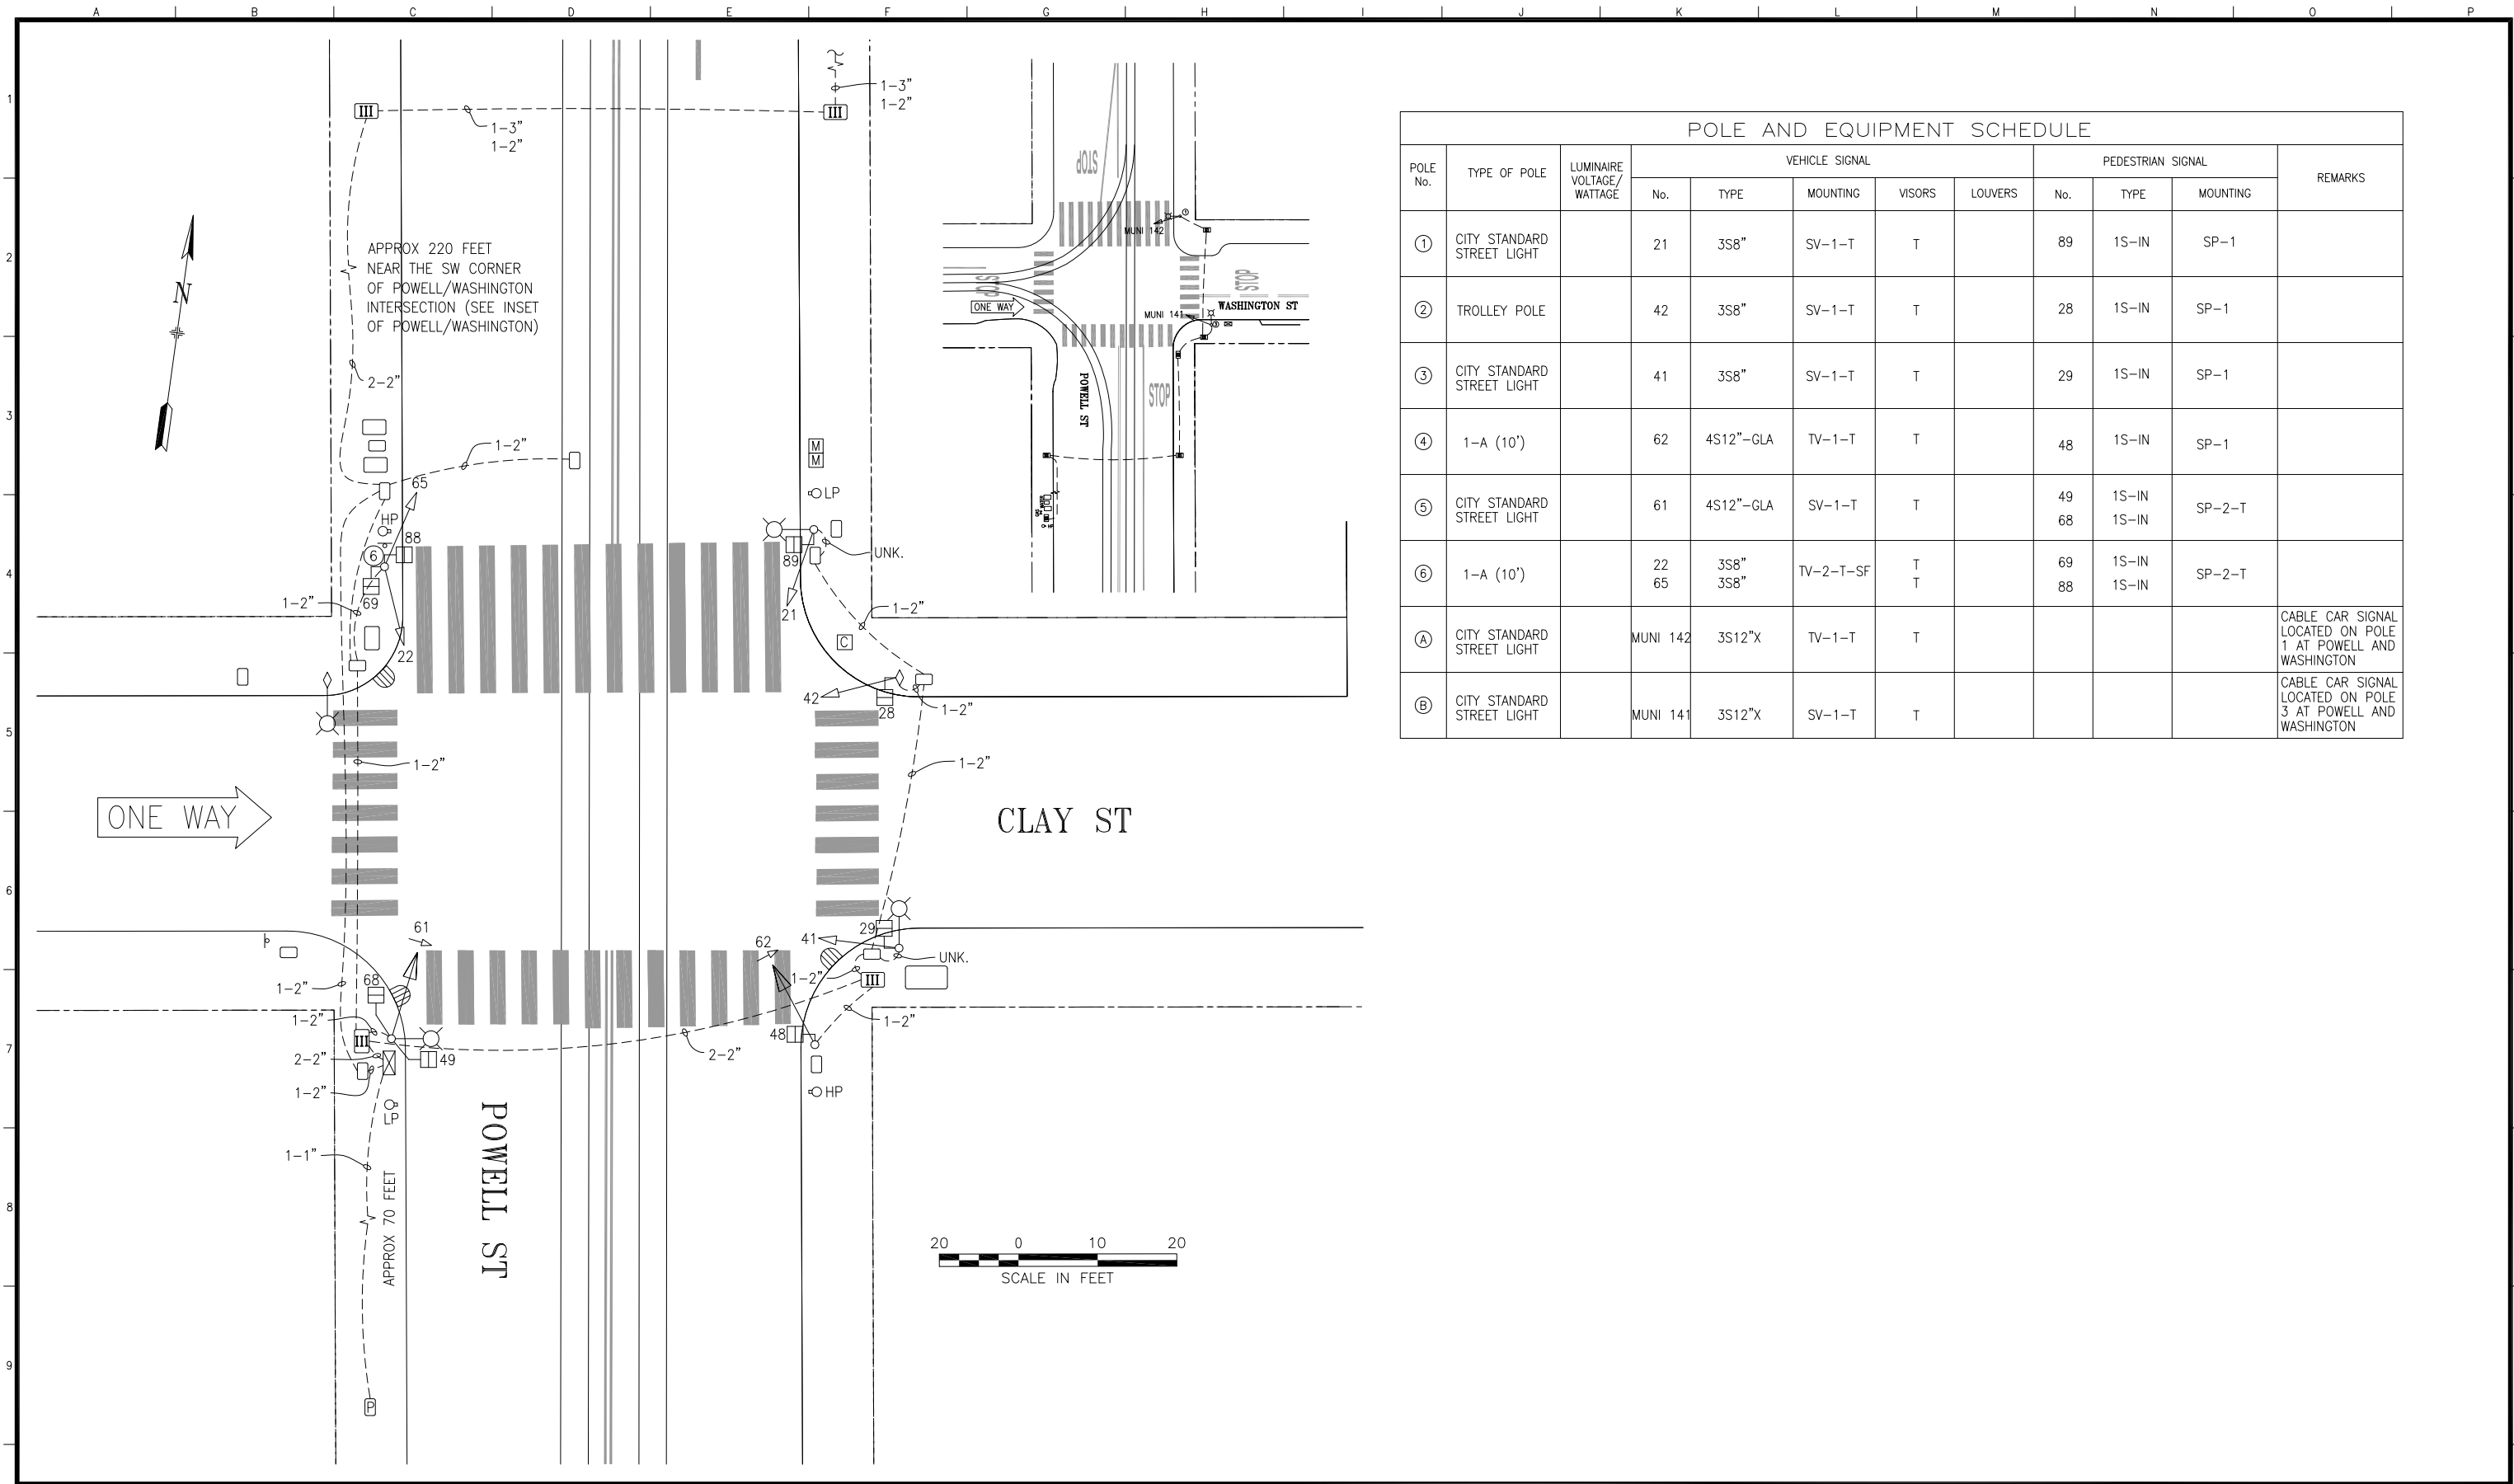

POLE AND EQUIPMENT SCHEDULE											
POLE No.	TYPE OF POLE	LUMINAIRE VOLTAGE/WATTAGE	VEHICLE SIGNAL					PEDESTRIAN SIGNAL			REMARKS
			No.	TYPE	MOUNTING	VISORS	LOUVERS	No.	TYPE	MOUNTING	
①	CITY STANDARD STREET LIGHT		21	3S8"	SV-1-T	T		89	1S-IN	SP-1	
②	TROLLEY POLE		42	3S8"	SV-1-T	T		28	1S-IN	SP-1	
③	CITY STANDARD STREET LIGHT		41	3S8"	SV-1-T	T		29	1S-IN	SP-1	
④	1-A (10')		62	4S12"-GLA	TV-1-T	T		48	1S-IN	SP-1	
⑤	CITY STANDARD STREET LIGHT		61	4S12"-GLA	SV-1-T	T		49 68	1S-IN 1S-IN	SP-2-T	
⑥	1-A (10')		22 65	3S8" 3S8"	TV-2-T-SF	T T		69 88	1S-IN 1S-IN	SP-2-T	
Ⓐ	CITY STANDARD STREET LIGHT		MUNI 142	3S12"X	TV-1-T	T					CABLE CAR SIGNAL LOCATED ON POLE 1 AT POWELL AND WASHINGTON
Ⓑ	CITY STANDARD STREET LIGHT		MUNI 141	3S12"X	SV-1-T	T					CABLE CAR SIGNAL LOCATED ON POLE 3 AT POWELL AND WASHINGTON

NO.	DATE	DESCRIPTION	BY	APP.
1	2/3/15	ADDED SIGNALS 141 & 142 LOCATED AT POWELL/WASHINGTON	JH	MV
0	8/29/96	NEW SIGNAL ACTIVATED THROUGH 1019N CONVERTED FROM 1019N AS-BUILTS	SS	MV

TABLE OF REVISIONS
CHECK WITH TRACING TO SEE IF YOU HAVE LATEST REVISION

REFERENCE INFORMATION & FILE NO. OF SURVEYS
--



SAN FRANCISCO MUNICIPAL TRANSPORTATION AGENCY

CITY AND COUNTY OF SAN FRANCISCO

DRAWN:	DATE:
SS	2/27/2015
CHECKED:	DATE:
MV/HQ	3/2/2015

SCALE:
AS SHOWN
SHEET OF SHEETS
01 OF 01

TRAFFIC SIGNAL INVENTORY DIAGRAM
CLAY STREET AND POWELL STREET

CNN NO.
25014000
REV NO.
1