


CLAY & SANSOME

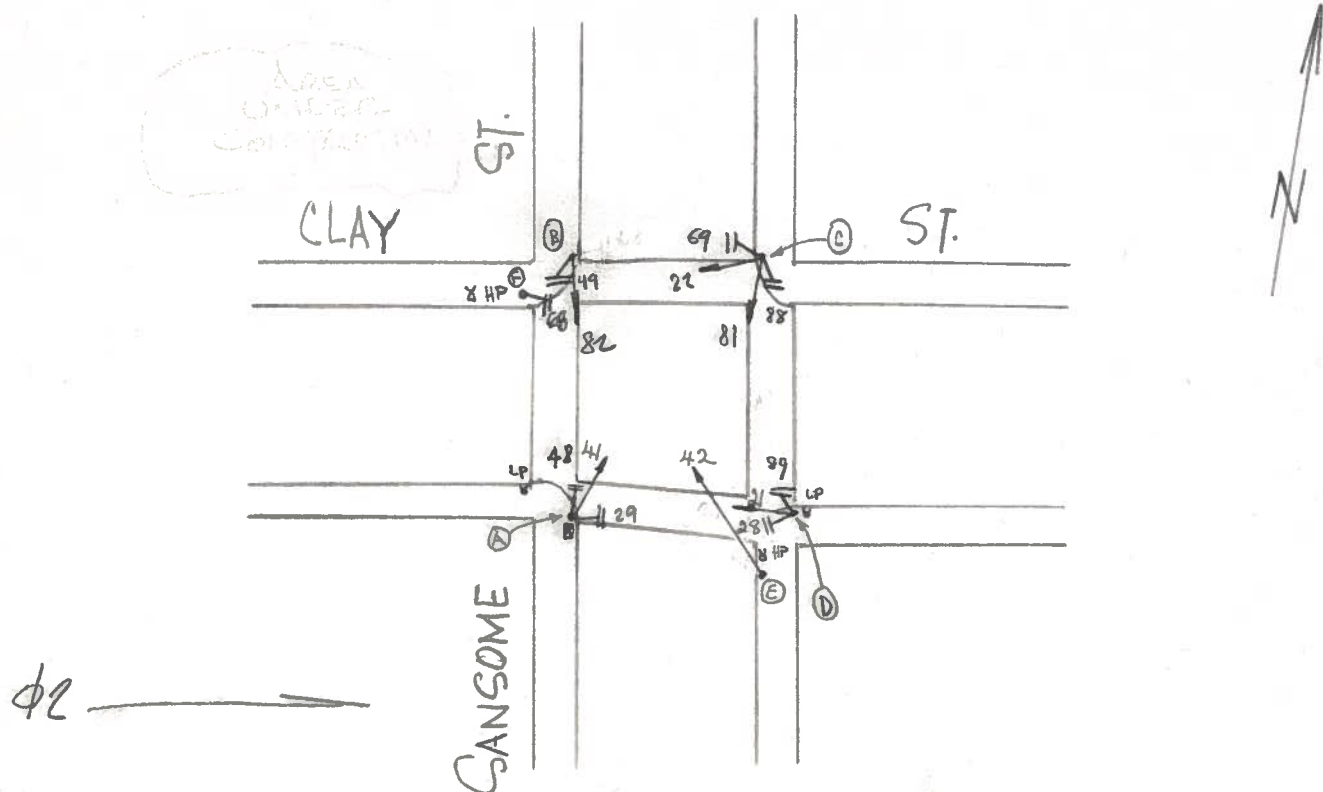

AS OF 11/12/2019

POLE	FUNC.	MAT'L	SIGNAL NO.	MAKE	NO. OF SECT.	SIZE	VISOR	B.P. OR LOUVERS	MOUN'T	PED SIGNAL NO.	LEGEND	MESSAGE		MAKE	MOUN'T
												ELEMENT	COLOR		
A	L	S	82	IGA	3	12"	T 12"	No	S	29	I	IS-I	W/OR	ICC	S
B	L	S	22	EC	3	12"	FT 12"	No	S	48	I	IS-I	W/OR	ICC	S
C	L	S	81	EC	3	12"	T 12"	No	S	49	I	IS-I	W/OR	ICC	S
D	L	S	21	EC	3	12"	T 12"	No	S	68	I	IS-I	W/OR	ICC	S
E	L	S	41	CH	3	12"	T 12"	No	T	69	I	IS-I	W/OR	ICC	S
F	L	S	42	CH	3	12"	T 12"	No	S	88	I	IS-I	W/OR	ICC	S
					3	8"	FL	No		89	I	IS-I	W/OR	ICC	S
					3	8"	FL	No		28	I	IS-I	W/OR	ICC	S

CONTROLLER CABINET SIZE : ORDINARY BASE CABINET: YES

COMMENTS : per SRC 2018-417, upgrade signals 82, 22, 81, 21, 41, 42 to 12". A.Kim
per field check, added Pole F. A.Kim