


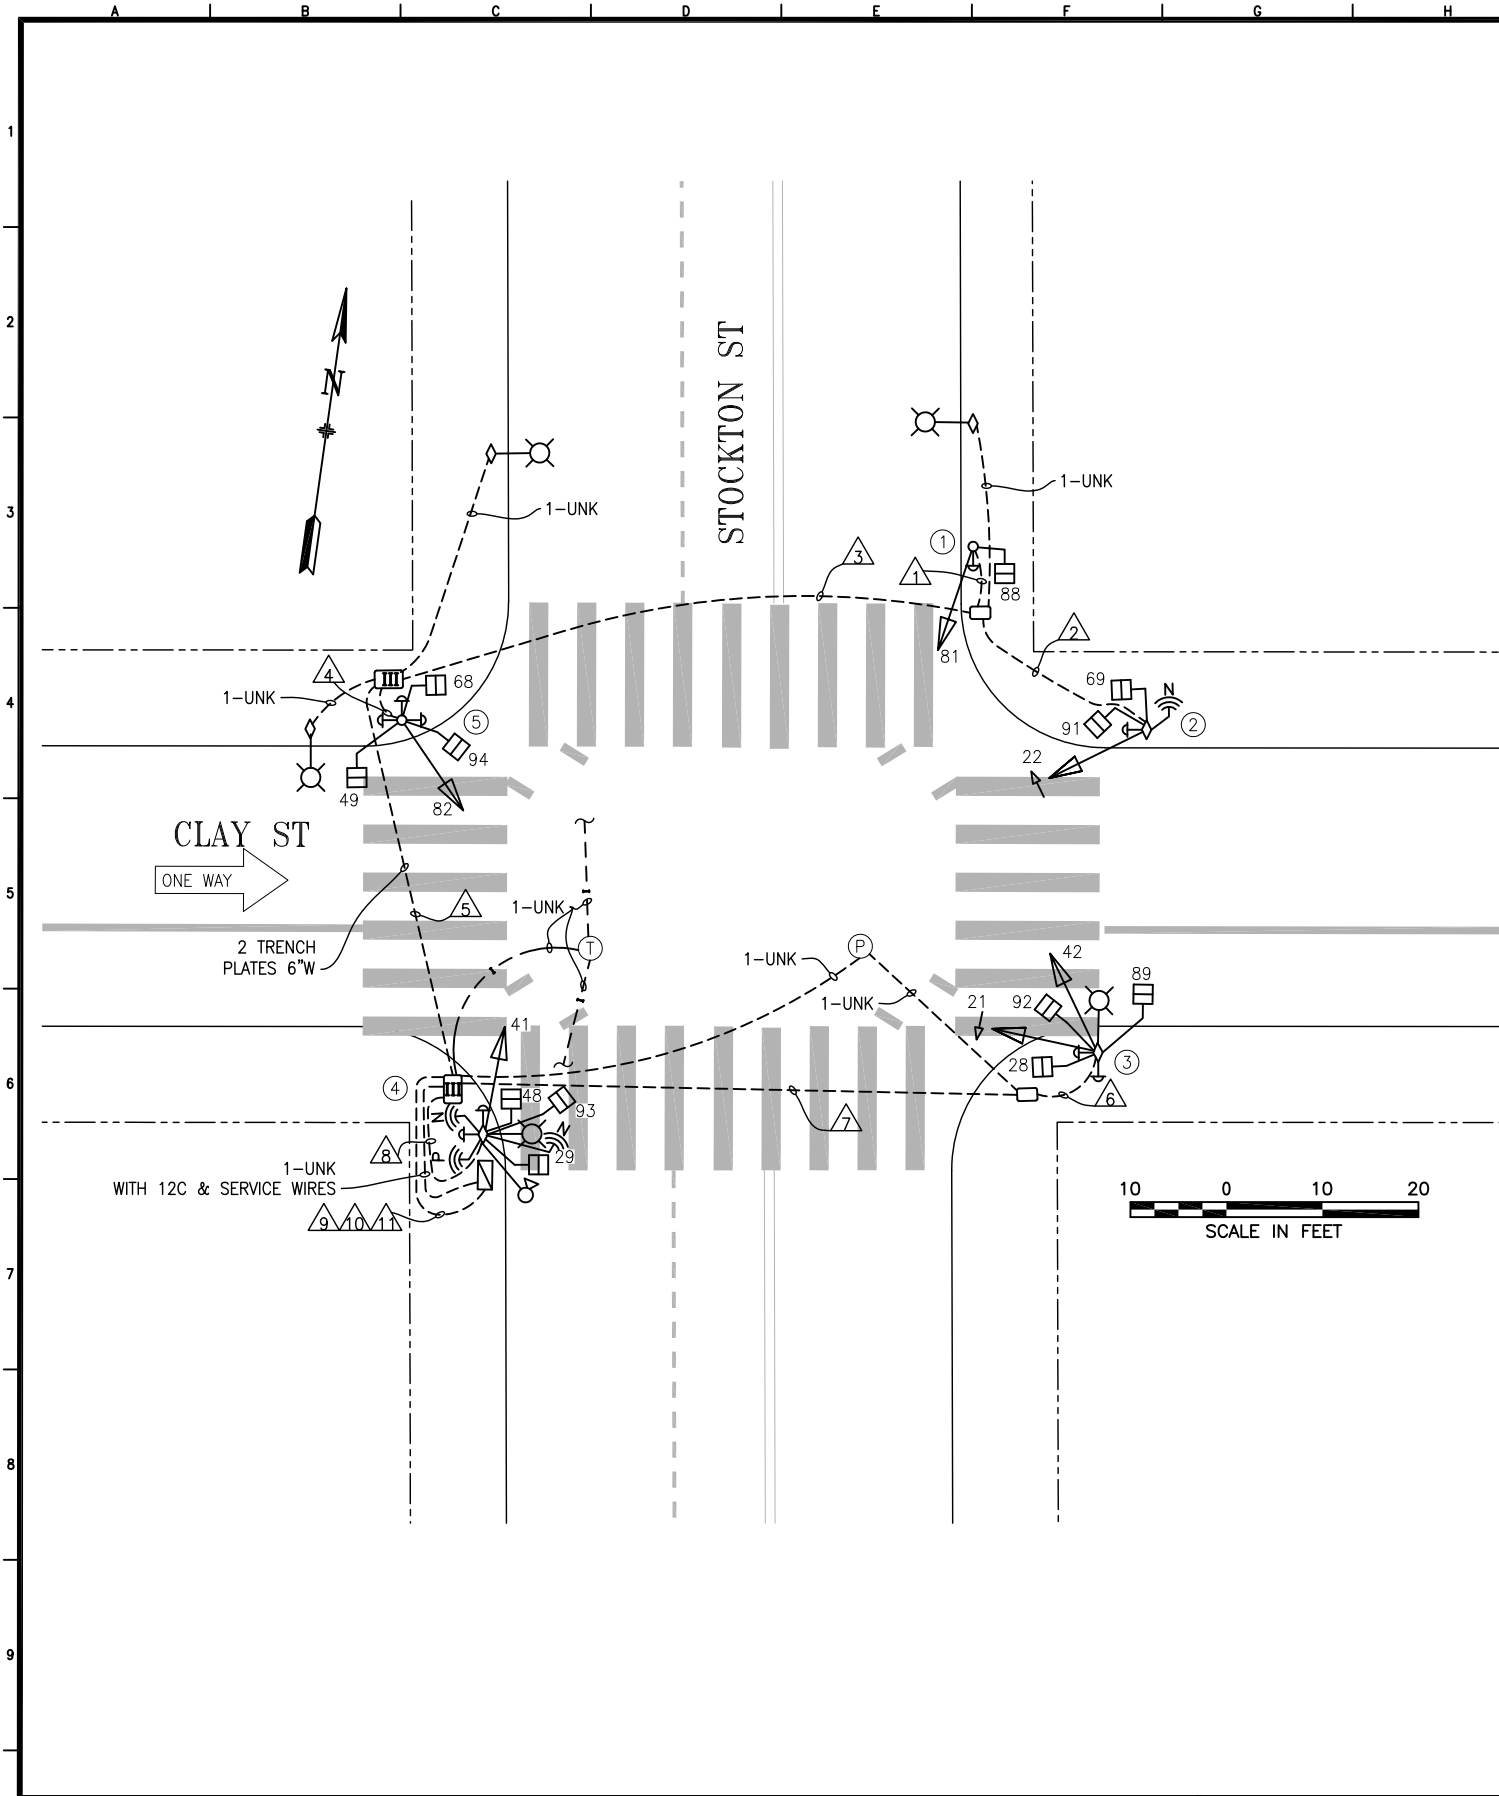

POLE AND EQUIPMENT SCHEDULE											
POLE No.	TYPE OF POLE	LUMINAIRE TYPE	VEHICLE SIGNAL					PEDESTRIAN SIGNAL			REMARKS
			No.	TYPE	MOUNTING	VISORS	LOUVERS/BP	No.	TYPE	MOUNTING	
①	1-A (10')		81	3S12"	TV-1-T	T		88	1S-C	SP-1	APS-3W
②	MUNI POLE		22	4S12"GLA	SV-1-T	T		69 91	1S-C 1S-C	SP-2-T-SF	NETWORK RADIO APS-3W
③	MUNI POLE W/ 6' LA		21 42	4S12"GRA 3S12"	SV-2-TC	T T		89 28 92	1S-C 1S-C 1S-C	SP-1 SP-2-T-SF .	APS-3W APS-3W
④	MUNI POLE W/ 6' LA		41	3S12"	SV-1-T	T		29 48 93	1S-C 1S-C 1S-C	SP-1 SP-2-T-SF .	PTZ CAMERA NETWORK RADIO x2 TSP RADIO APS-3W x2
⑤	1-A (10')		82	3S12"	TV-1-T	T		68 49 94	1S-C 1S-C 1S-C	SP-1(22") SP-2-T .	APS-3W APS-3W APS-3W

Δ	6/13/23	SRC 2023-044: UPGRADE SIGNALS 41, 42, 81 & 82 FROM 8 TO 12-INCH	D. YEUNG	G. DE LEON
Δ	5/4/23	INSTALL APS PER SRC 2022-199	D. YEUNG	G. DE LEON
Δ	2/9/23	UPDATE PER FIELD: CLARIFY TSP/NETWORK RADIOS	D. YEUNG	G. DE LEON
Δ	3/23/22	UPDATE PER FIELD: NOTE PTZ/TSP, CHANGE MOUNTINGS FOR 21,42,88,69,91. COUNTDOWN PED MODULES	D. YEUNG	G. DE LEON
Δ	3/2002	UPGRADE ACTIVATED THRU 1987N - CONVERTED FROM AS-BUILTS	D. YEUNG	G. DE LEON
NO.	DATE	DESCRIPTION	BY	APPROVED
TABLE OF REVISIONS CHECKOUT DRAWING THROUGH THE SID CUSTODIAN FOR THE LATEST REVISION				



SFMTA

DRAWN BY: D. YEUNG	DATE: 3/2022
CHECKED BY: G. DE LEON	DATE: 3/2022

SCALE AS SHOWN
SHEET OF SHEETS 1 OF 2

TRAFFIC SIGNAL INVENTORY DIAGRAM
CLAY ST AND STOCKTON ST

CNN NO: 24995000
REV NO: 4

