


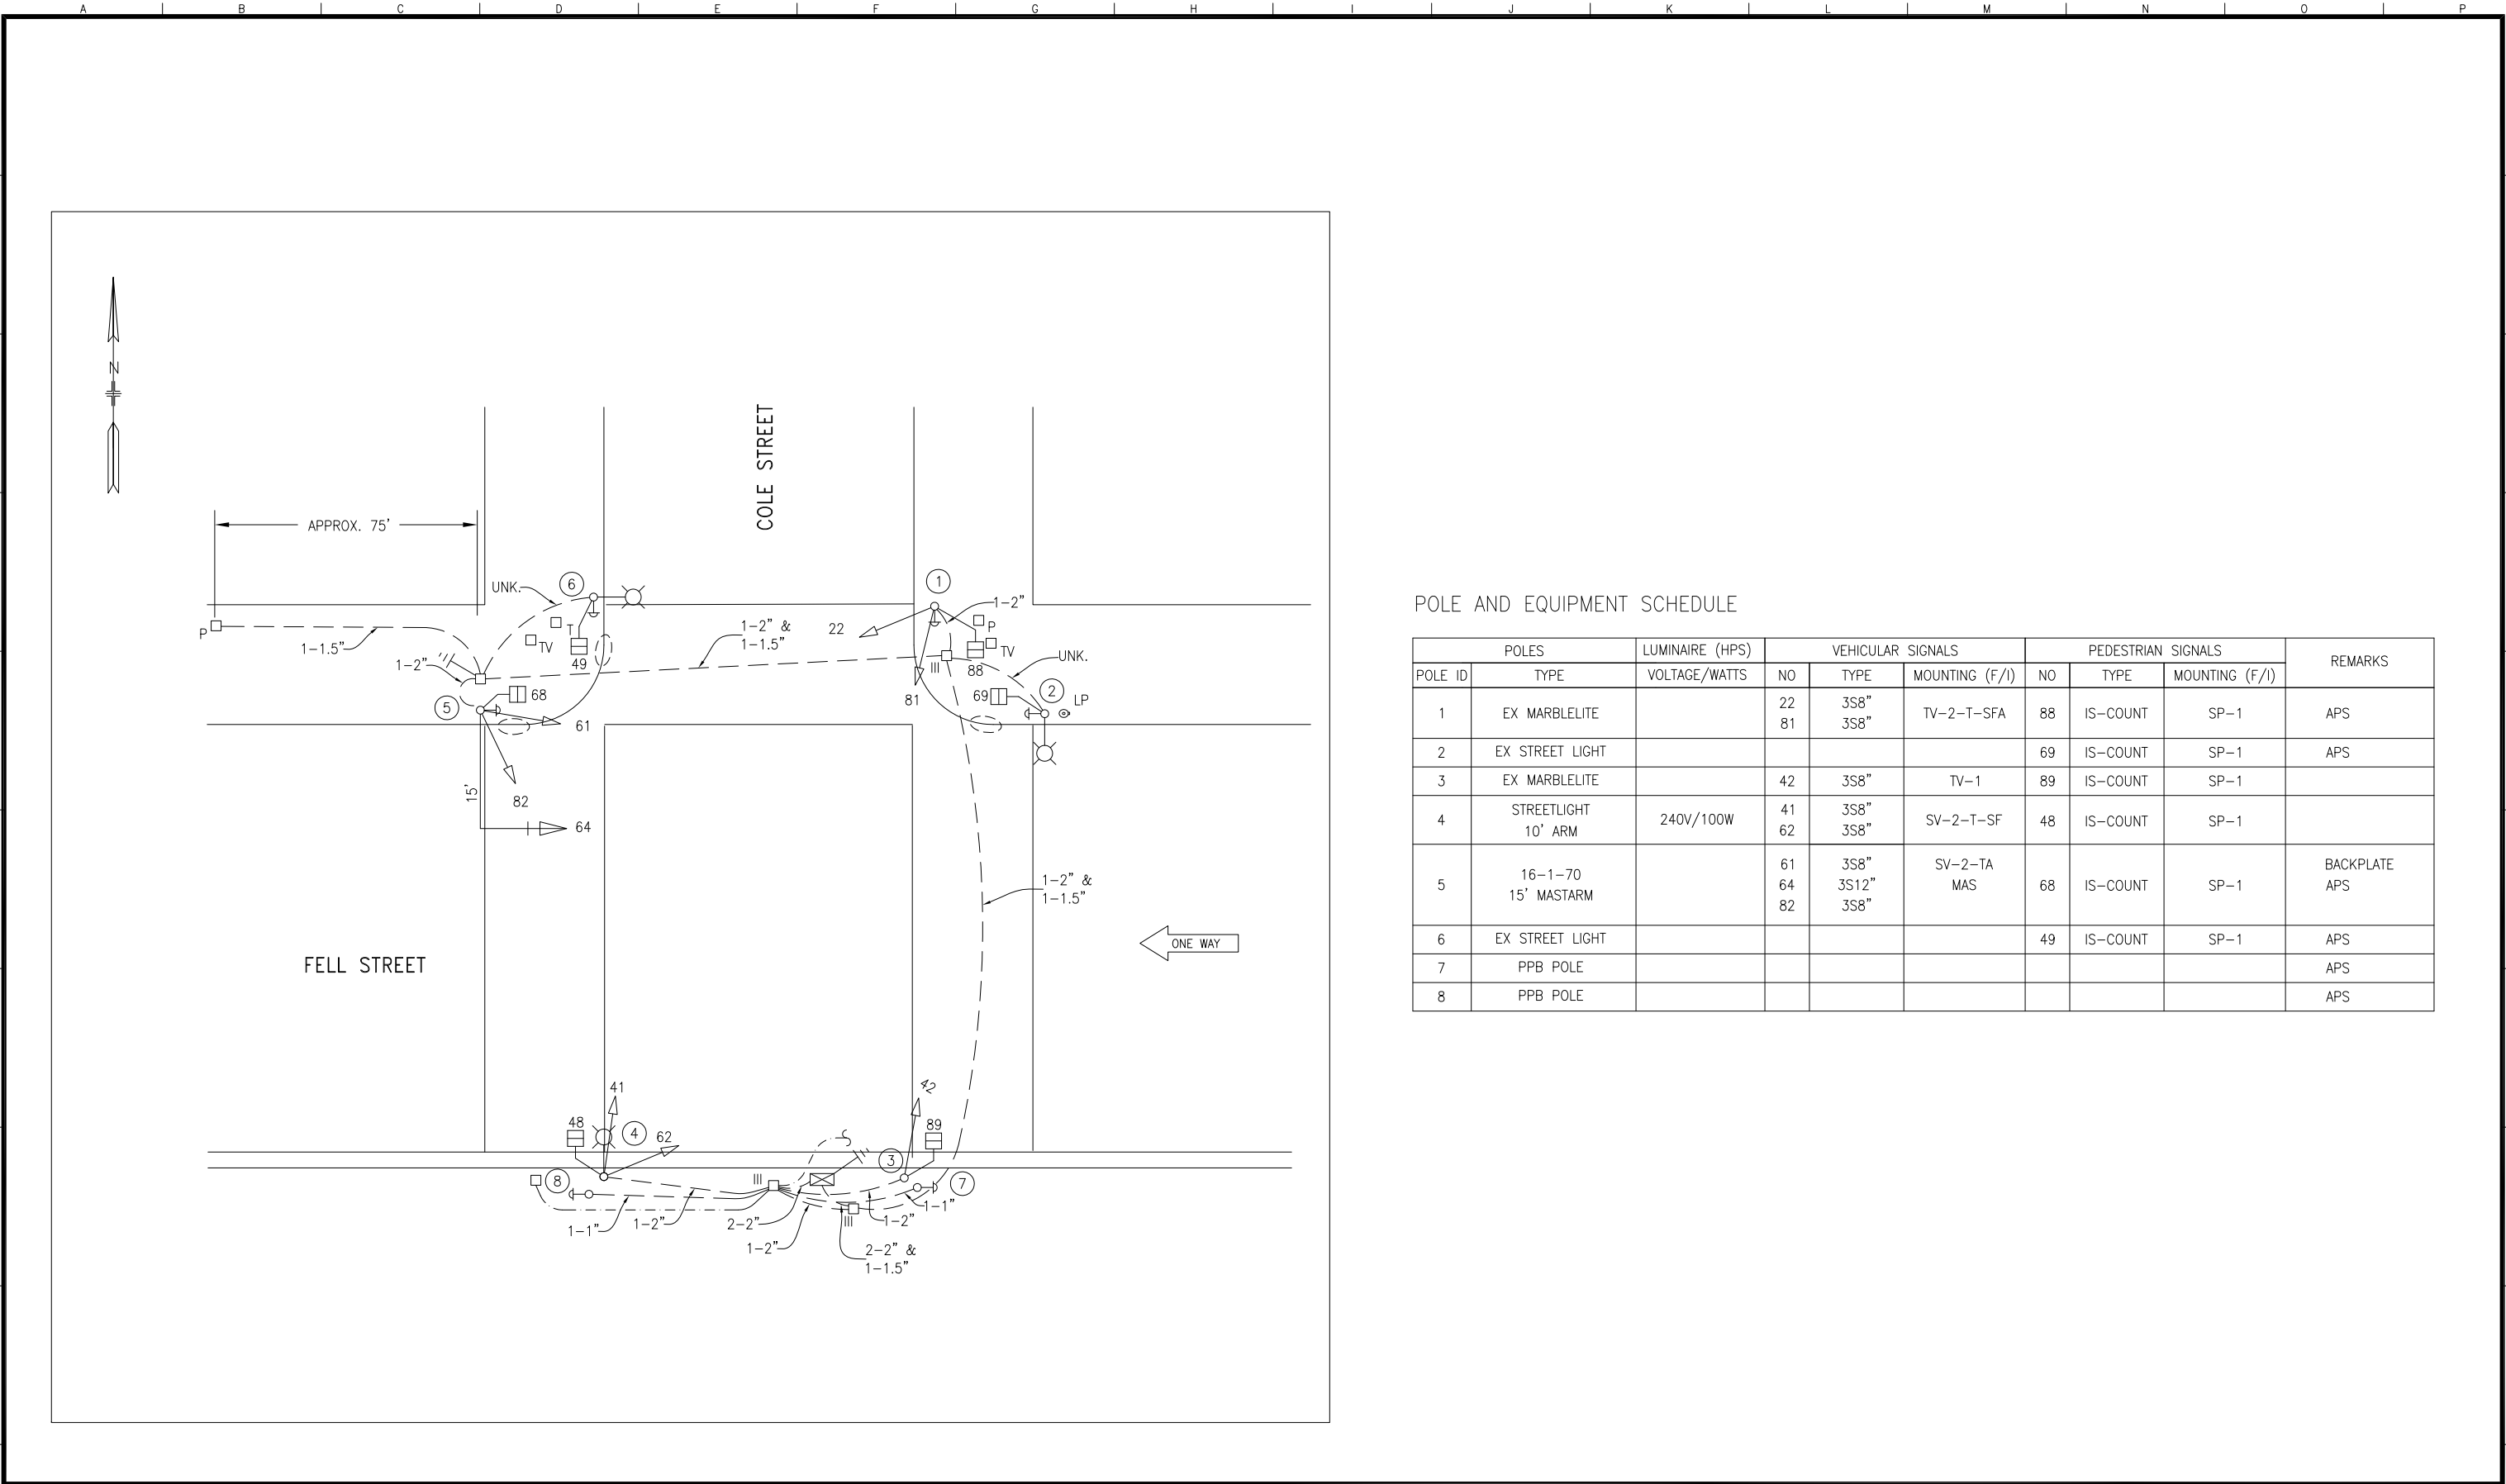

POLE AND EQUIPMENT SCHEDULE

POLES		LUMINAIRE (HPS)	VEHICULAR SIGNALS			PEDESTRIAN SIGNALS			REMARKS
POLE ID	TYPE	VOLTAGE/WATTS	NO	TYPE	MOUNTING (F/I)	NO	TYPE	MOUNTING (F/I)	
1	EX MARBLELITE		22 81	3S8" 3S8"	TV-2-T-SFA	88	IS-COUNT	SP-1	APS
2	EX STREET LIGHT					69	IS-COUNT	SP-1	APS
3	EX MARBLELITE		42	3S8"	TV-1	89	IS-COUNT	SP-1	
4	STREETLIGHT 10' ARM	240V/100W	41 62	3S8" 3S8"	SV-2-T-SF	48	IS-COUNT	SP-1	
5	16-1-70 15' MASTARM		61 64 82	3S8" 3S12" 3S8"	SV-2-TA MAS	68	IS-COUNT	SP-1	BACKPLATE APS
6	EX STREET LIGHT					49	IS-COUNT	SP-1	APS
7	PPB POLE								APS
8	PPB POLE								APS

NO.	DATE	DESCRIPTION	BY	APP.
2	5/8/15	ADDED POLES 7&8 PER SRC 2015-079	JH	MV
1	2/15/06	ADDED PED SIGNALS PER SRC 2005-245	GD	HQ
0	4/3/02	CONVERTED FROM 1660N AS-BUILT	JH	MV
TABLE OF REVISIONS CHECK WITH TRACING TO SEE IF YOU HAVE LATEST REVISION				

REFERENCE INFORMATION & FILE NO. OF SURVEYS
--



SAN FRANCISCO MUNICIPAL TRANSPORTATION AGENCY

CITY AND COUNTY OF SAN FRANCISCO

DRAWN:	DATE:
JH	3/2015
CHECKED:	DATE:
MV	3/2015

SCALE: 1" = 10 feet
SHEET OF SHEETS 1 OF 1

TRAFFIC SIGNAL INVENTORY DIAGRAM
COLE AND FELL STREETS

CNN NO. 26422000
REV NO. 2

FILE NAME: E-03-0.dwg
DATE: Feb 19 1998 10:31
ORIGIN: ELECTRICAL
SCALE FACTOR: 120
PLOT SCALE: 1"=1'
EXTERNAL REFERENCES: b34-22.dwg
FONTS USED: ROMANS.SHX ROMANS.SHX ROMANS.SHX ROMANT.txt