


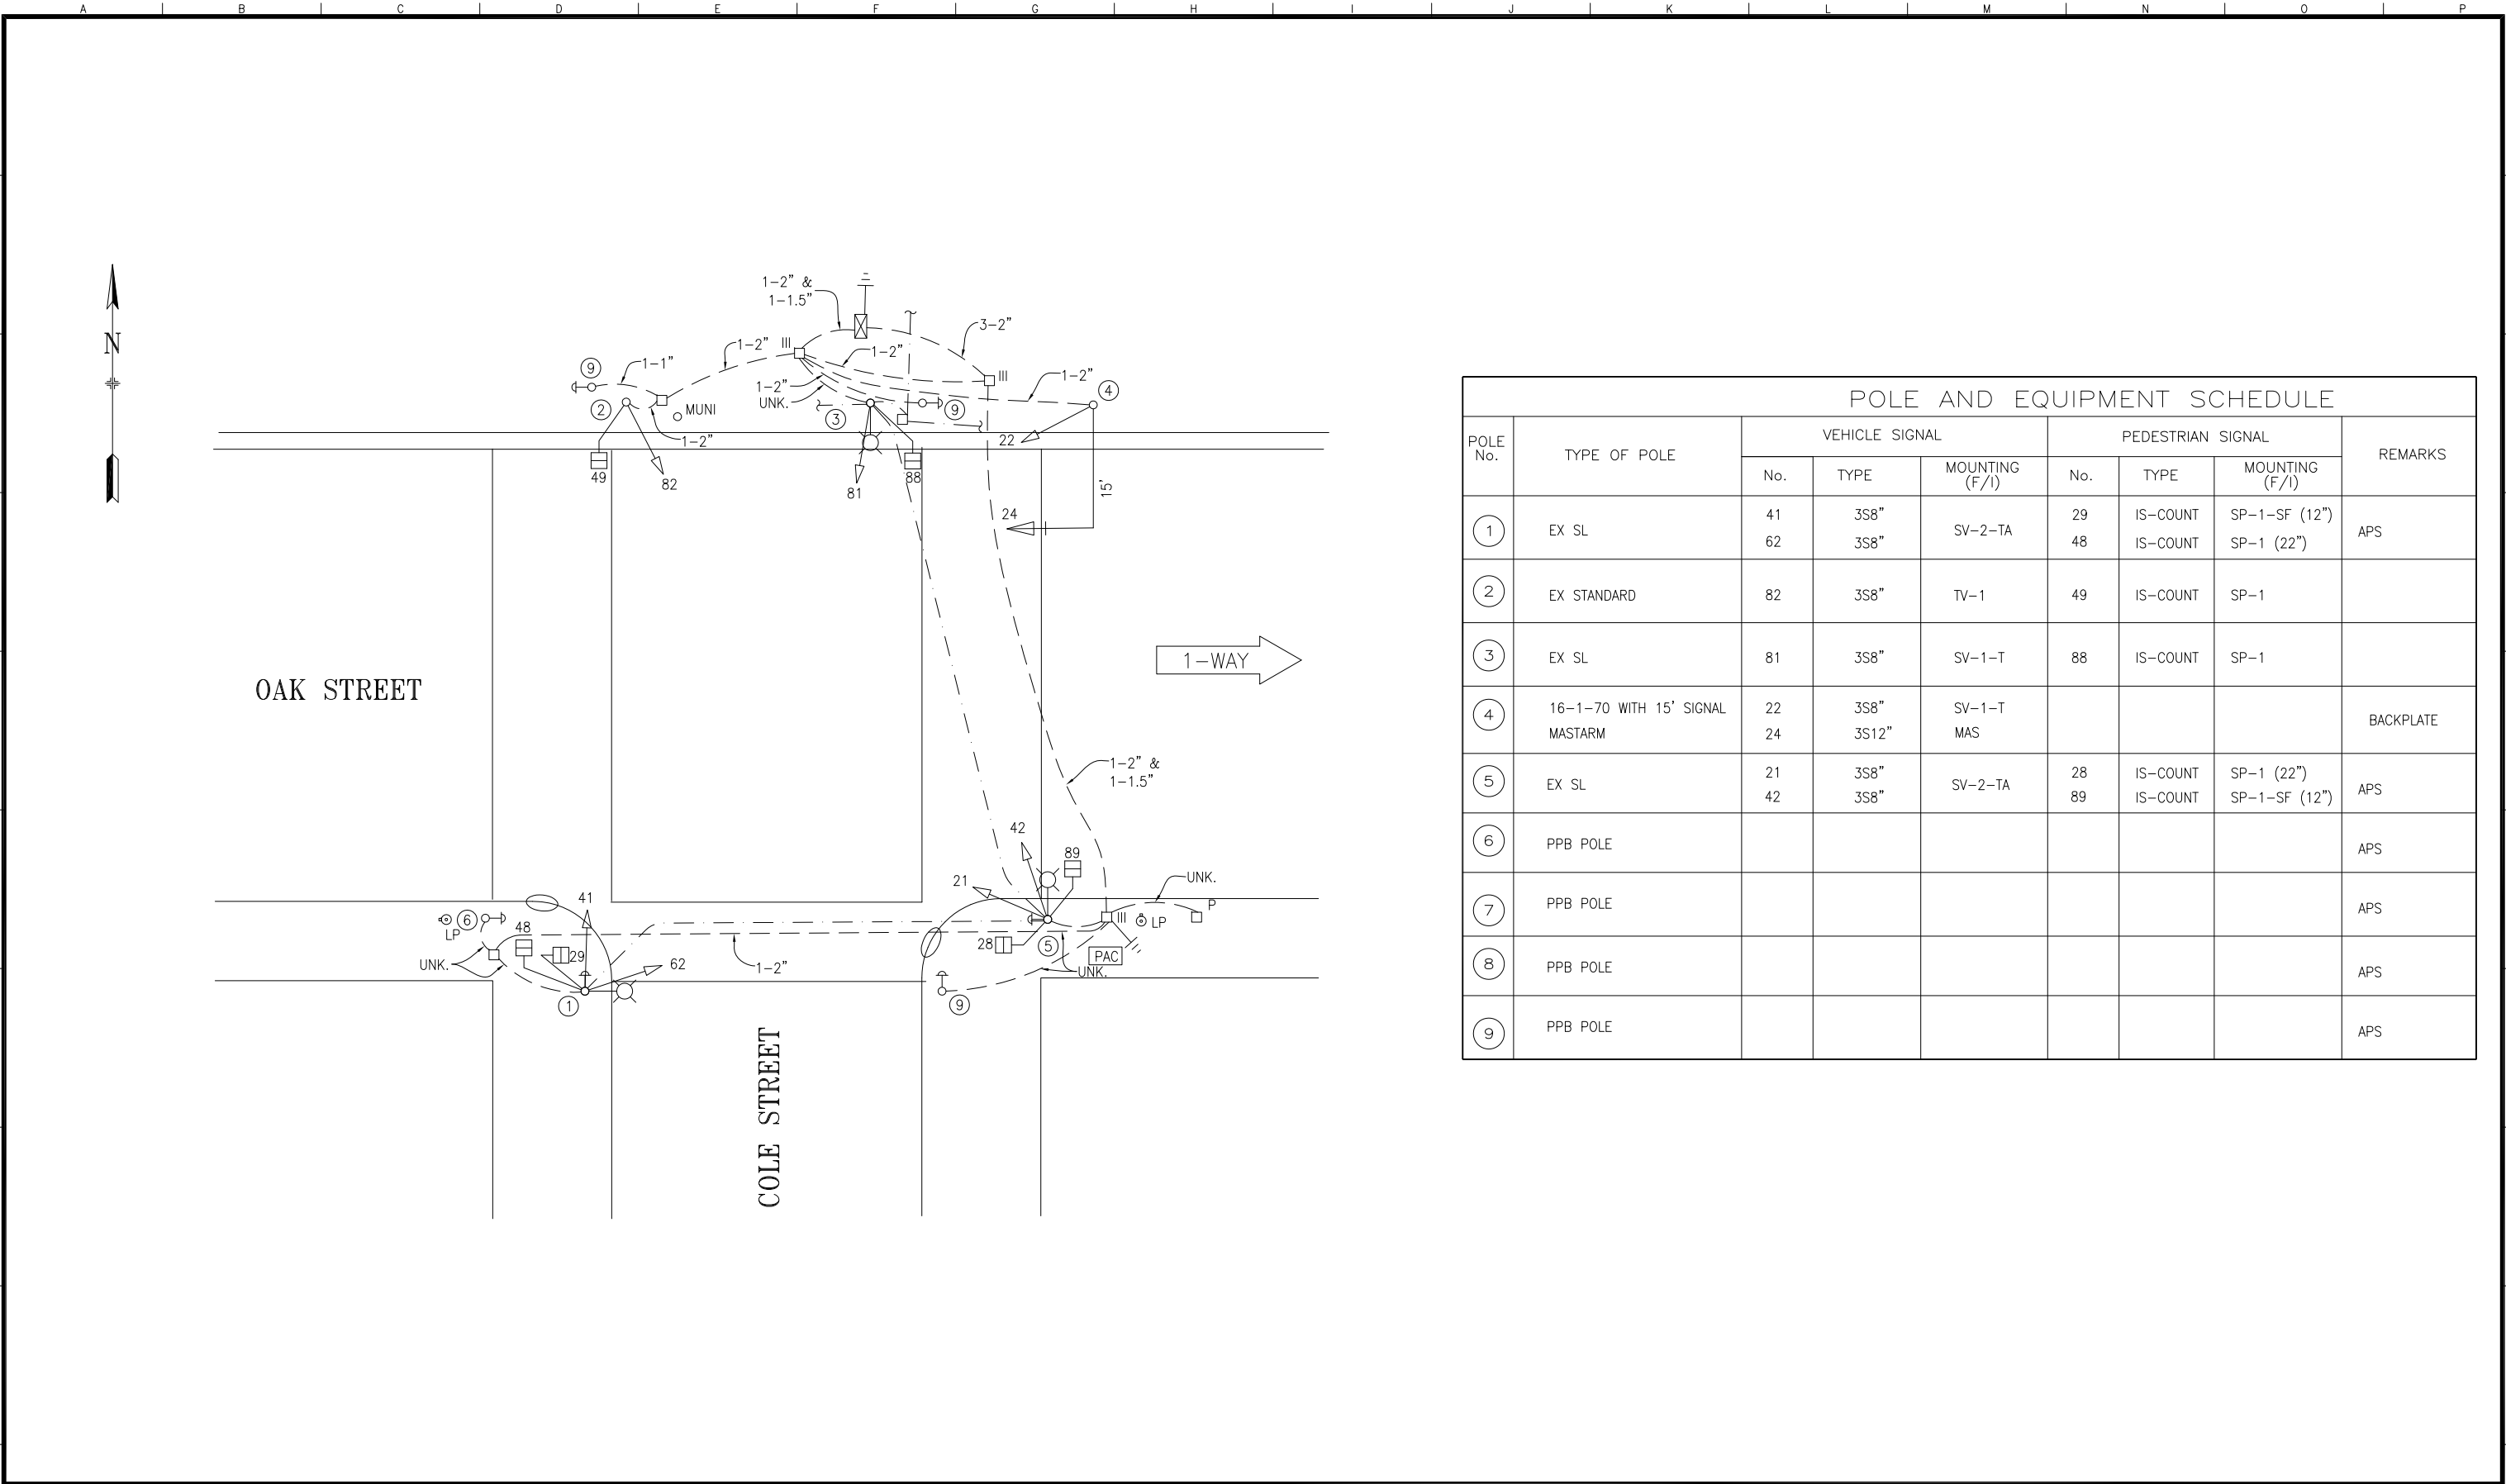

POLE AND EQUIPMENT SCHEDULE								
POLE No.	TYPE OF POLE	VEHICLE SIGNAL			PEDESTRIAN SIGNAL			REMARKS
		No.	TYPE	MOUNTING (F/I)	No.	TYPE	MOUNTING (F/I)	
①	EX SL	41	3S8"	SV-2-TA	29	IS-COUNT	SP-1-SF (12")	APS
		62	3S8"		48	IS-COUNT	SP-1 (22")	
②	EX STANDARD	82	3S8"	TV-1	49	IS-COUNT	SP-1	
③	EX SL	81	3S8"	SV-1-T	88	IS-COUNT	SP-1	
④	16-1-70 WITH 15' SIGNAL MASTARM	22	3S8"	SV-1-T				BACKPLATE
		24	3S12"	MAS				
⑤	EX SL	21	3S8"	SV-2-TA	28	IS-COUNT	SP-1 (22")	APS
		42	3S8"		89	IS-COUNT	SP-1-SF (12")	
⑥	PPB POLE							APS
⑦	PPB POLE							APS
⑧	PPB POLE							APS
⑨	PPB POLE							APS

NO.		DATE	DESCRIPTION	BY	APP.
3	5/8/15		ADDED POLES 7 & 8 BY SRC 2015-079	JH	MV
2	4/22/14		ADDED APS AND POLES 6 & 7 AS PER FIELD	JH	MV
1	8/9/06		PED. SIGNALS BY SRC 2005-271	GD	HQ
0	3/20/02		CONVERTED FROM 1660N AS-BUILT	JH	MV
TABLE OF REVISIONS					
CHECK WITH TRACING TO SEE IF YOU HAVE LATEST REVISION					

REFERENCE INFORMATION & FILE NO. OF SURVEYS
--



SAN FRANCISCO MUNICIPAL TRANSPORTATION AGENCY

CITY AND COUNTY OF SAN FRANCISCO

DRAWN:	DATE:
JH	3/2015
CHECKED:	DATE:
MV	3/2015

SCALE:
1" = 10 feet
SHEET OF SHEETS
1 OF 1

TRAFFIC SIGNAL INVENTORY DIAGRAM
COLE AND OAK STREETS

CNN NO.
26419000
REV NO.
3

FILE NAME: E-03-0.dwg
DATE: Feb 19 1998 10:31
ORIGIN: ELECTRICAL
SCALE FACTOR: 120
PLOT SCALE: 1"=1'
EXTERNAL REFERENCES: b34-22.dwg
FONTS USED: ROMANS.SHX ROMANS.SHX ROMANS.SHX ROMANT.txt