


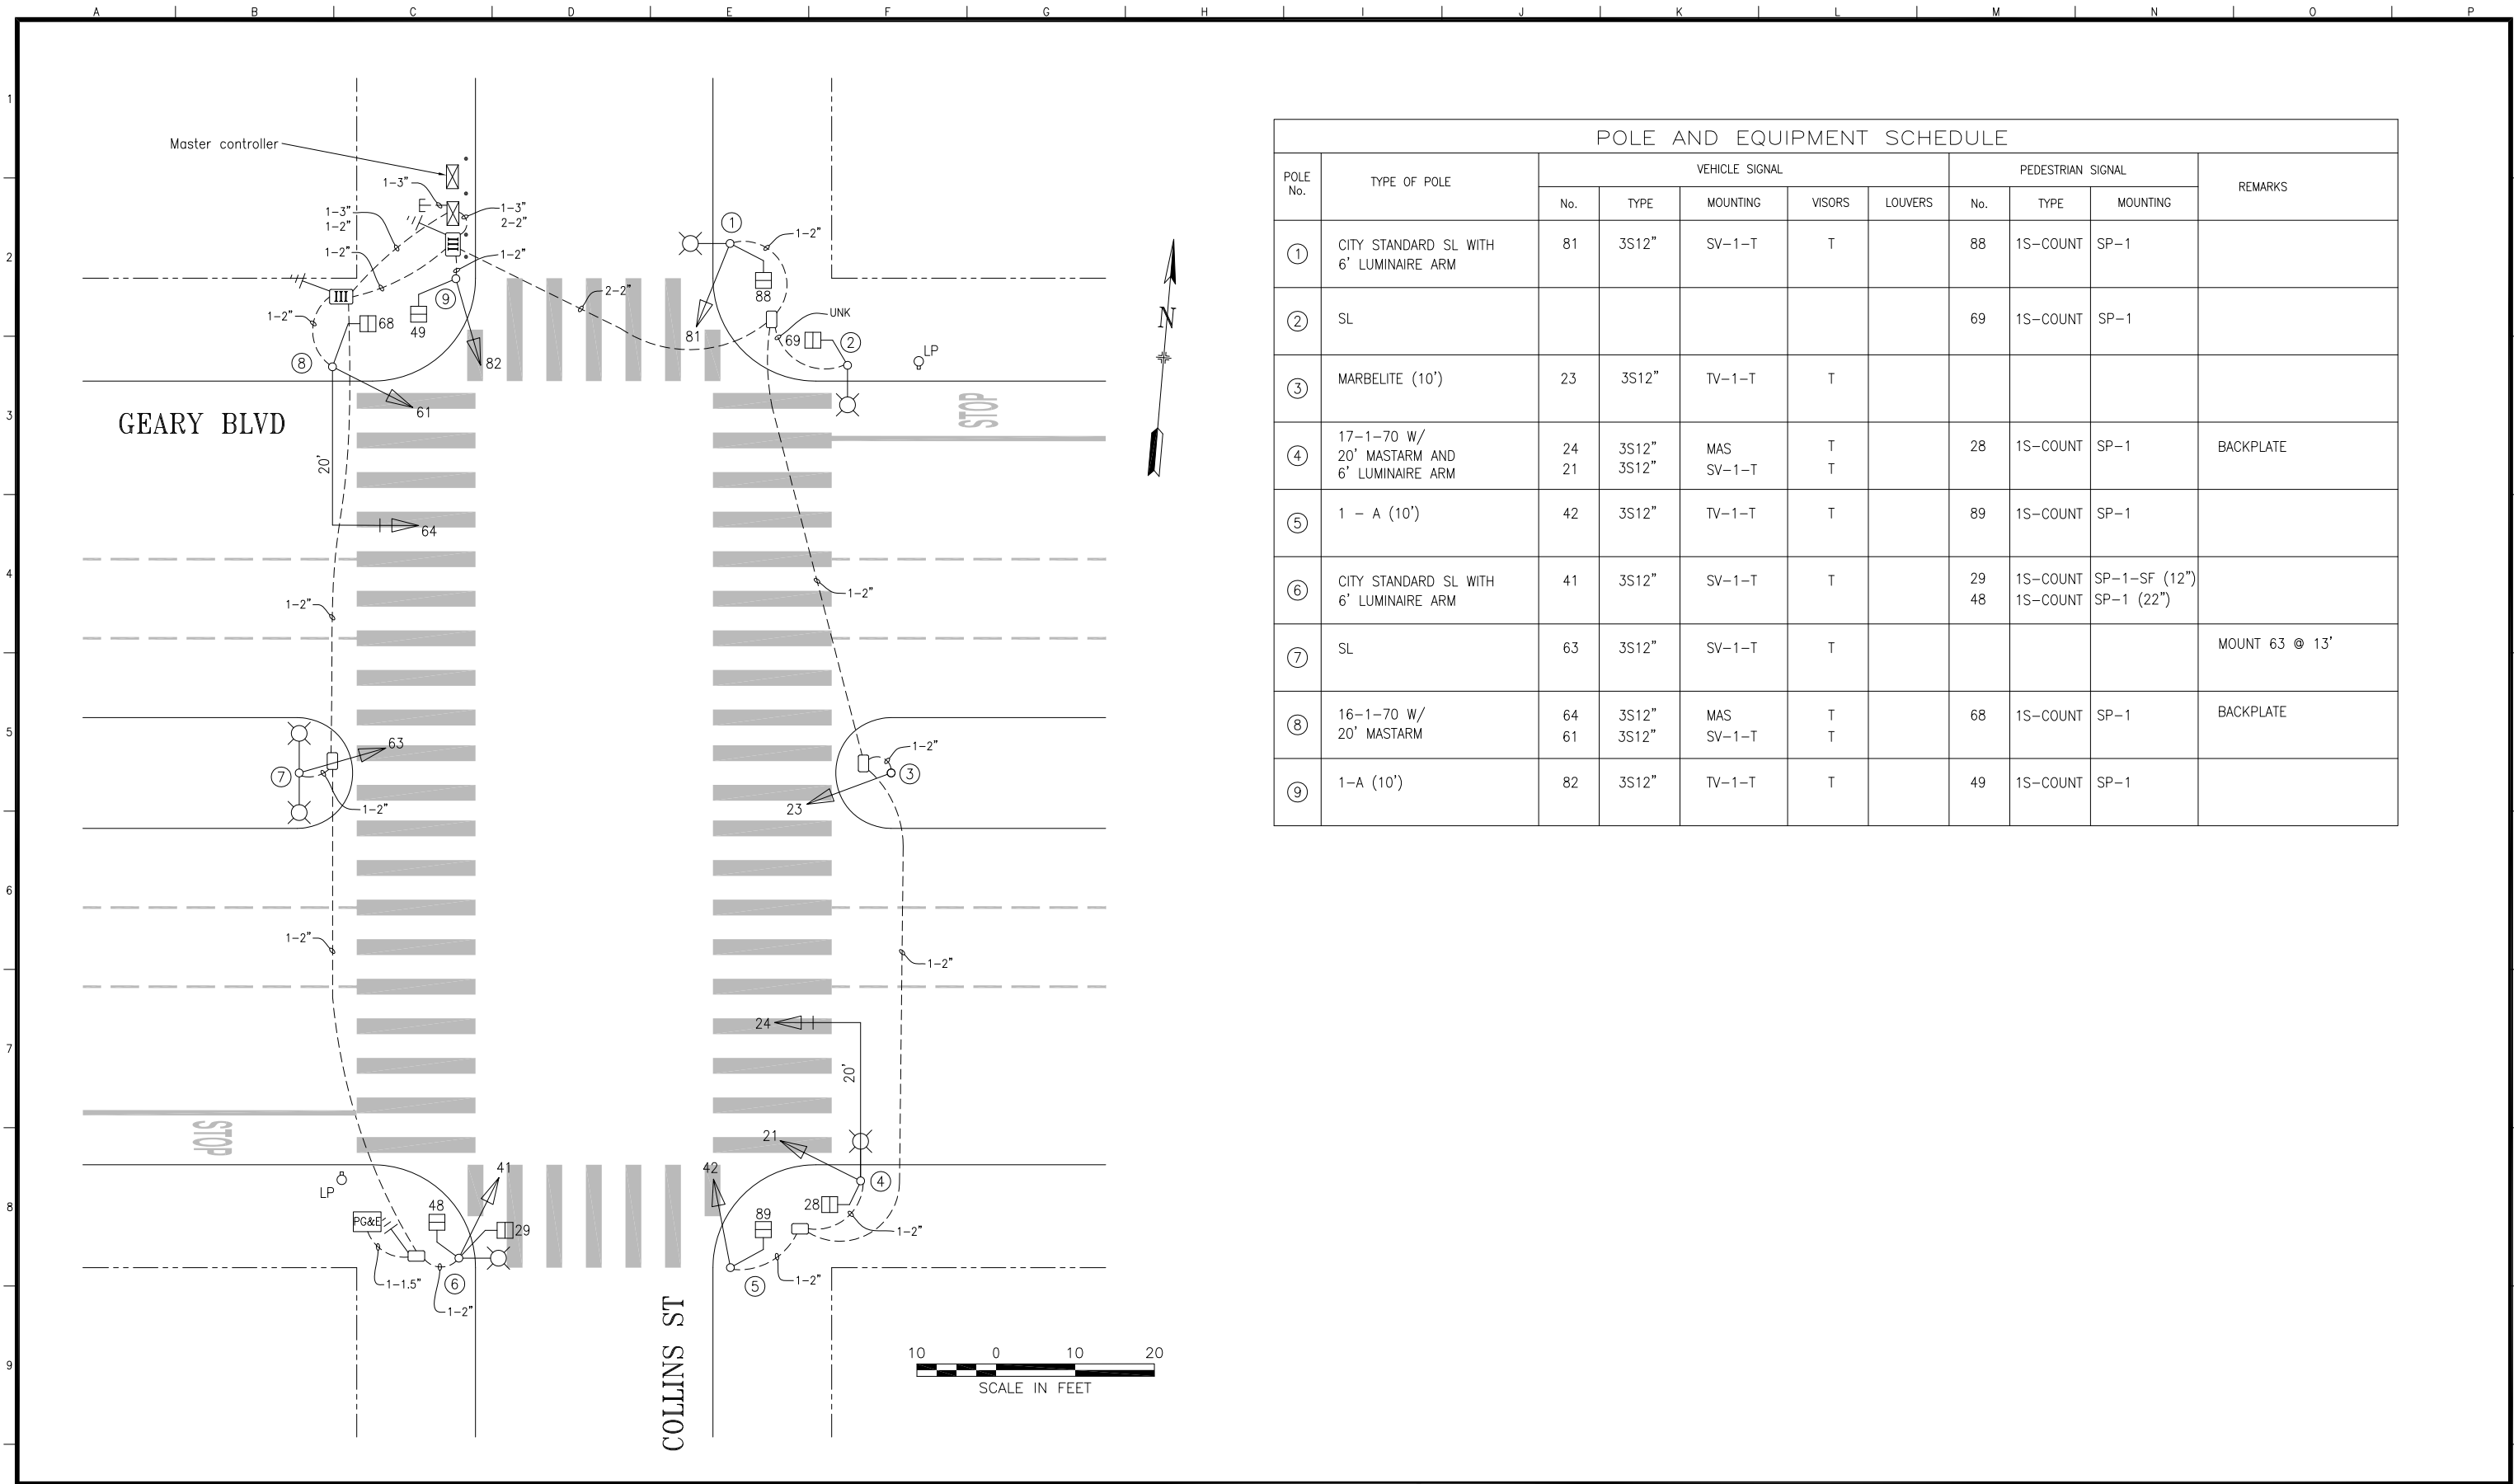

POLE AND EQUIPMENT SCHEDULE										
POLE No.	TYPE OF POLE	VEHICLE SIGNAL					PEDESTRIAN SIGNAL			REMARKS
		No.	TYPE	MOUNTING	VISORS	LOUVERS	No.	TYPE	MOUNTING	
①	CITY STANDARD SL WITH 6' LUMINAIRE ARM	81	3S12"	SV-1-T	T		88	1S-COUNT	SP-1	
②	SL						69	1S-COUNT	SP-1	
③	MARBELITE (10')	23	3S12"	TV-1-T	T					
④	17-1-70 W/ 20' MASTARM AND 6' LUMINAIRE ARM	24 21	3S12" 3S12"	MAS SV-1-T	T T		28	1S-COUNT	SP-1	BACKPLATE
⑤	1 - A (10')	42	3S12"	TV-1-T	T		89	1S-COUNT	SP-1	
⑥	CITY STANDARD SL WITH 6' LUMINAIRE ARM	41	3S12"	SV-1-T	T		29 48	1S-COUNT 1S-COUNT	SP-1-SF (12") SP-1 (22")	
⑦	SL	63	3S12"	SV-1-T	T					MOUNT 63 @ 13'
⑧	16-1-70 W/ 20' MASTARM	64 61	3S12" 3S12"	MAS SV-1-T	T T		68	1S-COUNT	SP-1	BACKPLATE
⑨	1-A (10')	82	3S12"	TV-1-T	T		49	1S-COUNT	SP-1	

1	10/26/17	UPDATE SIGNALS TO 12" PER SRC 2017-081		HYU	M.VELASCO
0	4/27/04	NEW SID CONVERTED FROM 2019N AS-BUILTS		HYU	M.VELASCO
NO.	DATE	DESCRIPTION		BY	APP.
TABLE OF REVISIONS					
CHECK WITH TRACING TO SEE IF YOU HAVE LATEST REVISION					

REFERENCE INFORMATION & FILE NO. OF SURVEYS



SAN FRANCISCO MUNICIPAL TRANSPORTATION AGENCY
CITY AND COUNTY OF SAN FRANCISCO

DRAWN:	DATE:
H.YU	3/2017
CHECKED:	DATE:
M.VELASCO	3/2017

SCALE:
AS SHOWN
SHEET OF SHEETS
1 OF 1

TRAFFIC SIGNAL INVENTORY DIAGRAM
COLLINS STREET AND GEARY BOULEVARD

CNN NO.
26908000
REV NO.
1