


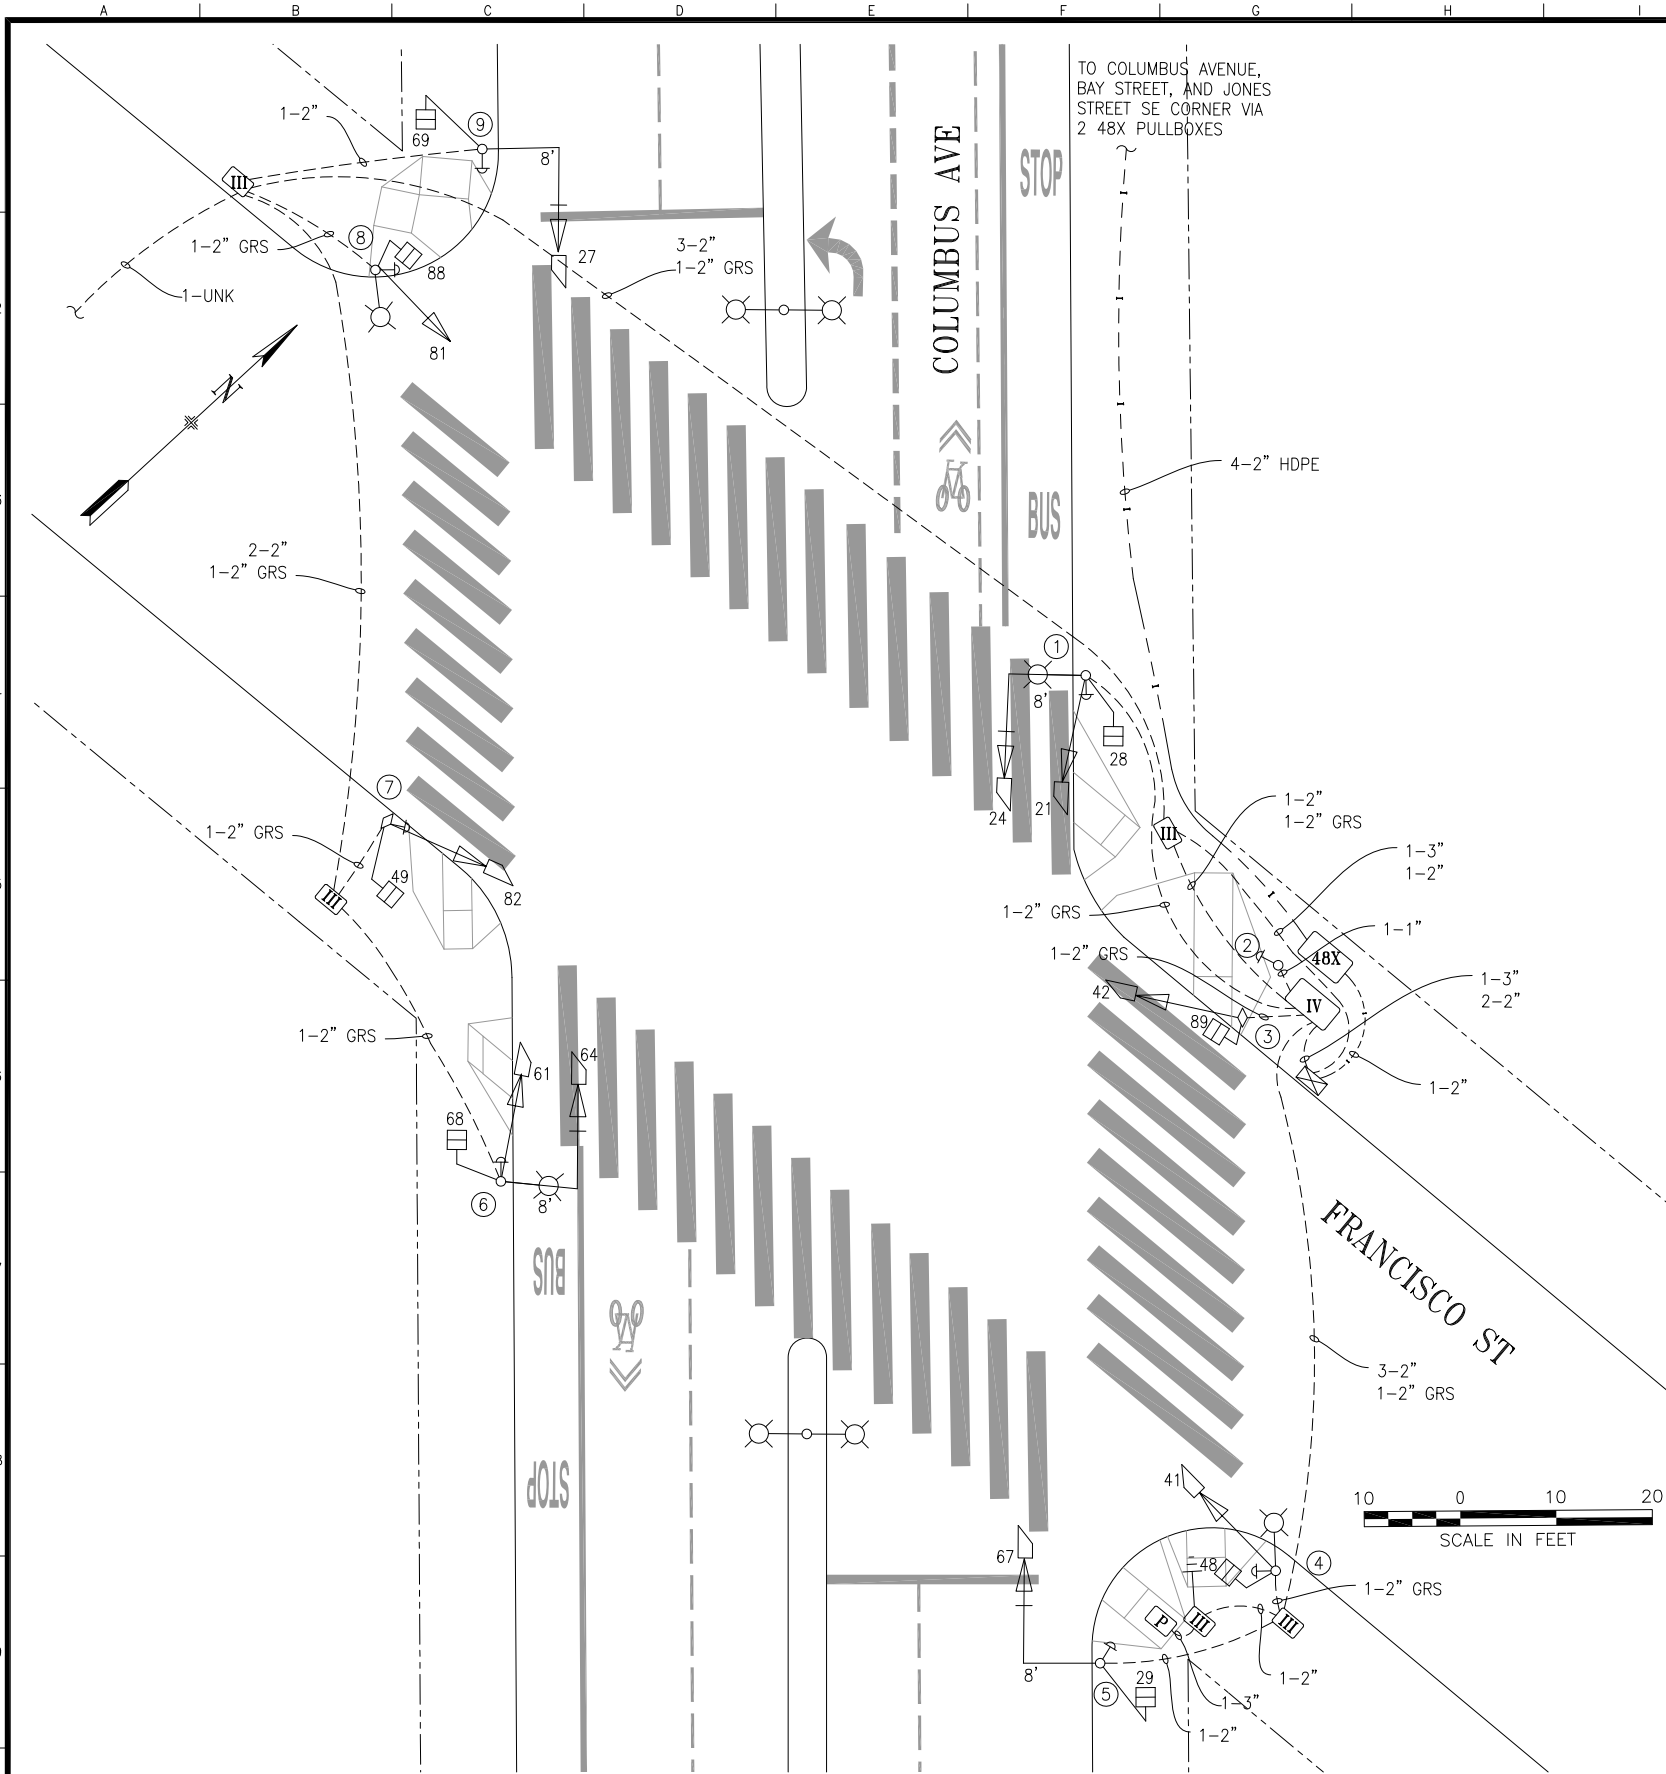


POLE AND EQUIPMENT SCHEDULE										
POLE No.	TYPE OF POLE	LUMINAIRE VOLTAGE/WATTAGE	VEHICLE SIGNAL				PEDESTRIAN SIGNAL			REMARKS
			No.	TYPE	MOUNTING	VISORS	No.	TYPE	MOUNTING	
①	17-2-100 WITH 8' MAST ARM W/ 6' LUMINAIRE ARM	LED 120V/54W	21 24	3S12" 3S12"	SV-1-T MAS ①	LA LA	28	1S-COUNT	SP-1	APS-2W BACKPLATE
②	PPB POLE									APS-2W
③	MUNI POLE		42	3S12"	SV-1-T	RA	89	1S-COUNT	SP-1-T	EXTERNAL CONDUIT
④	CITY STANDARD STREET LIGHT WITH 6' LUMINAIRE ARM	LED 120V/54W	41	3S12"	SV-1-T	RA	48	1S-COUNT	SP-1	APS-2W
⑤	16-2-100 WITH 8' MAST ARM		67	3S12"	MAS ①	LA	29	1S-COUNT	SP-1	BACKPLATE APS-2W
⑥	17-2-100 WITH 8' MAST ARM W/ 6' LUMINAIRE ARM	LED 120V/54W	61 64	3S12" 3S12"	SV-1 MAS ①	LA LA	68	1S-COUNT	SP-1	MOUNT 61 AT 15' APS-2W BACKPLATE
⑦	MUNI POLE		82	3S12"	SV-1-T	RA	49	1S-COUNT	SP-1	EXTERNAL LB CONDULET RISER APS-2W
⑧	SL W/ 6' LUMINAIRE ARM	LED 120V/54W	81	3S12"	SV-1-T	T	88	1S-COUNT	SP-1	MOUNT SIGNAL 81 AT 13' ON WEST SIDE OF POLE APS-2W
⑨	16-2-100 WITH 8' MAST ARM		27	3S12"	MAS ①	LA	69	1S-COUNT	SP-1	BACKPLATE APS-2W

SHEET NOTES:

① PLUMBIZER MOUNTED BETWEEN GREEN AND YELLOW

INTERCONNECT WIRING DETAIL
NOT TO SCALE

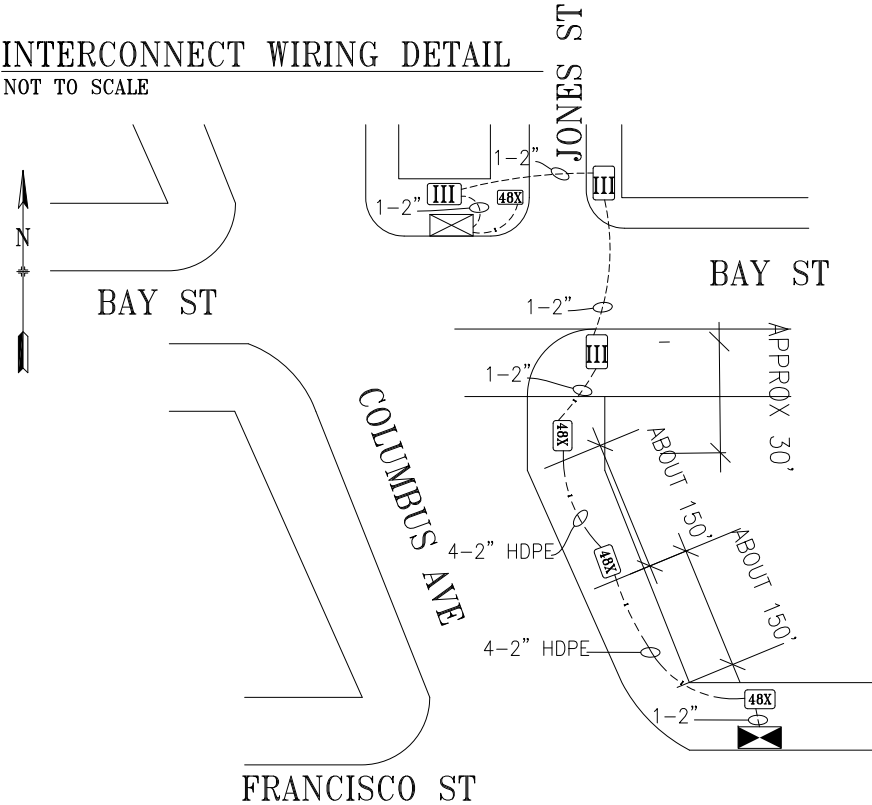

NO.		DATE	DESCRIPTION	BY	APP.
0		12/29/17	NEW SIGNAL ACTIVATED THROUGH #2772J	AScales	GDeLeon
TABLE OF REVISIONS CHECK WITH TRACING TO SEE IF YOU HAVE LATEST REVISION					

REFERENCE INFORMATION
& FILE NO. OF SURVEYS



SAN FRANCISCO MUNICIPAL TRANSPORTATION AGENCY
CITY AND COUNTY OF SAN FRANCISCO

DRAWN:	DATE:
AS	7/5/18
CHECKED:	DATE:
GD	8/3/18

SCALE:

AS SHOWN

SHEET OF SHEETS

1 OF 1

TRAFFIC SIGNAL INVENTORY DIAGRAM

COLUMBUS AVENUE AND FRANCISCO STREET

CNN NO.

25525000

REV NO.

0