


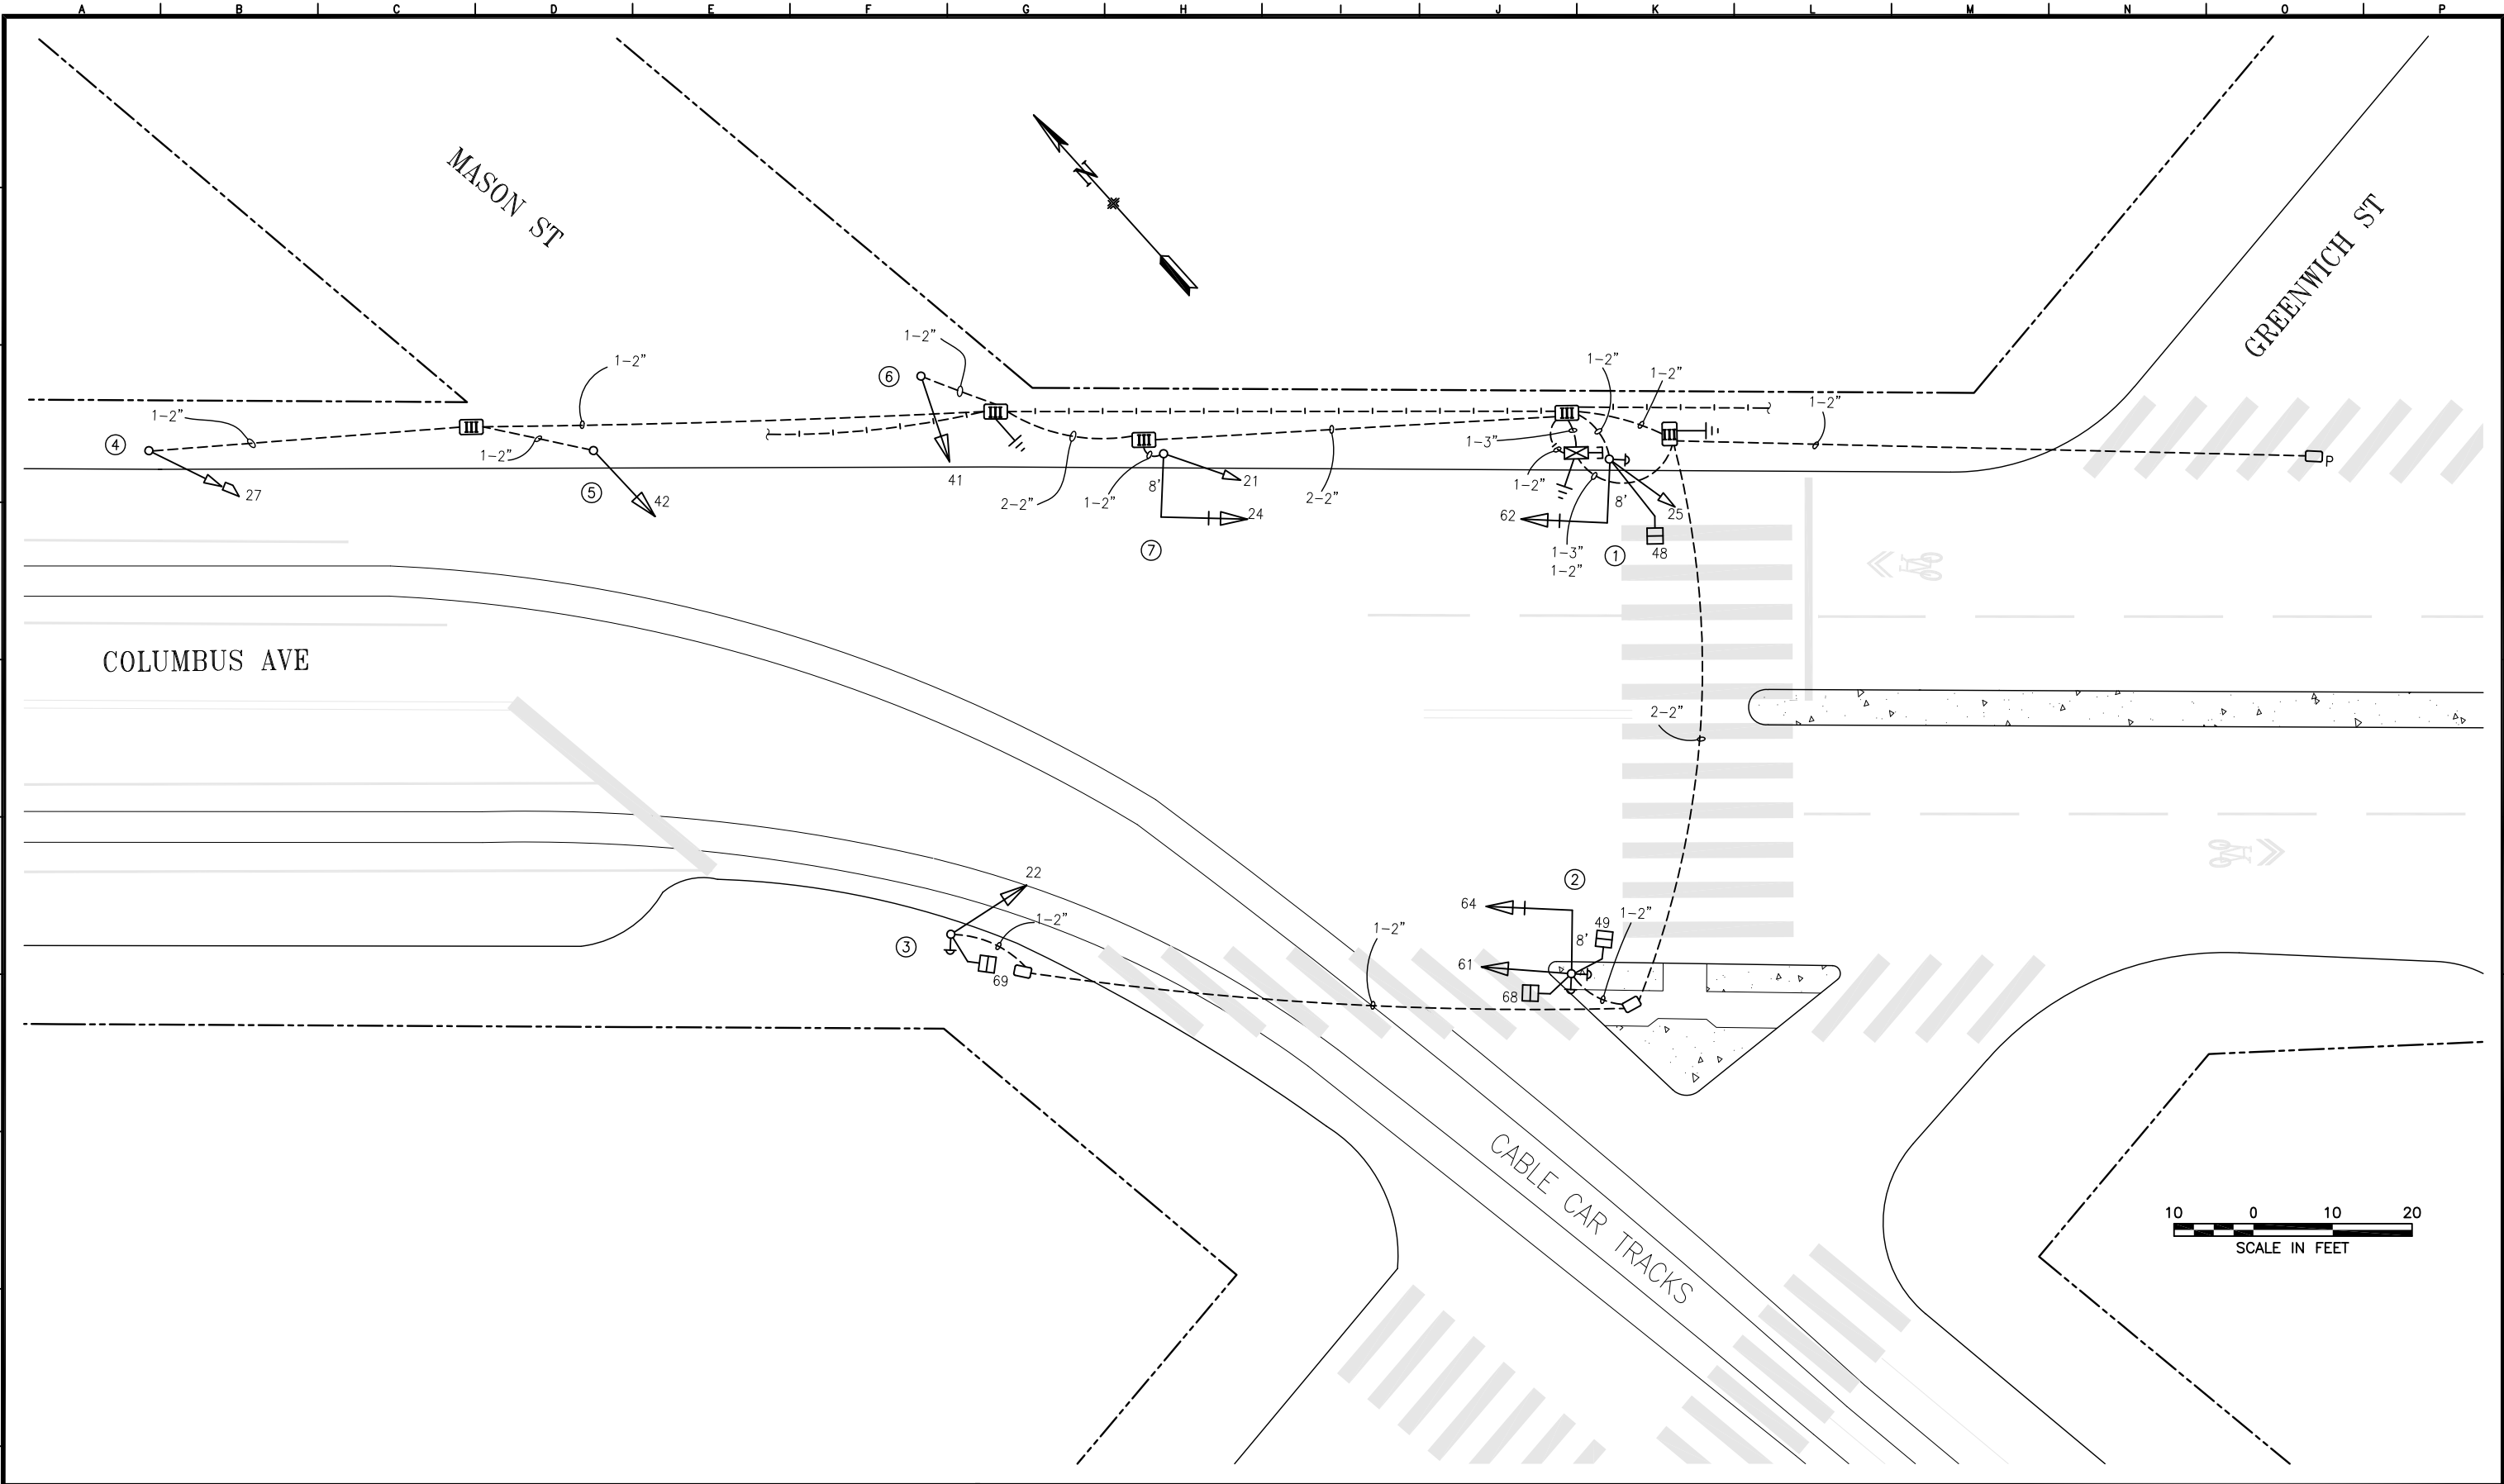

NO.	DATE	DESCRIPTION	BY	APPROVED
2	4/24/23	INSTALL APS (2023-027). PER FIELD; UPDATE SIGNALS ON POLE 2	ELuw	GdeLeon
1	06/19/14	REMOVE SIGNALS 81 & 82 & PED SIGNALS 28 & 29, RELOCATE POLE 6 PER SRC 2014-096	NWong	BBDisseault
0	10/21/04	SIGNAL UPGRADE ACTIVATED THROUGH 0481J; CONVERTED FROM 0481J AS-BUILTS	JHornbostel	GDeLeon

TABLE OF REVISIONS
CHECKOUT DRAWING THROUGH THE SID CUSTODIAN FOR THE LATEST REVISION



SFMTA

DRAWN BY:	DATE:
JHornbostel	06/14
CHECKED BY:	DATE:
GDeLeon	06/14

SCALE
AS SHOWN
SHEET OF SHEETS
1 OF 2

TRAFFIC SIGNAL INVENTORY DIAGRAM
COLUMBUS AVENUE, GREENWICH STREET AND MASON STREET

CNN NO:
25442000
REV NO:
2

