


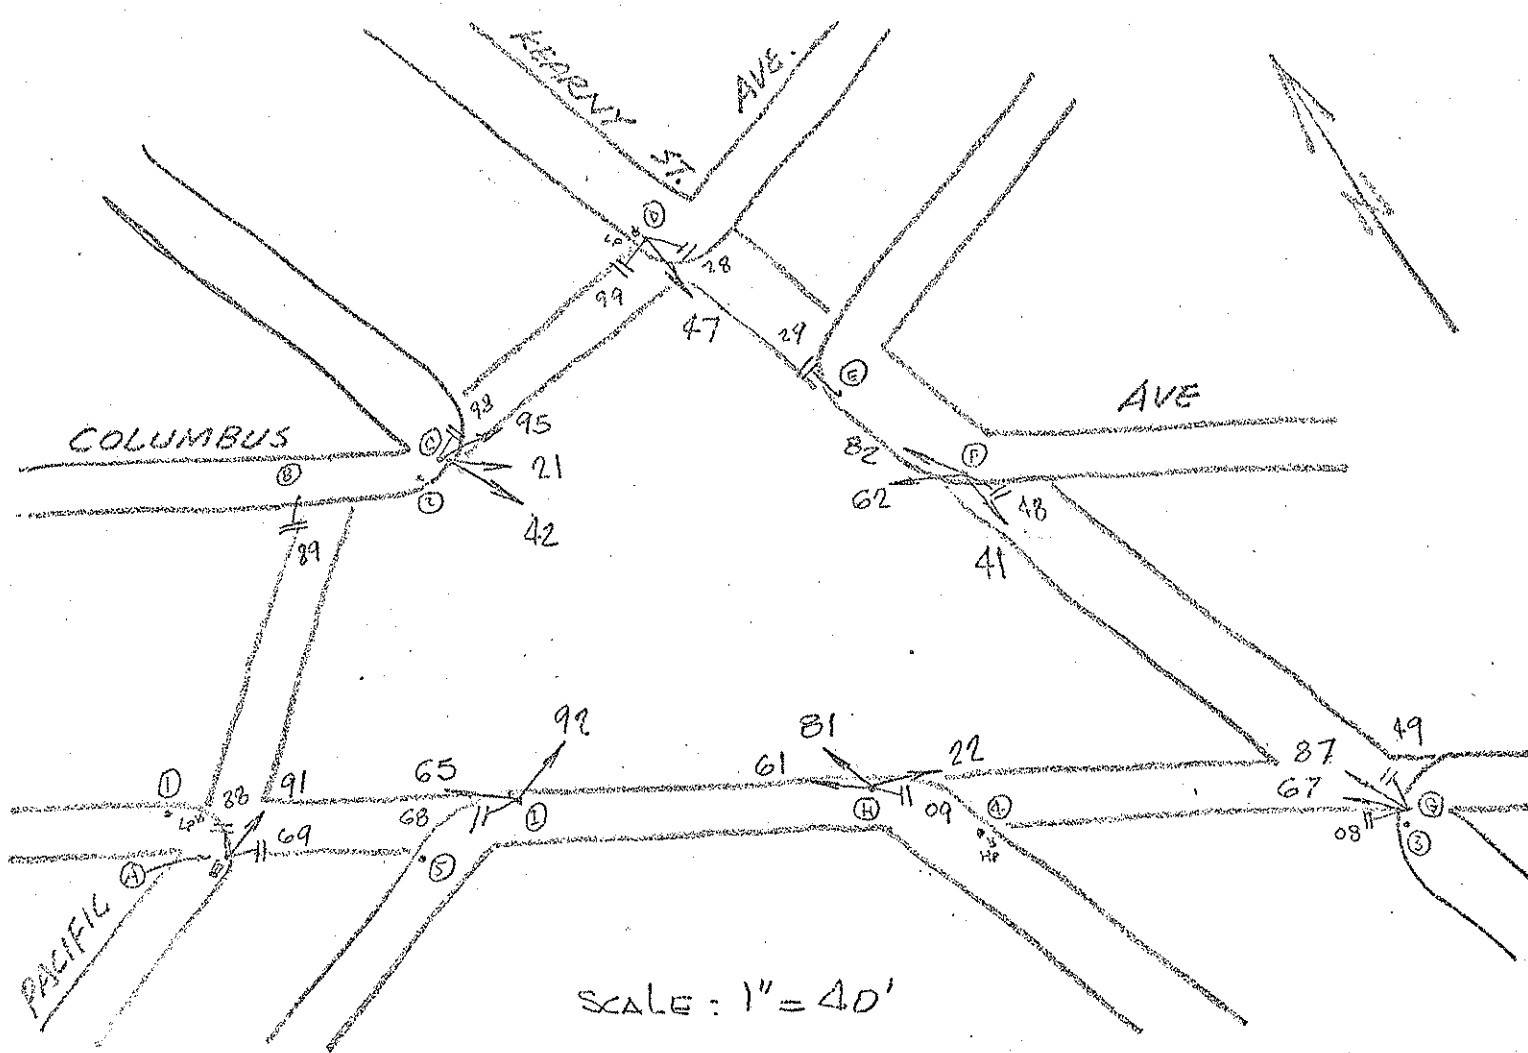

7-27-79

POLE	FUNC.	MAT'L	SIGNAL NO.	MAKE	NO. OF SECT.	SIZE	VISOR	B.P. or LOUVERS	MOUN'T	PED SIGNAL NO.	LEGEND	MESSAGE		MAKE	MOUN'T
												ELEMENT	COLOR		
A	S	S	91	EC	3	8"	FL 8"	No	T	69	W/DW	GRD	W/OR	ED	S
B	S	S	42	PV	3	12"	CAP	B.P.	S	88	W/DW	GRD	W/OR	ED	S
C	L	S	21	PV	3	12"	CAP	B.P.	S	89	W/DW	GRD	W/OR	ED	T
D	S	S	95	EC	3	8"	FL 8"	No	S	98	W/DW	GRD	W/OR	ED	S
E	S	S	47	GA	3	8"	FL 8"	No	T	99	W/DW	GRD	W/OR	ED	S
F	M	S	82	EC	3	8"	FL 8"	No	S	28	W/DW	GRD	W/OR	ED	S
G	S	S	62	EC	3	8"	FL 8"	No	S	29	W/DW	GRD	W/OR	ED	T
H	S	S	41	EC	3	8"	FL 8"	No	S	48	W/DW	GRD	W/OR	ED	S
I	L	S	87	PV	3	12"	CAP	No	T	49	W/DW	GRD	W/OR	ED	S
			67	PV	3	12"	CAP	No	T	08	W/DW	GRD	W/OR	ED	S
1	L	S	22	EA	3	8"	FL 8"	No	T	09	W/DW	GRD	W/OR	ED	S
2	L	S	81	EA	3	8"	FL 8"	G-Lovr.	T	68	W/DW	GRD	W/OR	ED	S
3	L	S	61	EA	3	8"	FL 8"	No	T						
4	L	S	92	EC	3	8"	FL 8"	No	S						
5	M	S	05	EC	3	8"	FL 8"	No	S						

CONTROLLER CABINET SIZE : ORDINARY BASE CABINET: YES

COMMENTS :