




NOTE:

CABINET FOUNDATION TYPE: STD

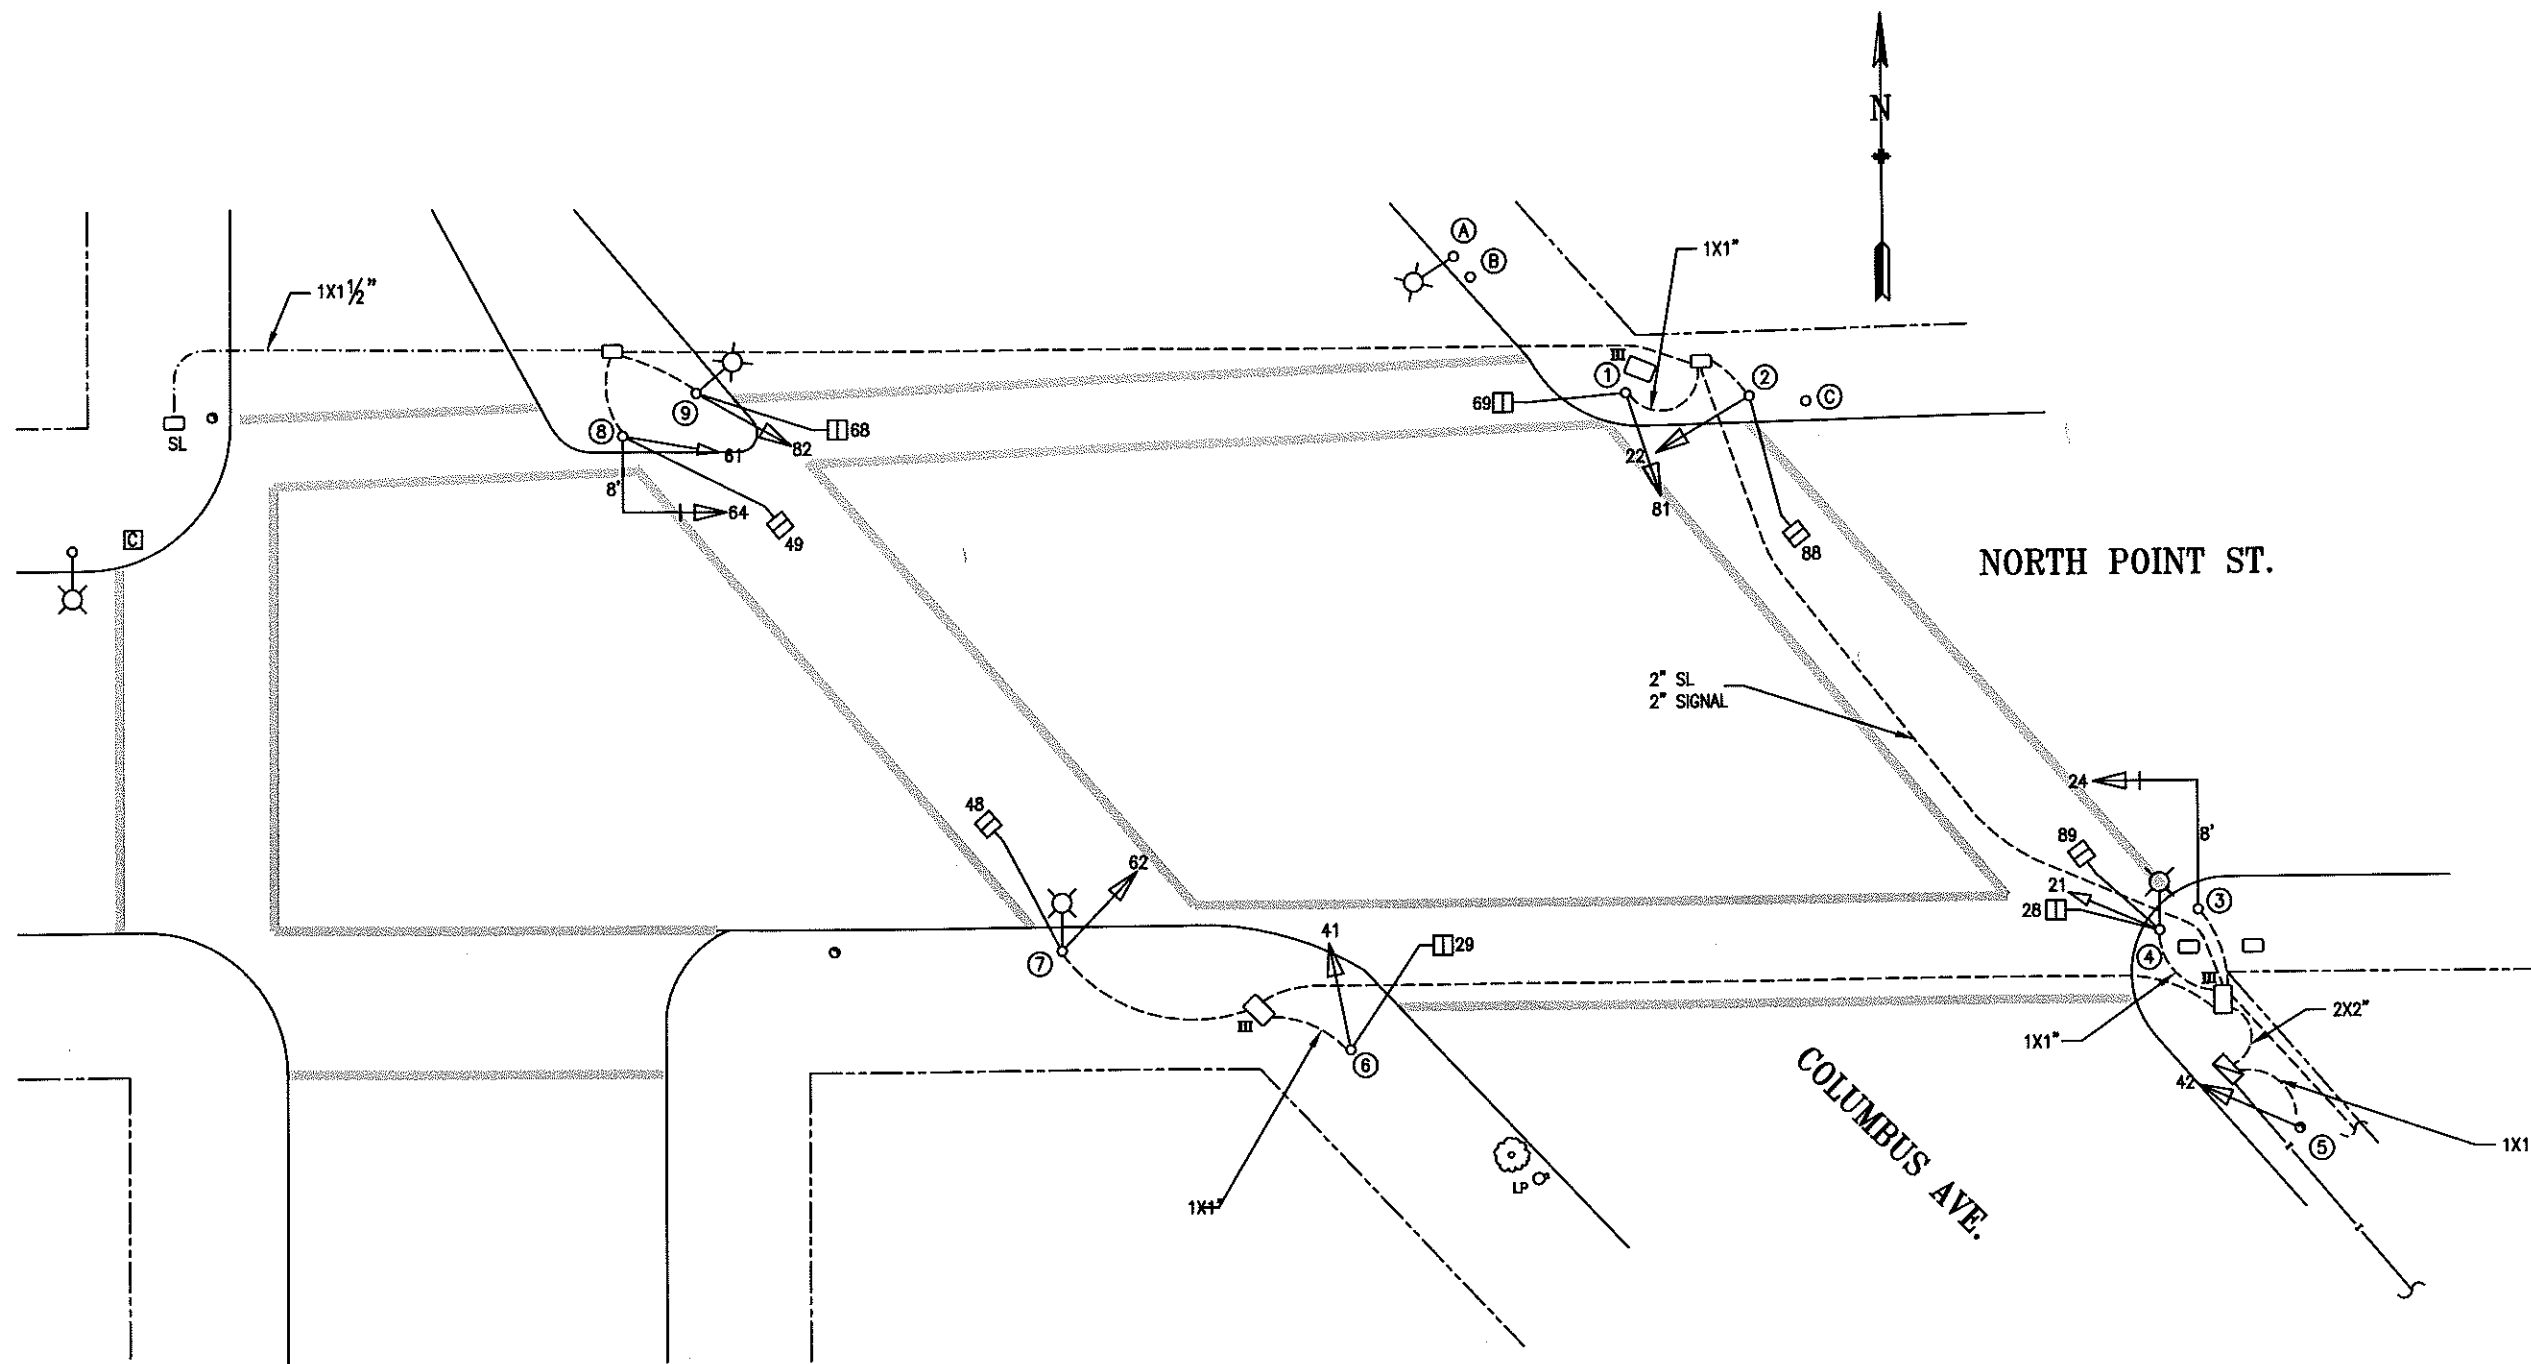

NO.	DATE	DESCRIPTION	BY	APP.
1	07/97	BAY AND NORTH POINT PROJECT JOB# 1094 N	DVC	RO
TABLE OF REVISIONS				
CHECK WITH TRACING TO SEE IF YOU HAVE LATEST REVISION				

COMPLETION DATE /
ELECTRICIAN INITIAL



DEPARTMENT OF PARKING AND TRAFFIC
DIVISION OF TRAFFIC ENGINEERING
CITY AND COUNTY OF SAN FRANCISCO

DRAWN:	DATE:	SCALE:
DVC	8/29/01	1" = 20'
CHECKED:	DATE:	SHEET OF SHEETS
20	9/10/01	1 OF 2

TRAFFIC SIGNAL INVENTORY DIAGRAM

COLUMBUS AVE & NORTH POINT ST

CNN NO.
25573000
REV. NO.
1

EXTERNAL REFERENCES: 1111 E. Files Special Projects & Street Use SID/Vehicle/1034422.dwg
FONTS USED: ROMANS.SHX romans ROMANS.SHX ROMANS.SHX romans.ahx
SCALE FACTOR: 240
PLOT SCALE: 1=1
ORIGIN: Sales & Tax
FILE NAME: Columbus-North Point.dwg
DATE: Aug 30 2001 10:51

POLE AND EQUIPMENT SCHEDULE										
POLE No.	TYPE OF POLE	VEHICLE SIGNAL					PEDESTRIAN SIGNAL			REMARKS
		No.	TYPE	MOUNTING	VISORS	LOUVERS	No.	TYPE	MOUNTING	
①	1-A (10')	81	3S12"	TV-1-T	T		69	1S-IN	SP-1	
②	1-A (10')	22	3S12"	TV-1-T	T		88	1S-IN	SP-1	
③	16-1-70 W/8' MAST ARM	24	3S12"	MAS	T					BP
④	SL	21	3S8"	SV-1-T	T	3L	28 89	1S-IN 1S-IN	SP-2-SF	
⑤	Utility	42	3S12"	SV-1-T	T	5L				EXTERNAL CONDUIT
⑥	MUNI	41	3S12"	SV-1-T	T		29	1S-IN	SP-1	
⑦	SL	62	3S12"	SV-1-T	T		48	1S-IN	SP-1	
⑧	16-1-70 W/8' MAST ARM	64 61	3S12" 3S8"	MAS SV-1-T	T T	3L	49	1S-IN	SP-1-SF	BP
⑨	SL	82	3S12"	SV-1-T	T	5L	68	1S-IN	SP-1-SF	
Ⓐ	MUNI/SL									
Ⓑ	WP									
Ⓒ	MUNI									

1 07/97 BAY AND NORTH POINT PROJECT JOB# 1094 N NO. DATE DESCRIPTION		DVC: RO BY APP.	 DEPARTMENT OF PARKING AND TRAFFIC DIVISION OF TRAFFIC ENGINEERING CITY AND COUNTY OF SAN FRANCISCO	DRAWN: DVC DATE: 8/29/01 SCALE: 1" = 20' CHECKED: 1/0 9/10/01 DATE: SHEET OF SHEETS 2 OF 2	TRAFFIC SIGNAL INVENTORY DIAGRAM COLUMBUS AVE & NORTH POINT ST	CMM NO. 25573000 REV. NO. 1
TABLE OF REVISIONS CHECK WITH TRACING TO SEE IF YOU HAVE LATEST REVISION				COMPLETION DATE / ELECTRICIAN INITIAL		

EXTERNAL REFERENCES: T:\T_E_Files\Special Projects & Street Use\SD\Archived\103422.dwg
 FONTS USED: c:\winnt\fonts\ARIEL.TTF Hyperp.dwg ROMANS.SHA ROMANS.SHA ROMANT.bt
 SCALE FACTOR: 120
 PLOT SCALE: 1"=1'
 ORIGIN: Sales & Tax
 FILE NAME: T_PROTOD.dwg
 DATE: Aug 30 2001 10:57