

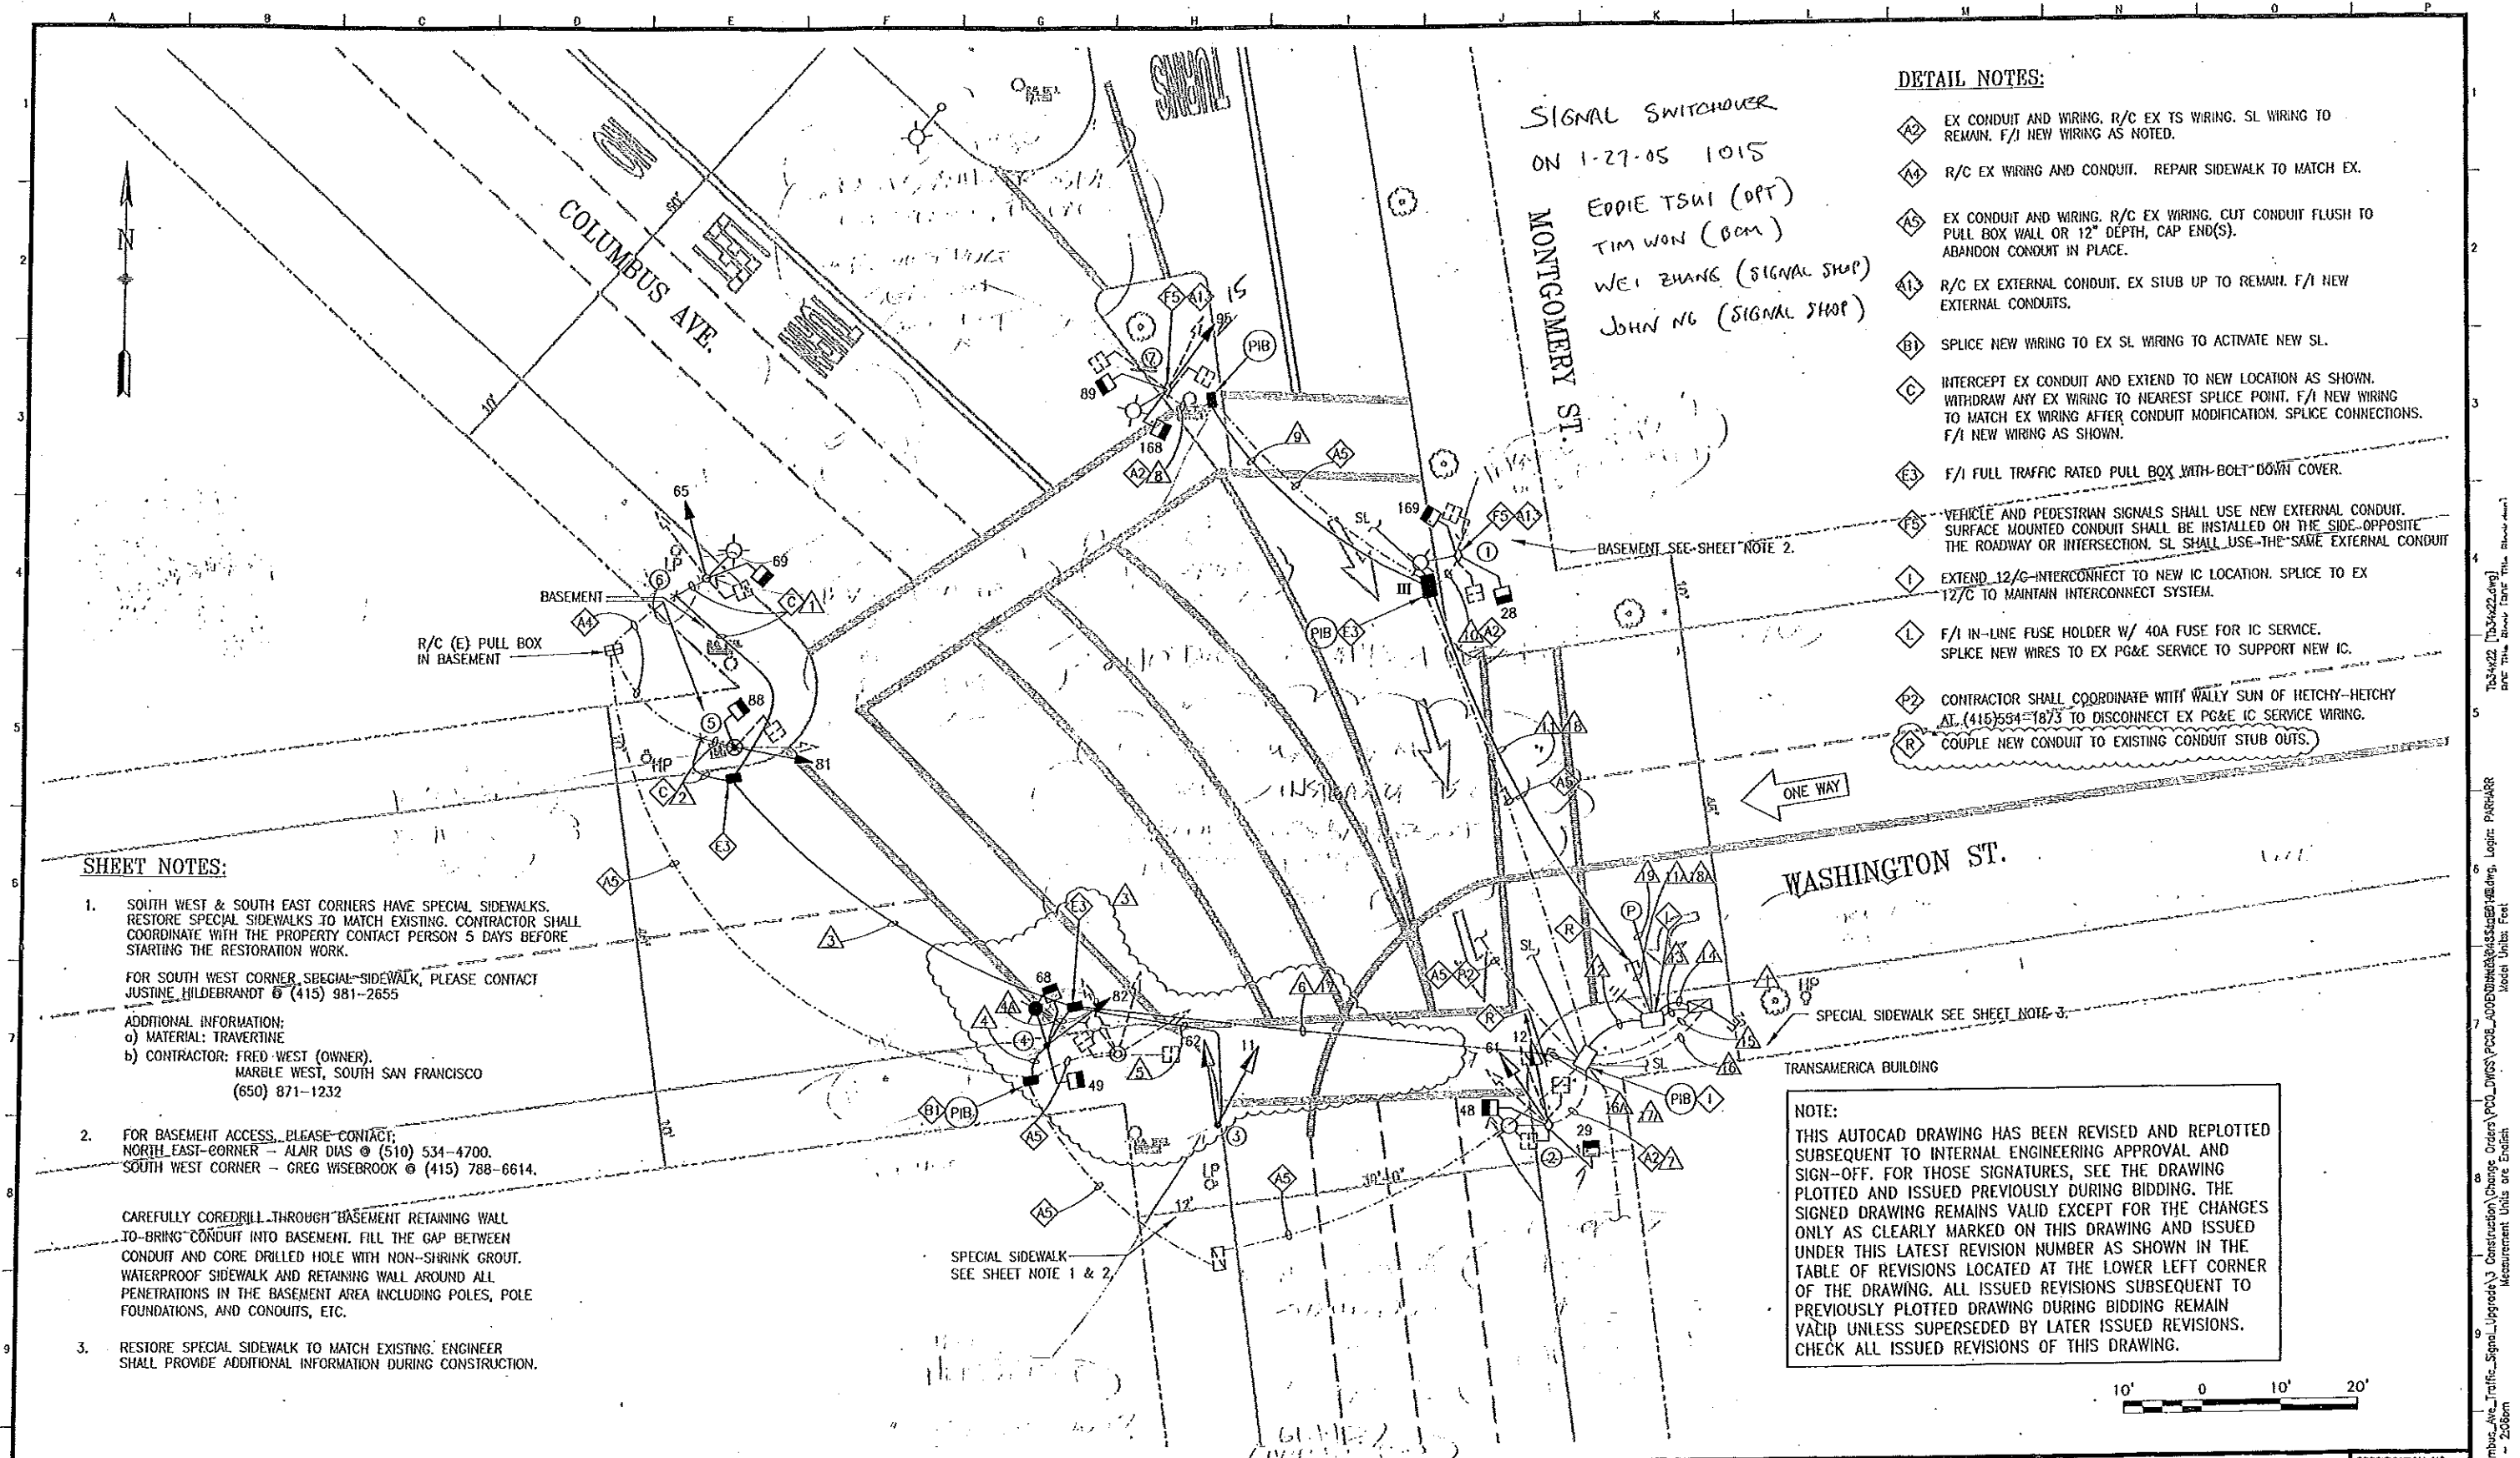


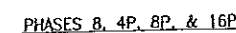

					REFERENCE INFORMATION & FILE NO. OF SURVEYS			BUREAU OF ENGINEERING DEPARTMENT OF PUBLIC WORKS CITY AND COUNTY OF SAN FRANCISCO		DESIGNED: DATE: 9/02 RP	APPROVED: DATE: 9/02	SCALE: 1" = 10 feet SHEET OF SHEETS	COLUMBUS AVENUE TRAFFIC SIGNAL UPGRADE	SPECIFICATION NO. 0481J
Δ	09/04	PCO#9 REROUTE CONDUIT AND WIRING @ SW CORNER	RP	BC	DRAWING NO. E-1.0									
Δ	02/04	PCO#4 MOVE POLE #3	RP	BC	FILE NO. 80.009									
Δ	12/03	PCO#2 (E) PB, NSF FOUNDATION & CONDUITS	RP	BC	REV. NO. 3									
0	9/02	ISSUED FOR BID	RP	BC										
NO.	DATE	DESCRIPTION	BY	APP.										
TABLE OF REVISIONS CHECK WITH TRACING TO SEE IF YOU HAVE LATEST REVISION														


 F/I WITH INTEGRAL BALLAST AND PHOTOELECTRIC CONTROL. F/I FUSE
 AND FUSE HOLDERS PER SPDPWSF FILE #49,092.

PHASE DIAGRAM:

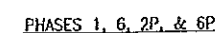

G	Y	R			COLUMBUS (#6)	
G	Y	R			MONTGOMERY (#1)	
R		G		Y	R	WASHINGTON ST (#8)
WM	FRH	RH			PED XING WASHINGTON (W/S) (#6P)	
WM	FRH	RH			PED XING WASHINGTON (E/S) (#2P)	
RH		WM	FRH	RH	PED XING COLUMBUS (#8P)	
RH		WM	FRH	RH	PED XING MONTGOMERY (S/S) (#4P)	
RH		WM	FRH	RH	PED XING MONTGOMERY (N/S) (#16P)	

REFERENCE INFORMATION
& FILE NO. OF SURVEYS

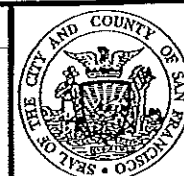

BUREAU OF ENGINEERING
DEPARTMENT OF PUBLIC WORKS
CITY AND COUNTY OF SAN FRANCISCO



DESIGNED: DATE:	APPROVED	
RP 9/02	SECTION MANAGER	DATE
DRAWN: DATE:	DIVISION MANAGER	DATE
JS 9/02	CITY ENGINEER	DATE
CHECKED: DATE:		
BC 9/02		

SCALE:
NONE
SHEET OF SHEETS

COLUMBUS AVENUE TRAFFIC SIGNAL UPGRADE

COLUMBUS AVE., MONTGOMERY ST., AND
WASHINGTON ST.
SCHEDULE

SPECIFICATION NO.	0481J
DRAWING NO.	E-1.1
FILE NO.	80,010
REV. NO.	1