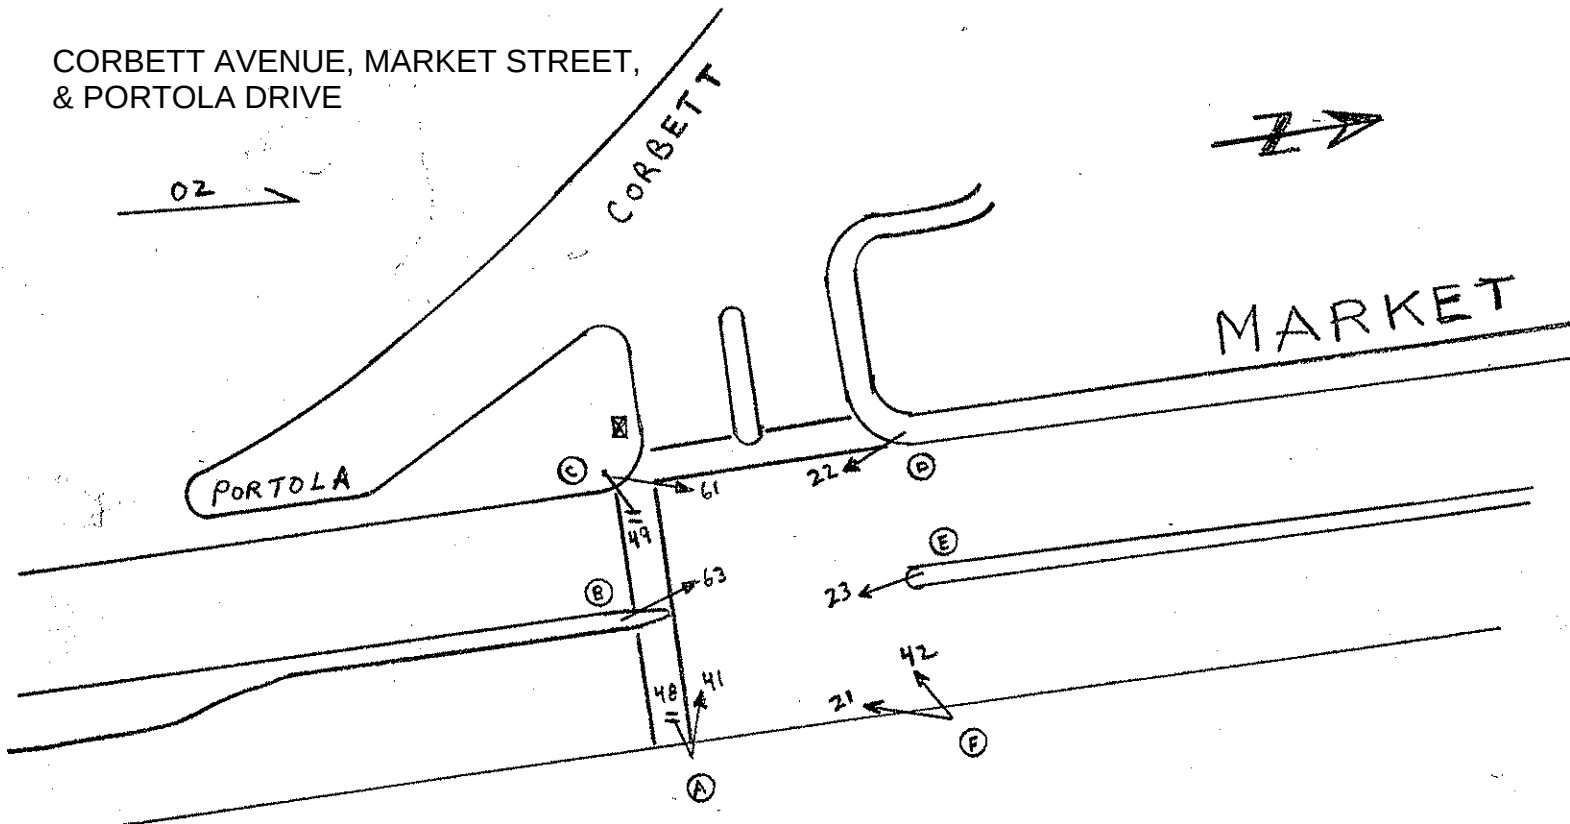


02

[illegible]

COMMENTS : Signals to 3S12": 21, 22, 42, 63
(Per field: 41, 61 to 3S12")
- E. Luu (SRC 2020-207)