


# MISSION + CORTLAND

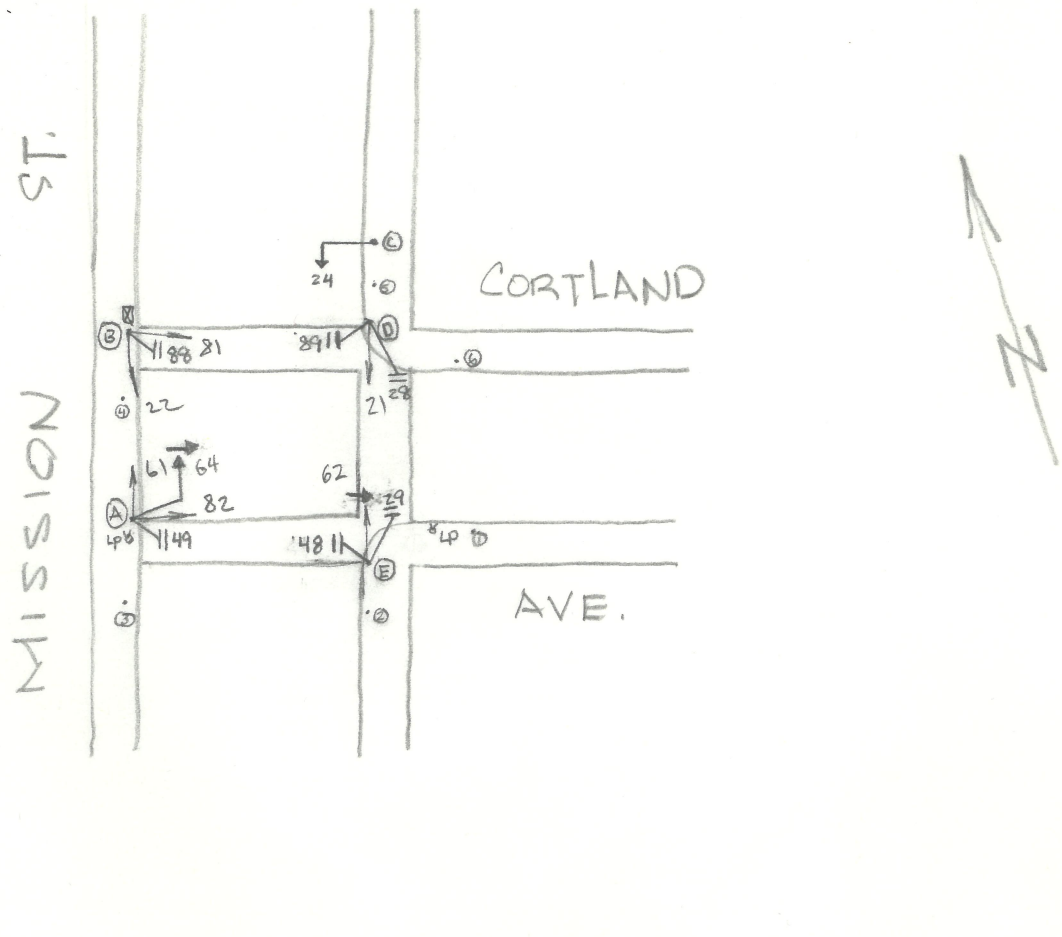

Signal Upgrade Switchover 3/21/00; 12/12/18 Rev.

| POLE | FUNC. | MAT'L | SIGNAL NO. | MAKE | NO. OF SECT. | SIZE    | VISOR | B.P. OR LOUVERS | MOUN'T | PED SIGNAL NO. | LEGEND | MESSAGE |      | MAKE | MOUN'T |
|------|-------|-------|------------|------|--------------|---------|-------|-----------------|--------|----------------|--------|---------|------|------|--------|
| A    | L     | S     | 82         | CH   | 3            | 8"      | T 8"  | No              | S      | 48             | I      | IS-I    | w/OR | ICC  | S      |
| B    | S     | S     | 61         | CH   | 3            | 8"      | T 8"  | No              | S      | 49             | I      | IS-I    | w/OR | ICC  | S      |
| C    | S     | S     | 64         | CH   | 4            | 12" GLA | T 12" | BP              | MAS    | 88             | I      | IS-I    | w/OR | ICC  | S      |
| D    | S     | S     | 22         | CH   | 3            | 8"      | T 8"  | No              | T      | 89             | I      | IS-I    | w/OR | ICC  | S      |
| E    | S     | S     | 81         | CH   | 3            | 8"      | T 8"  | No              | T      | 28             | I      | IS-I    | w/OR | ICC  | S      |
|      |       |       | 24         | CH   | 3            | 12"     | T 12" | BP              | MAS    | 29             | I      | IS-I    | w/OR | ICC  | S      |
|      |       |       | 21         | CH   | 3            | 8"      | T 8"  | No              | T      |                |        |         |      |      |        |
| 1    | M     | S     | 62         | CH   | 4            | 12" GLA | T 12" | No              | S      |                |        |         |      |      |        |
| 2    | L/M   | S     |            |      |              |         |       |                 |        |                |        |         |      |      |        |
| 3    | M     | S     |            |      |              |         |       |                 |        |                |        |         |      |      |        |
| 4    | M     | S     |            |      |              |         |       |                 |        |                |        |         |      |      |        |
| 5    | L/M   | S     |            |      |              |         |       |                 |        |                |        |         |      |      |        |
| 6    | L/M   | S     |            |      |              |         |       |                 |        |                |        |         |      |      |        |

CONTROLLER CABINET SIZE : Ordinary BASE CABINET: Yes

COMMENTS : REPLACED SIGNALS 62 & 64 WITH 4-SECTION WITH LEFT TURN ARROW. 62 UPGRADED FROM 8" TO 12". - A. LAM REPLACED 10' POLE E WITH 15' POLE. REV. PER SRC 2018-476. 11/27/18