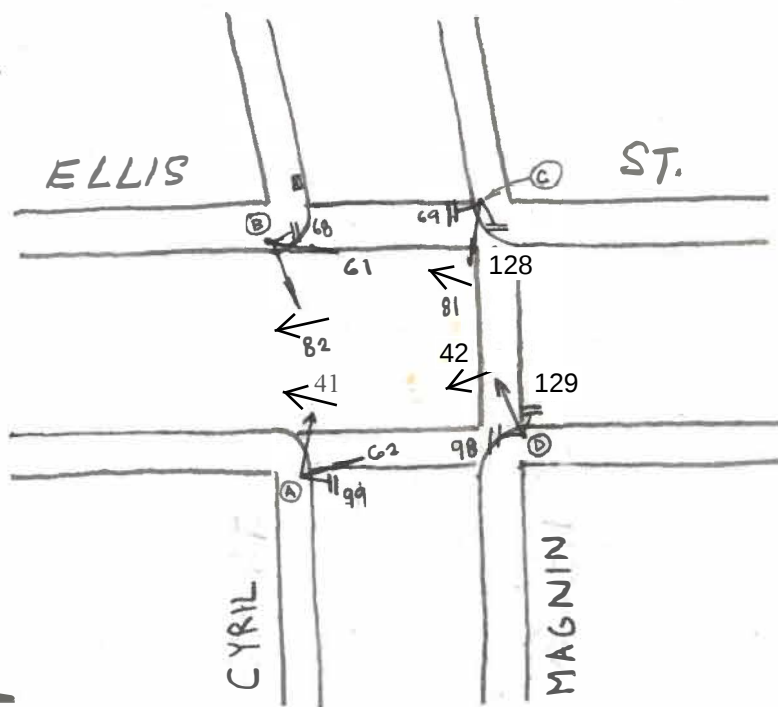


 $\phi_2 \rightarrow$

10-19-1932

[illegible]

CONTROLLER CABINET SIZE : ORDINARY BASE CABINET: YES

COMMENTS : Ellis Street One-Way conversion. Changed 41 & 42 to be 12" RA signal heads & updated numbering to match timing card. Ian Trout. SRC 2019-391

10-07-2020