


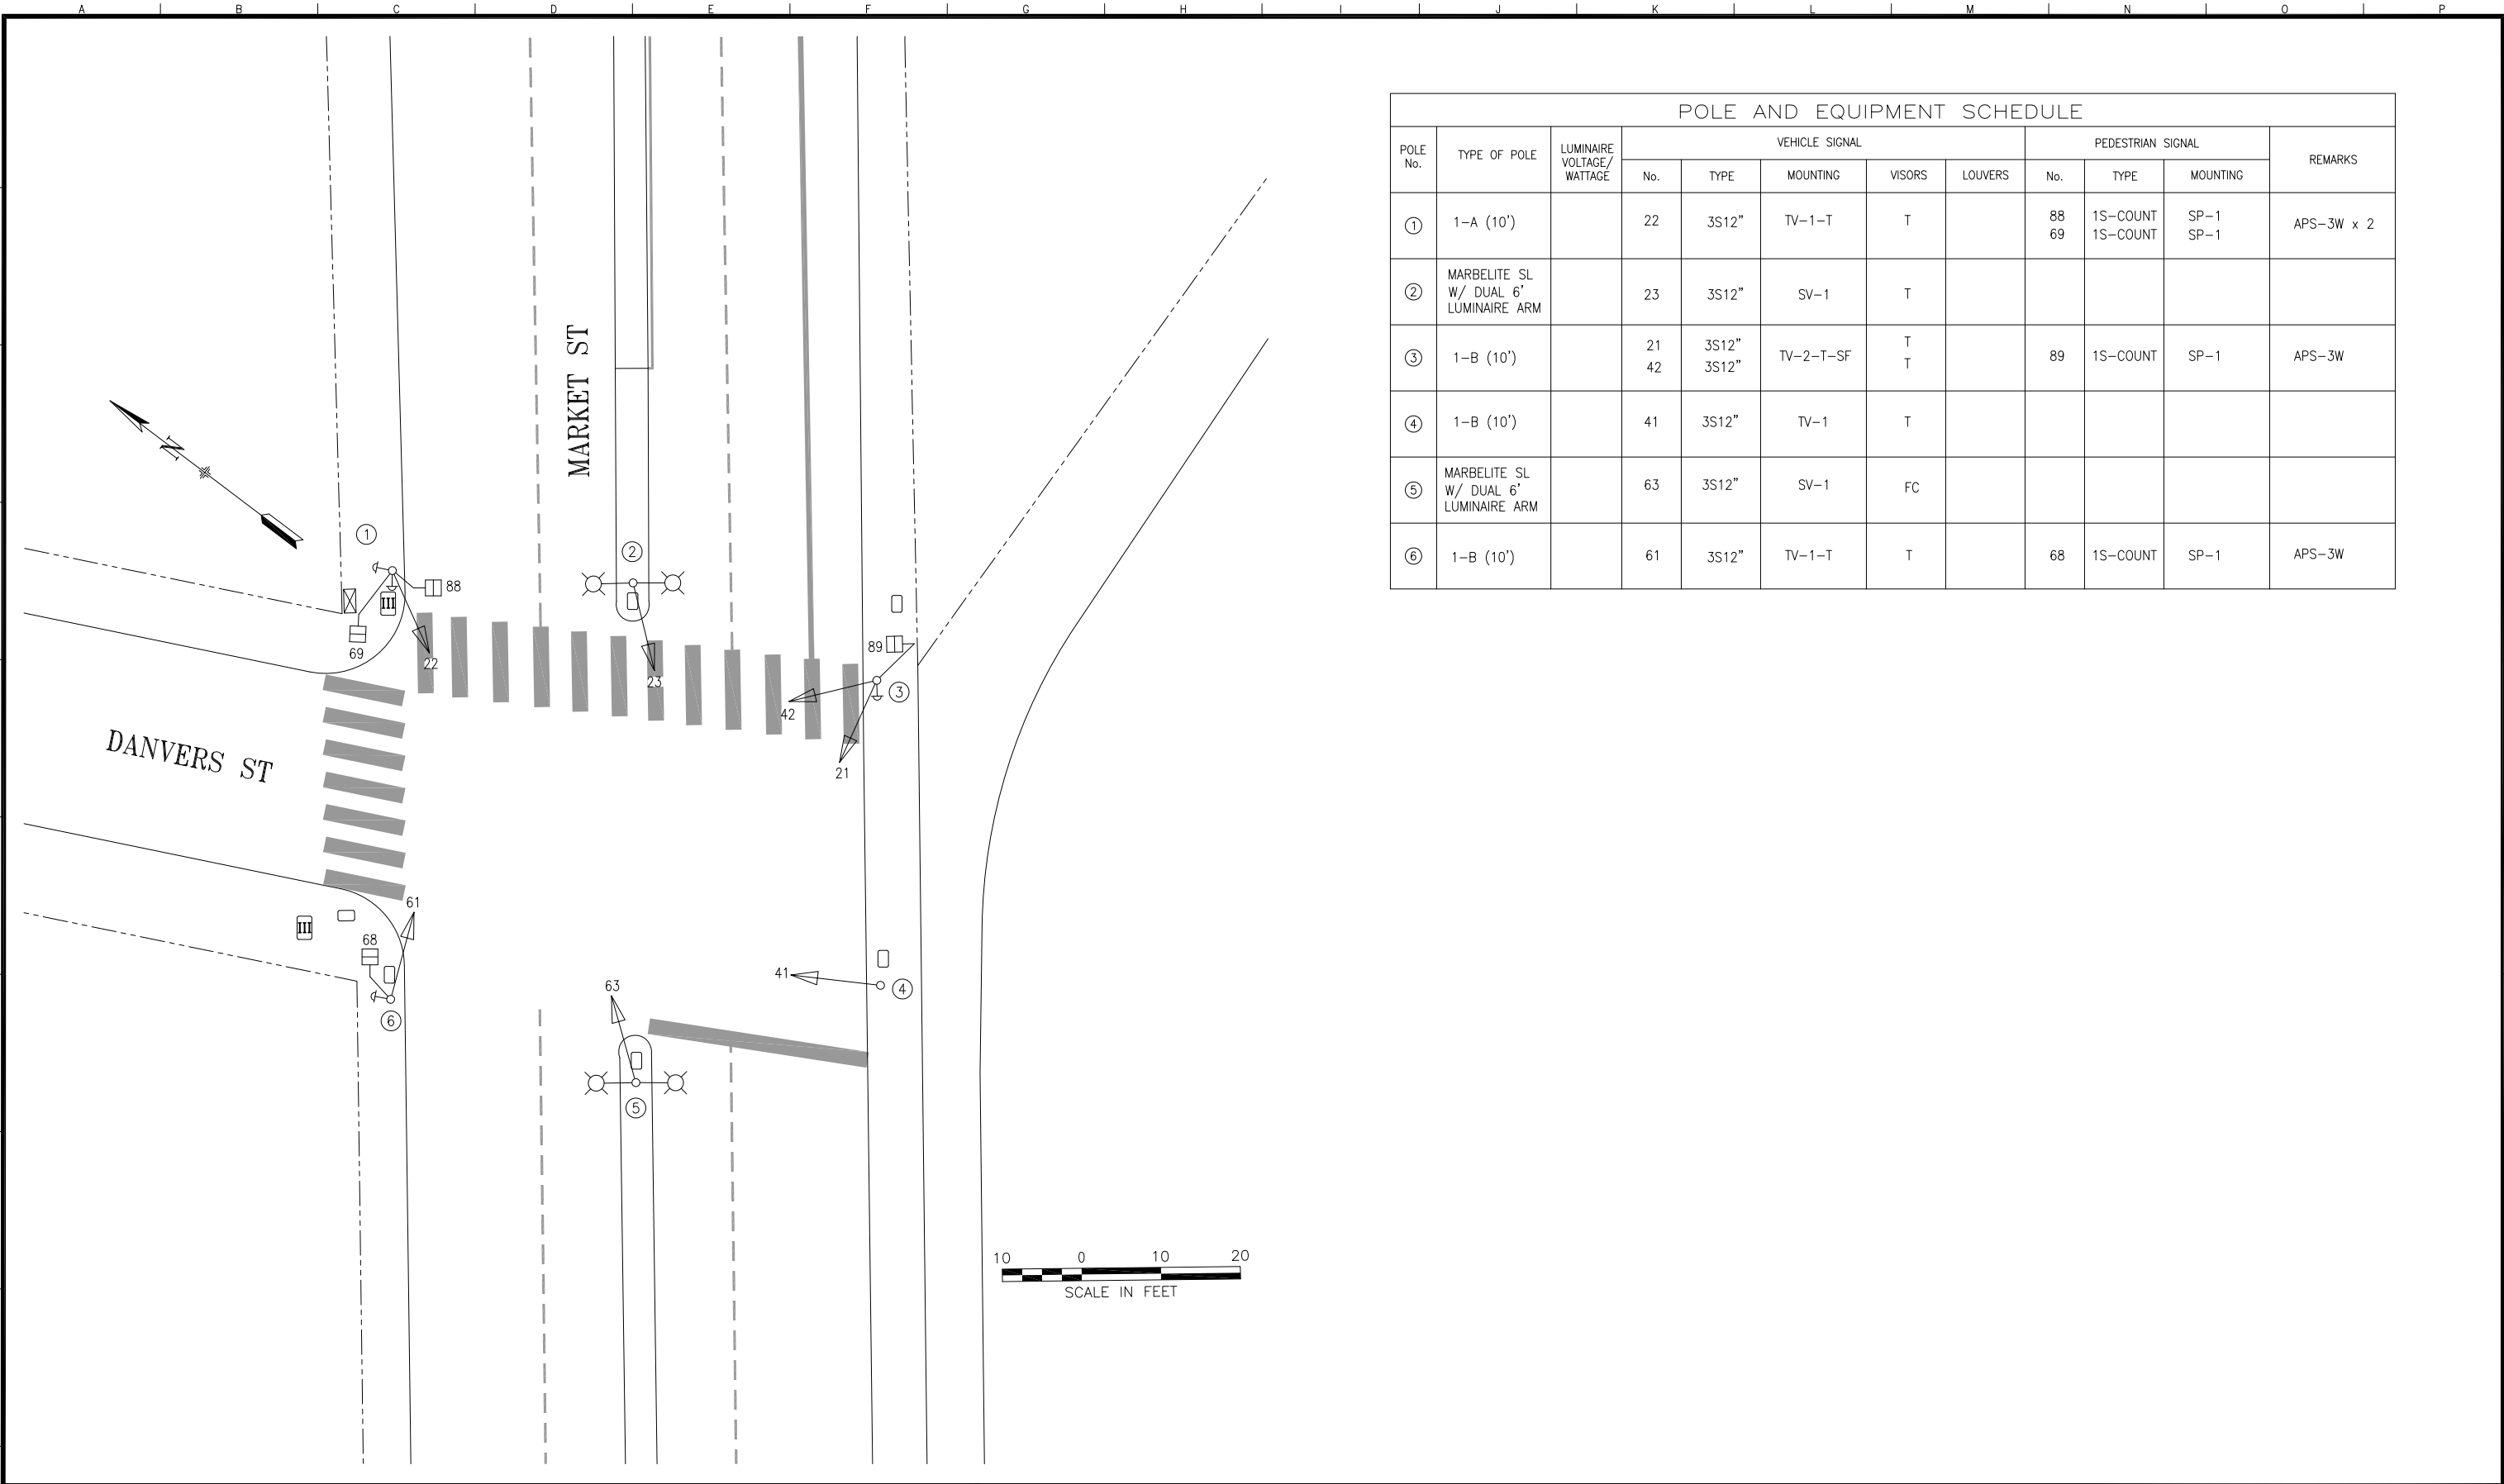

POLE AND EQUIPMENT SCHEDULE											
POLE No.	TYPE OF POLE	LUMINAIRE VOLTAGE/ WATTAGE	VEHICLE SIGNAL					PEDESTRIAN SIGNAL			REMARKS
			No.	TYPE	MOUNTING	VISORS	LOUVERS	No.	TYPE	MOUNTING	
①	1-A (10')		22	3S12"	TV-1-T	T		88 69	1S-COUNT 1S-COUNT	SP-1 SP-1	APS-3W x 2
②	MARBELITE SL W/ DUAL 6' LUMINAIRE ARM		23	3S12"	SV-1	T					
③	1-B (10')		21 42	3S12" 3S12"	TV-2-T-SF	T T		89	1S-COUNT	SP-1	APS-3W
④	1-B (10')		41	3S12"	TV-1	T					
⑤	MARBELITE SL W/ DUAL 6' LUMINAIRE ARM		63	3S12"	SV-1	FC					
⑥	1-B (10')		61	3S12"	TV-1-T	T		68	1S-COUNT	SP-1	APS-3W

4	08/26/22	UPGRADE 21, 42, 41, AND 63 TO 3S12" PER SRC 2022-210	A.Lam	E.Tsui
3	05/26/22	PER SHOP MAINTENANCE: 61 TO 3S12"	C.Skerrit	G.deLeon
2	01/22/22	INSTALL APS PER SRC 2021-138; PER FIELD: 23 TO 3S12"	E.Luu	G.deLeon
1	10/26/15	REMOVED SIGNAL 81 PER SRC 2015-246	A.Scales	M.Velasco
0	5/13/15	ADDED PCS PER SRC 2015-162	S.Shariati	M.Velasco
NO.	DATE	DESCRIPTION	BY	APPROVED
TABLE OF REVISIONS CHECKOUT DRAWING THROUGH THE SID CUSTODIAN FOR THE LATEST REVISION				



SFMTA

DRAWN BY:	DATE:
ASCALES	12/2015
CHECKED BY:	DATE:
MVELASCO	12/2015

SCALE
AS SHOWN
SHEET OF SHEETS
1 OF 1

TRAFFIC SIGNAL INVENTORY DIAGRAM
MARKET STREET AND DANVERS STREET

CNN NO:
26175000
REV NO:
4