


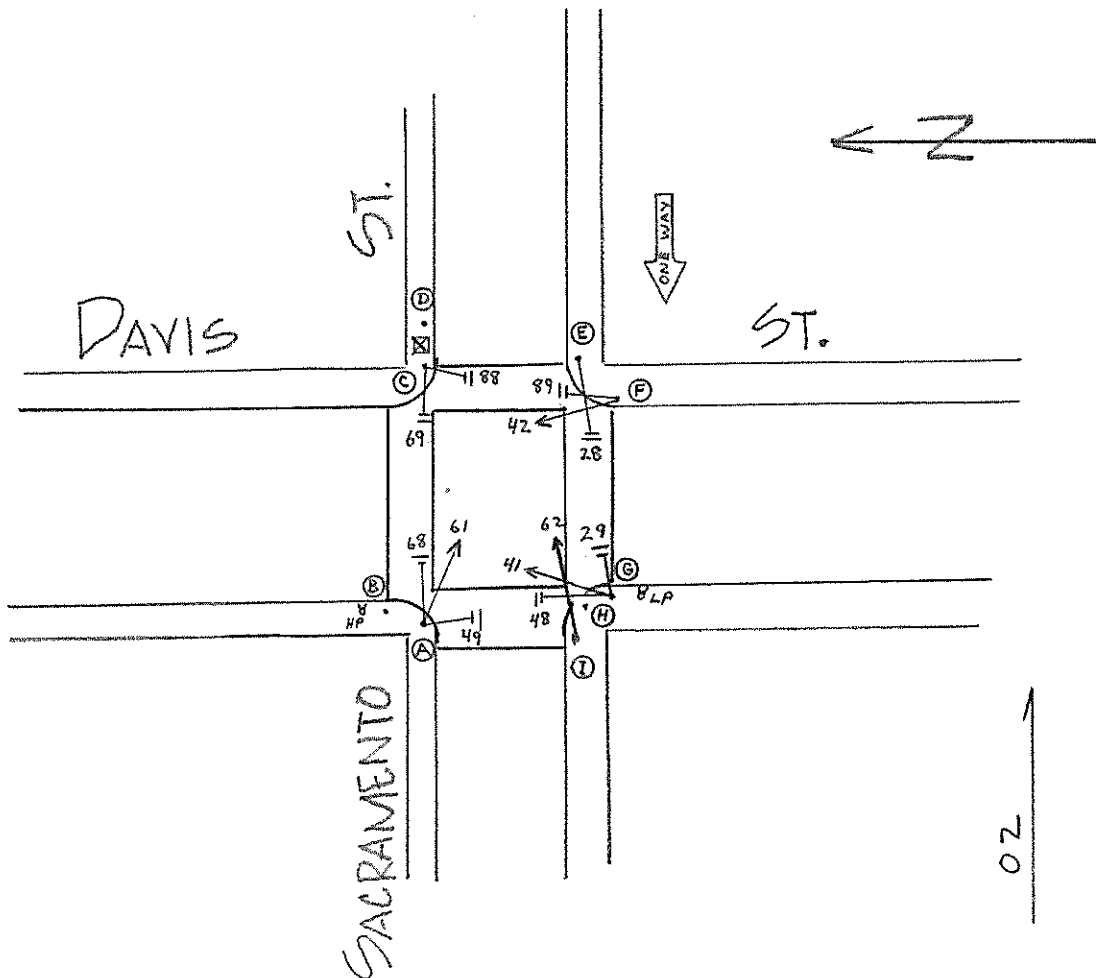

11-29-83

POLE	FUNC.	MAT'L	SIGNAL NO.	MAKE	NO. OF SECT.	SIZE	VISOR	B.P. OR LOUVERS	MOUN'T	PED SIGNAL NO.	LEGEND	MESSAGE		MAKE	MOUN'T
												ELEMENT	COLOR		
A	L	S	61	EC	3	8"	FC	No	S	49	W/DW	IS-1	OR/W	ICC	S
B	M	S	42	EC	3	8"	FC	No	T	68	W/DW	IS-1	OR/W	ICC	S
C	S	S	41	EC	3	8"	FC	No	S	69	W/DW	IS-1	OR/W	ICC	T
D	M	S	62	EC	3	8"	FC	No	T	88	W/DW	IS-1	OR/W	ICC	T
E	L	S								89	W/DW	IS-1	OR/W	ICC	S
F	S	S								78	W/DW	IS-1	OR/W	ICC	S
G	L	S								29	W/DW	IS-1	OR/W	ICC	S
H	M	S								48	W/DW	IS-1	OR/W	ICC	S
I	S	S													

CONTROLLER CABINET SIZE : ORDINARY BASE CABINET: YES
COMMENTS :