


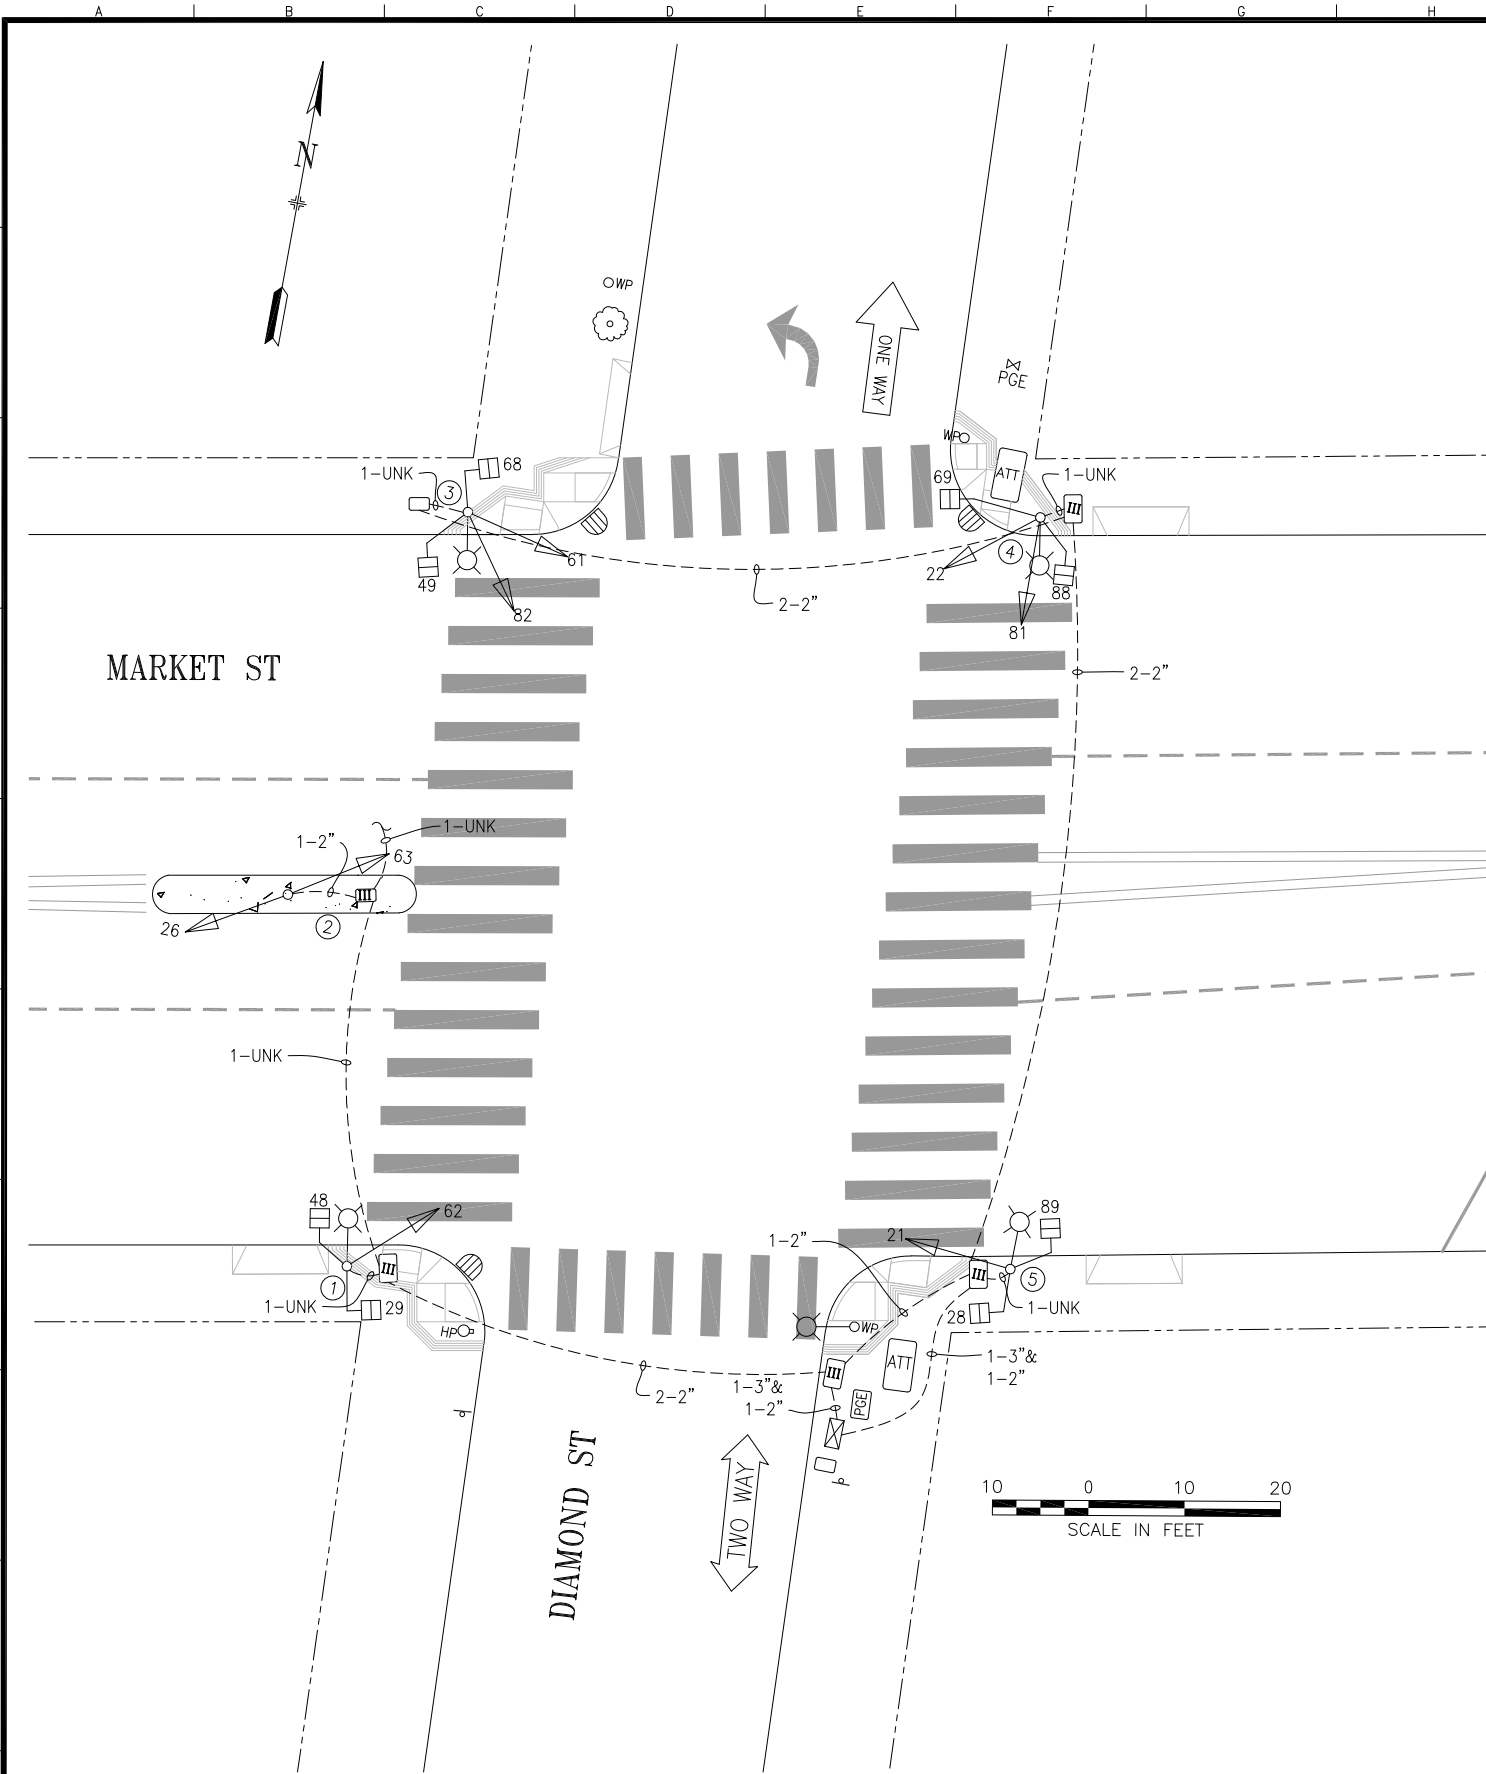

POLE AND EQUIPMENT SCHEDULE											
POLE No.	TYPE OF POLE	LUMINAIRE VOLTAGE/ WATTAGE	VEHICLE SIGNAL					PEDESTRIAN SIGNAL			REMARKS
			No.	TYPE	MOUNTING	VISORS	LOUVERS	No.	TYPE	MOUNTING	
①	CITY STANDARD STREET LIGHT		62	3S12"	SV-1-T	T		29 48	1S-COUNT 1S-COUNT	SP-1(22") SP-1-SF(12")	
②	1-A (10')		26 63	3S12" 3S12"	TV-2-T	T T					
③	PEDESTAL STREET LIGHT POLE		61 82	3S12" 3S12"	SV-2-TC	T T		49 68	1S-COUNT 1S-COUNT	SP-1-SF(12") SP-1(22")	
④	CITY STANDARD STREET LIGHT		22 81	3S12" 3S12"	SV-2-TC	T T		69 88	1S-COUNT 1S-COUNT	SP-1(22") SP-1-SF(12")	
⑤	CITY STANDARD STREET LIGHT		21	3S12"	SV-1-T	T		28 89	1S-COUNT 1S-COUNT	SP-1(22") SP-1-SF(12")	

2	2/9/24	CHANGE POLE 2 TO 1-A AND UPGRADE MEDIAN BOX TO TYPE III VIA CITY FORCES	D'Yeung	GdeLeon	
1	8/4/15	2543J PUNCHLIST WALKTHROUGH; ADD PCS AND UPGRADE TO 12"	D'Yeung	MVelasco	
0	12/17/14	NEW CONDUITS, CABINET AND SIGNALS 61 & 22 INSTALLED BY 2202J	JHombostel	MVelasco	
NO.	DATE	DESCRIPTION	BY	APPROVED	
TABLE OF REVISIONS					
CHECKOUT DRAWING THROUGH THE SID CUSTODIAN FOR THE LATEST REVISION					



SFMTA

DRAWN BY:		DATE:	
AScales		11/2015	
CHECKED BY:		DATE:	
MVelasco		11/2015	

SCALE
AS SHOWN
SHEET OF SHEETS
1 OF 1

TRAFFIC SIGNAL INVENTORY DIAGRAM
DIAMOND STREET AND MARKET STREET

CNN NO:
25827000
REV NO:
2