



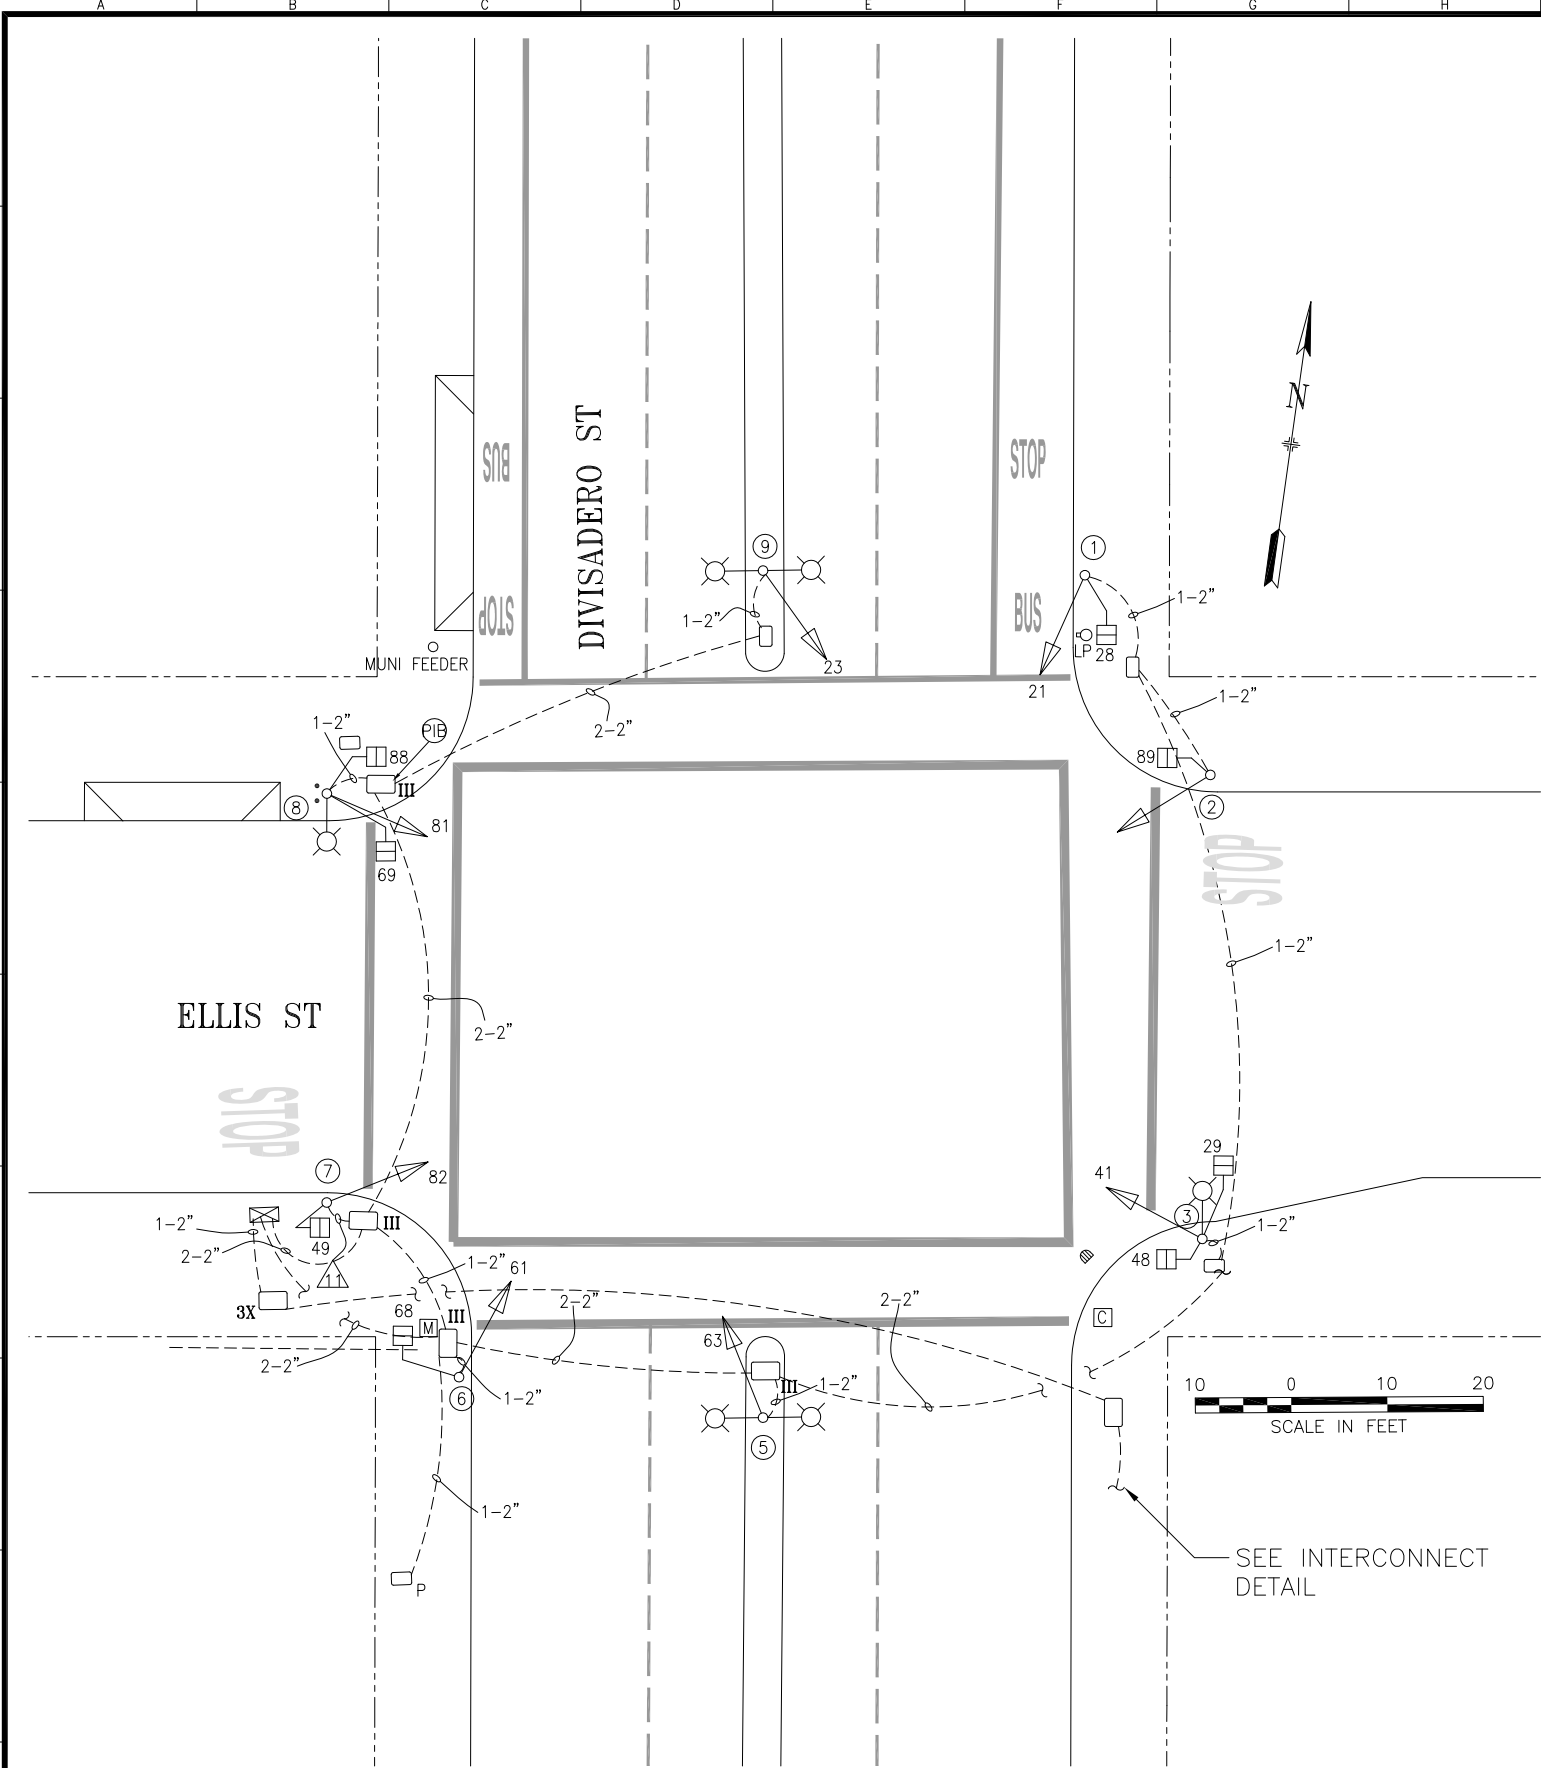

POLE AND EQUIPMENT SCHEDULE										
POLE No.	TYPE OF POLE	LUMINAIRE VOLTAGE/WATTAGE	VEHICLE SIGNAL					PEDESTRIAN SIGNAL		
			No.	TYPE	MOUNTING	VISORS	LOUVERS	No.	TYPE	MOUNTING
①	EX MUNI/SIGNAL COMB POLE		21	3S12"	SV-1-T	T		28	1S-COUNT	SP-1
②	1-A (10')		42	3S12"	TV-1	T		89	1S-COUNT	SP-1
③	EX MARBELITE SL		41	3S12"	SV-1-T	T		29 48	1S-COUNT 1S-COUNT	SP-1-SF (12") SP-1 (22")
④	NOT USED									
⑤	EX MARBELITE SL		63	3S12"	SV-1	T				
⑥	1-A (10')		61	3S12"	TV-1	T		68	1S-COUNT	SP-1
⑦	1-A (10')		82	3S12"	TV-1	T		49	1S-COUNT	SP-1
⑧	EX MARBELITE SL		81	3S12"	SV-1-T	T		69 88	1S-COUNT 1S-COUNT	SP-1-SF (12") SP-1 (22")
⑨	EX MARBELITE SL		23	3S12"	SV-1	T				


PHASE DIAGRAM

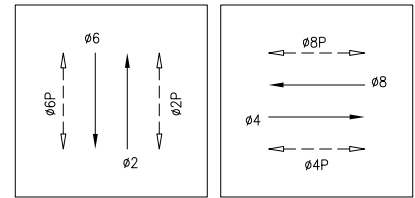

PHASE SEQUENCE

G	Y	R	DIVISADERO ST (NB & SB) - ø2 & ø6	
R		G	Y	R
WM	FRH	RH		ELLIS ST (EB & WB) - ø4 & ø8
RH		WM	FRH	RH
				PED XING ELLIS ST (ES & WS) - ø2P & ø6P
				PED XING DIVISADERO ST (SS & NS) - ø4P & ø8P

INTERCONNECT WIRING

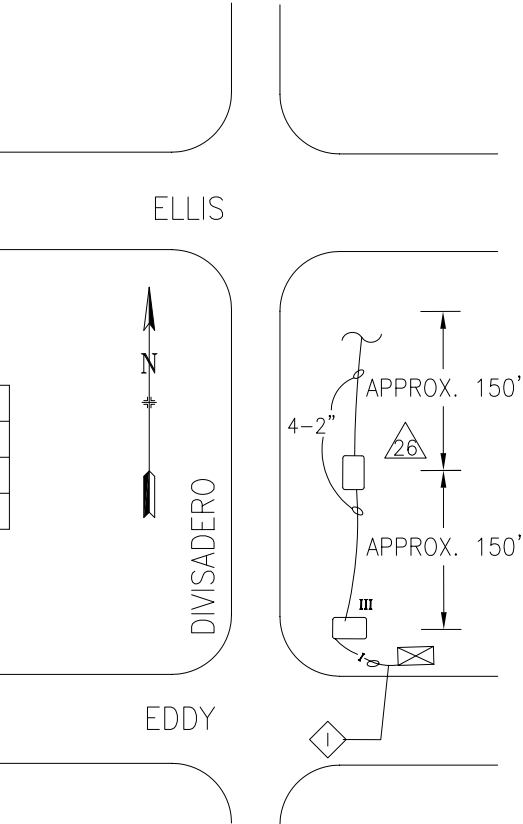

0	4/9/09	ACTIVATED NEW SIGNALS THROUGH CT 59 (1499J); CONVERTED FROM AS-BUILTS.		SS	GD
NO.	DATE	DESCRIPTION		BY	APP.
TABLE OF REVISIONS CHECK WITH TRACING TO SEE IF YOU HAVE LATEST REVISION					

REFERENCE INFORMATION & FILE NO. OF SURVEYS
--



SAN FRANCISCO MUNICIPAL TRANSPORTATION AGENCY
CITY AND COUNTY OF SAN FRANCISCO

DRAWN:	DATE:
SS	10/14
CHECKED:	DATE:
GD	10/14

SCALE:
AS SHOWN
SHEET OF SHEETS
1 OF 1

TRAFFIC SIGNAL INVENTORY DIAGRAM
ELLIS ST & DIVISADERO ST

CNN NO.
26800000
REV NO.