


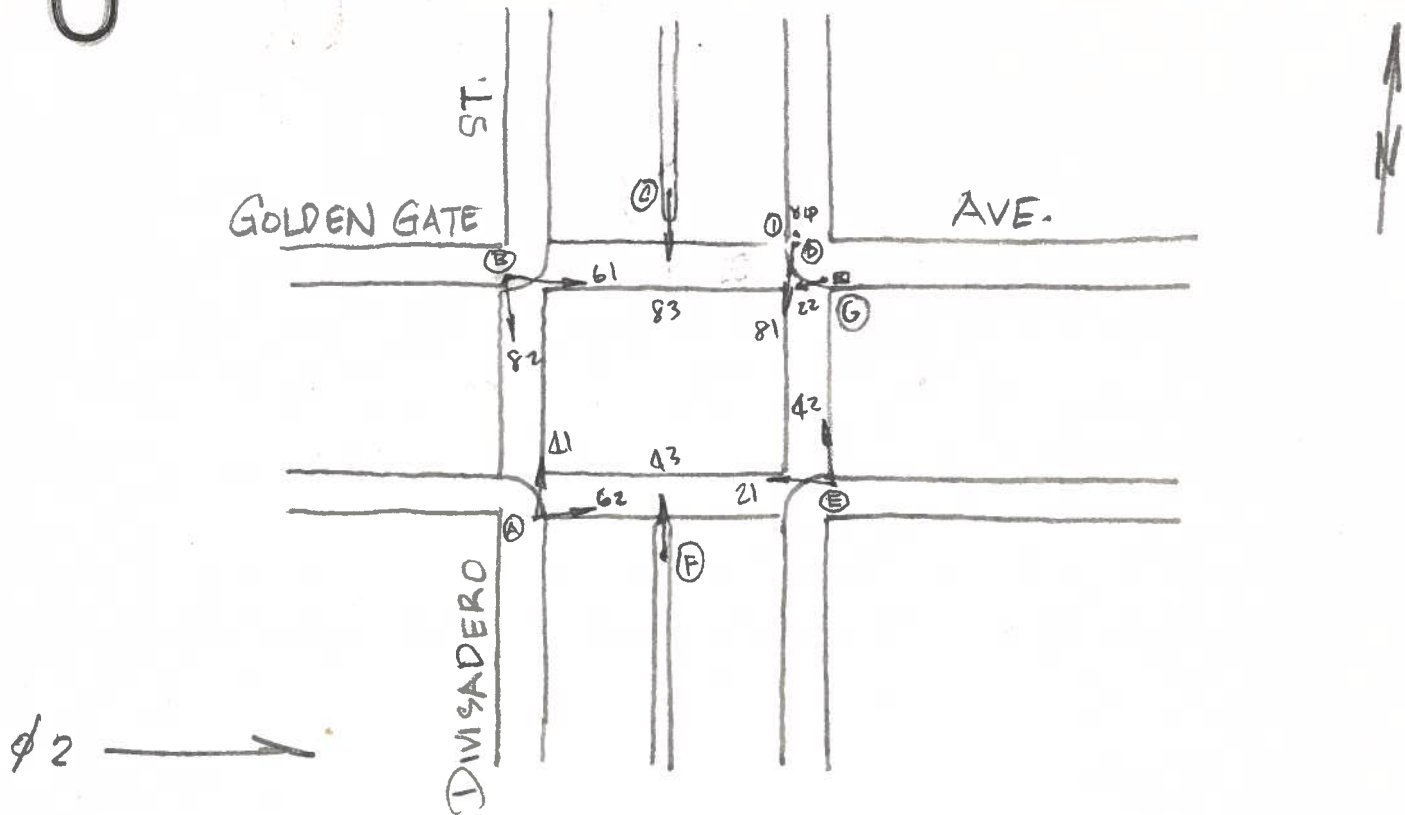

11-24-19

POLE	FUNC.	MATL	SIGNAL NO.	MAKE	NO. OF SECT.	SIZE	VISOR	B.P. OR LOUVERS	MOUN'T	PED SIGNAL NO.	LEGEND	MESSAGE		MAKE	MOUN'T
												ELEMENT	COLOR		
A	S	C	62	EO	3	12"	FLTR	NO	T						
B	L	C	41	EO	3	12"	FLTR	NO	T						
C	L	C	82	EO	3	12"	FLTR	NO	S						
D	S	C	61	EO	3	12"	FLTR	NO	S						
E	L	C	83	EC	3	12"	FLTR	NO	S						
F	L	C	22	EO	3	12"	FLTR	NO	T						
			81	EO	3	12"	FLTR	NO	T						
I	U	S	42	EO	3	12"	T	NO	S						
			21	EO	3	12"	T	NO	S						
G	1-A (13')		43	EC	3	12"	FLTR	NO	S						

CONTROLLER CABINET SIZE : ORDINARY BASE CABINET: NO

COMMENTS: Shahram Shariati

SRL 2019-127 Upgrade All 8" Signal Heads to 12" Heads