



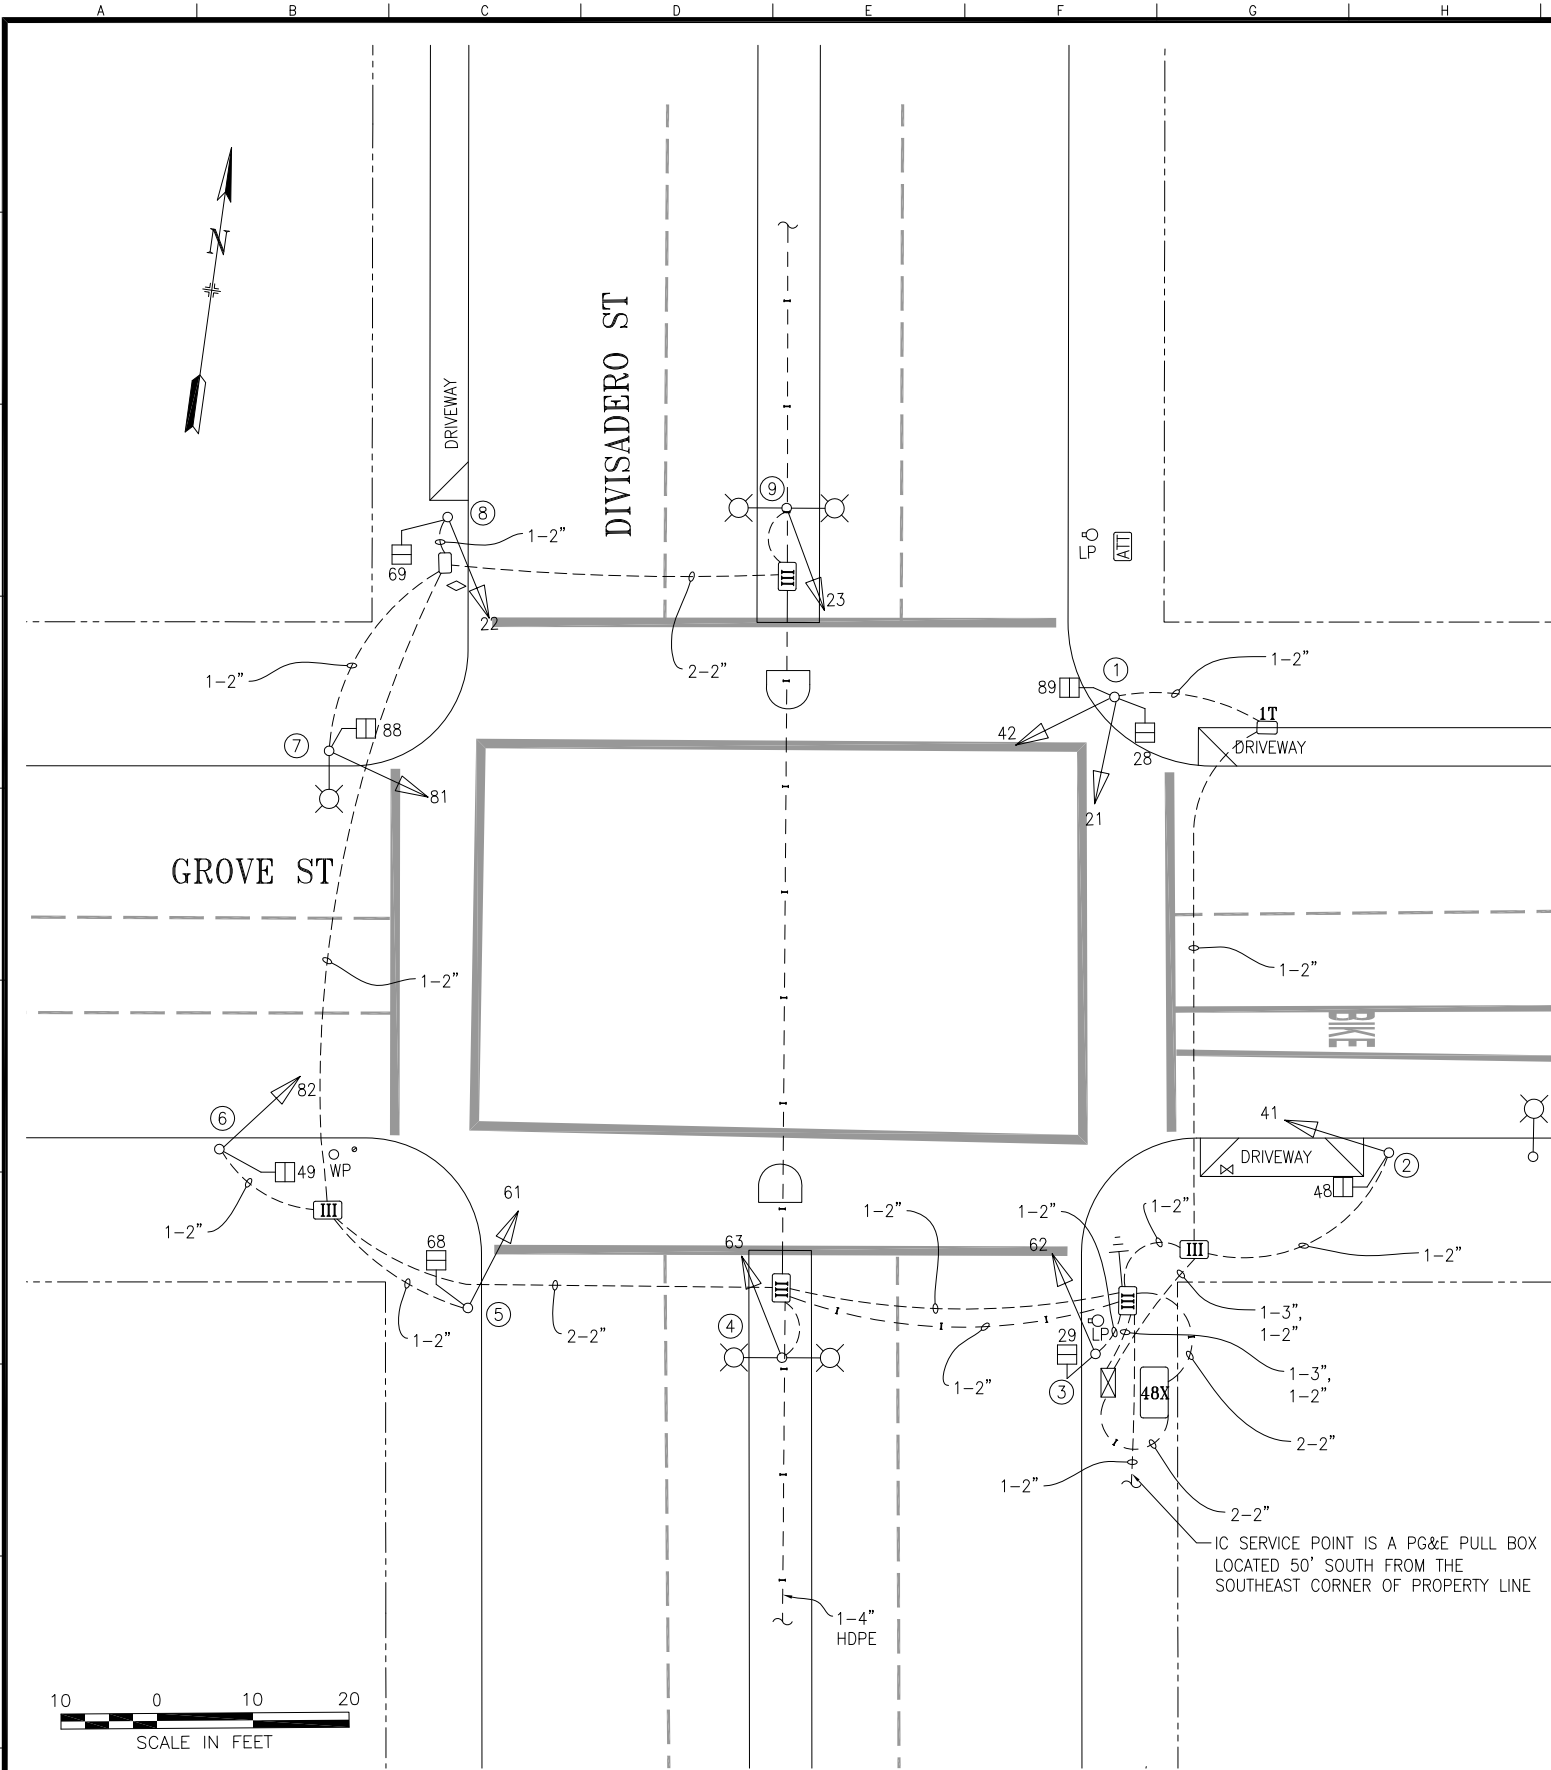

POLE AND EQUIPMENT SCHEDULE											
POLE No.	TYPE OF POLE	LUMINAIRE VOLTAGE/ WATTAGE	VEHICLE SIGNAL					PEDESTRIAN SIGNAL			REMARKS
			No.	TYPE	MOUNTING	VISORS	LOUVERS	No.	TYPE	MOUNTING	
①	1-A (10')		21 42	3S12" 3S12"	TV-2-T-SFA	T T		28 89	1S-COUNT 1S-COUNT	SP-1 SP-1	
②	1-A (10')		41	3S12"	TV-1-T	T		48	1S-COUNT	SP-1	
③	1-A (10')		62	3S12"	TV-1-T	T		29	1S-COUNT	SP-1	
④	EX MARBELITE SL		63	3S12"	SV-1	T					
⑤	1-A (10')		61	3S12"	TV-1-T	T		68	1S-COUNT	SP-1	
⑥	1-A (10')		82	3S12"	TV-1-T	T		49	1S-COUNT	SP-1	
⑦	CITY STANDARD STREET LIGHT	120V 150W	81	3S12"	SV-1-T	T		88	1S-COUNT	SP-1	
⑧	1-A (10')		22	3S12"	TV-1-T	T		69	1S-COUNT	SP-1	
⑨	EX MARBELITE SL		23	3S12"	SV-1	T					

PHASE DIAGRAM

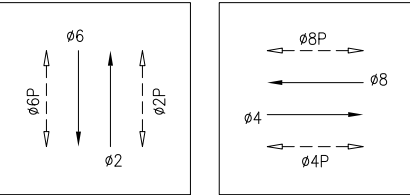

PHASE SEQUENCE
(STEADY DEMAND)

G	Y	R	DIVISADERO ST (NB & SB) - ø2 & ø6	
R	G	Y R	GROVE ST (EB & WB) - ø4 & ø8	
WM	FRH	RH	PED XING GROVE ST (ES & WS) - ø2P & ø6P	
RH	WM	FRH RH	PED XING DIVISADERO ST (SS & NS) - ø4P & ø8P	

0	04/06/12	NEW SIGNAL ACTIVATED THROUGH CT 60	GH	GD
NO.	DATE	DESCRIPTION	BY	APP.
TABLE OF REVISIONS				
CHECK WITH TRACING TO SEE IF YOU HAVE LATEST REVISION				

REFERENCE INFORMATION
& FILE NO. OF SURVEYS



SAN FRANCISCO MUNICIPAL TRANSPORTATION AGENCY
CITY AND COUNTY OF SAN FRANCISCO

DESIGNED:	DATE:
GD	12/2013
DRAWN:	DATE:
GD	12/2013
CHECKED:	DATE:
MV	12/2013

SCALE:

AS SHOWN

SHEET OF SHEETS

1 OF 1

TRAFFIC SIGNAL INVENTORY DIAGRAM

DIVISADERO ST AND GROVE ST

CNN NO.

26056000

REV NO.

0