


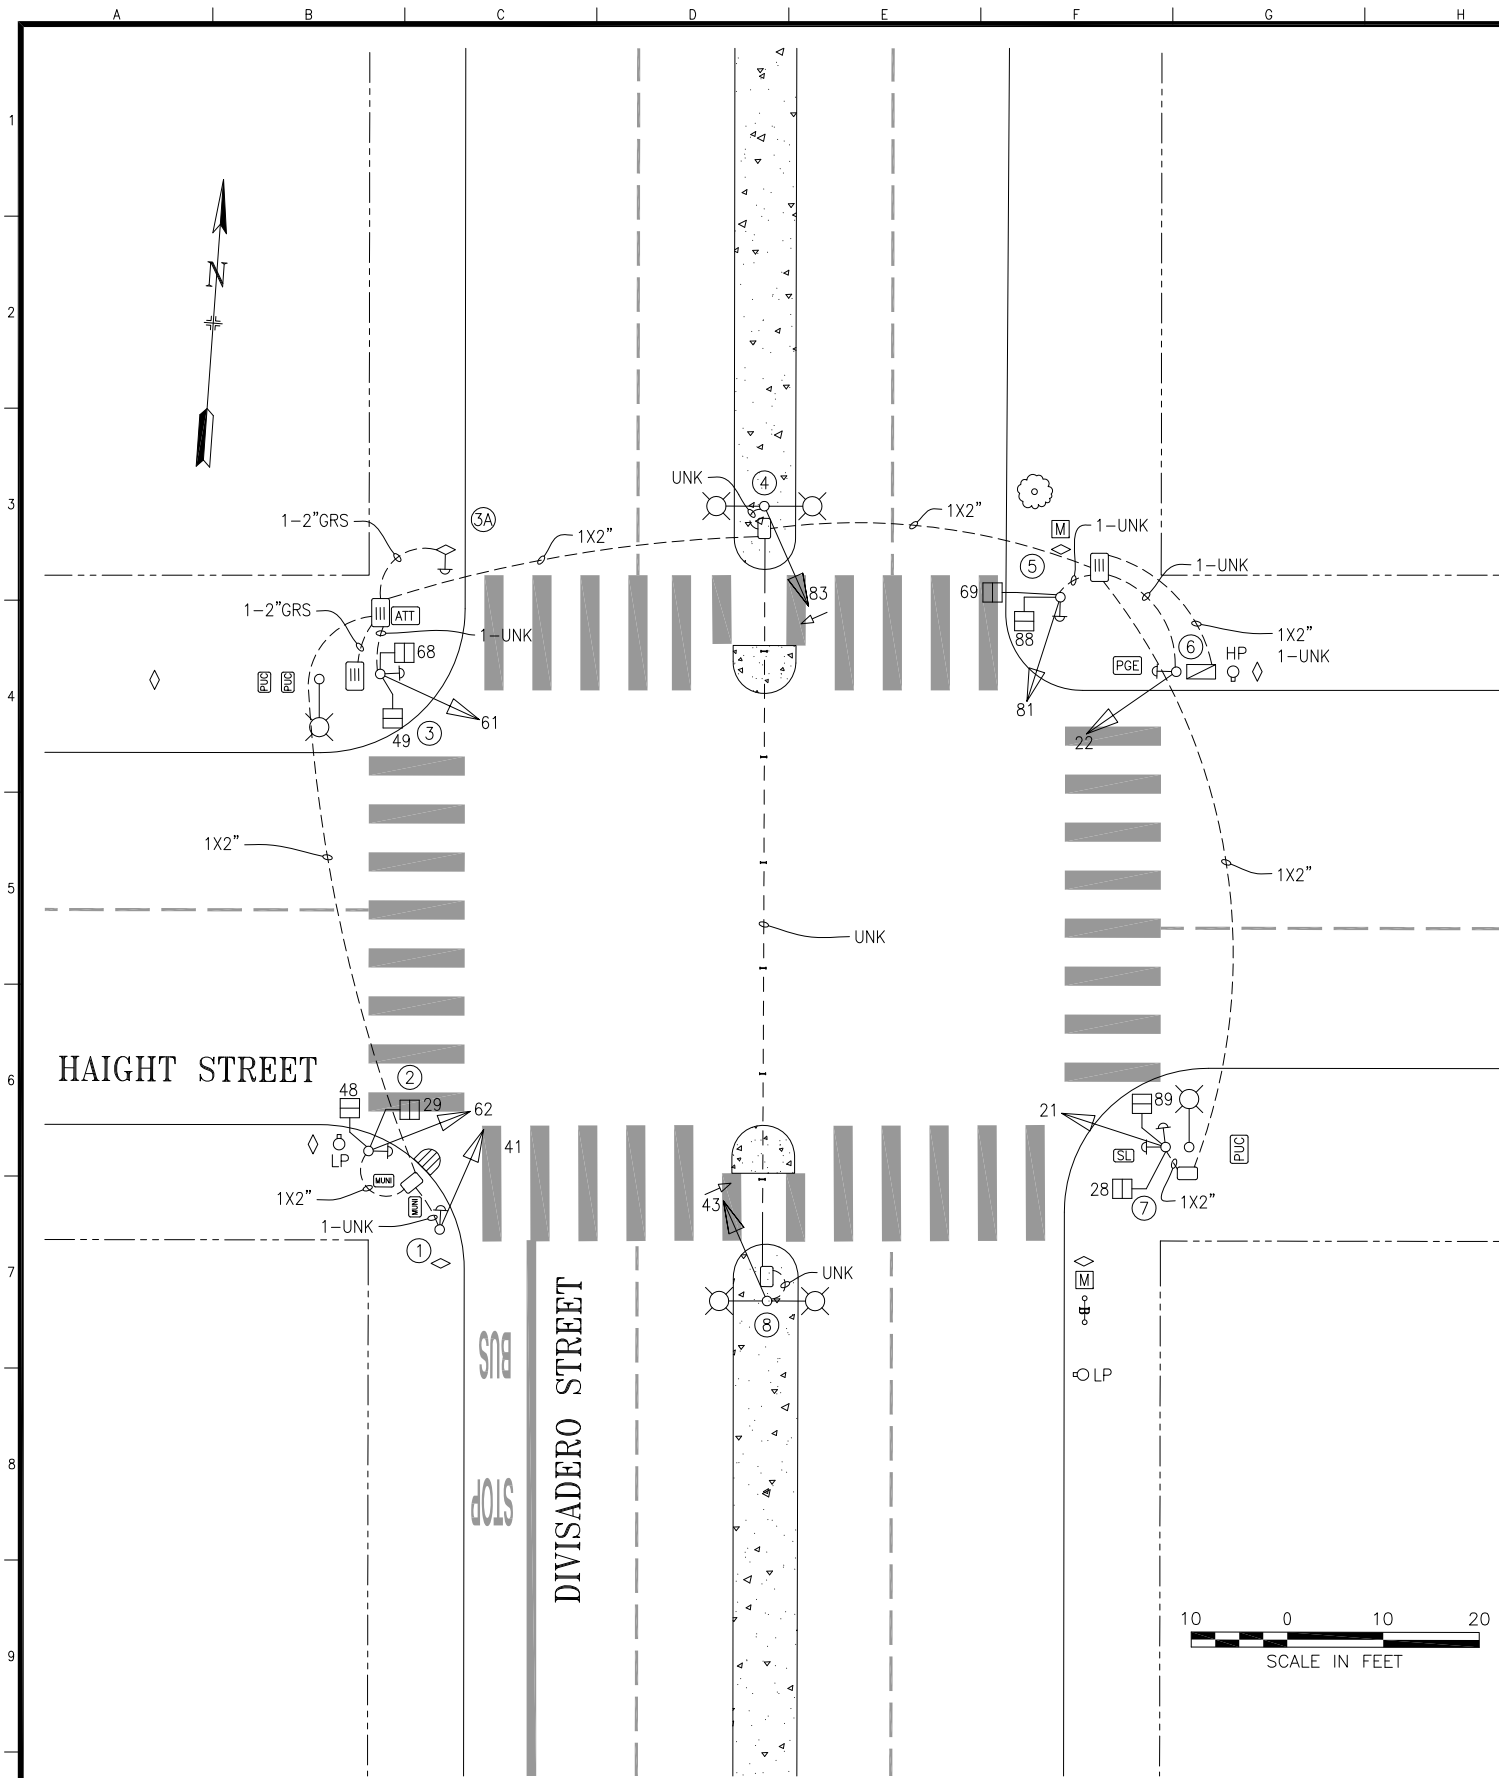

POLE AND EQUIPMENT SCHEDULE											
POLE No.	TYPE OF POLE	LUMINAIRE VOLTAGE/ WATTAGE	VEHICLE SIGNAL					PEDESTRIAN SIGNAL			REMARKS
			No.	TYPE	MOUNTING	VISORS	LOUVERS	No.	TYPE	MOUNTING	
①	MARBELITE PEDESTAL SIGNAL POLE (10')		41	3S12"	TV-1-T	T					APS-4W
②	1-A (10')		62	3S12"	TV-1-T	T		48 29	1S-COUNT 1S-COUNT	SP-1 SP-1	APS-4W
③	MARBELITE PEDESTAL SIGNAL POLE (10')		61	3S12"	TV-1-T	T		49 68	1S-COUNT 1S-COUNT	SP-1 SP-1(22")	APS-4W
③A	MUNI POLE										LB CONDULET AT POLE BASE APS-4W
④	MARBELITE SL W/DUAL LUMINAIRE ARMS		83	4S12"GLA	SV-1-T	T					
⑤	MARBELITE PEDESTAL SIGNAL POLE (10')		81	3S12"	TV-1-T	T		88 69	1S-COUNT 1S-COUNT	SP-1 SP-1	APS-4W
⑥	MUNI POLE (13')		22	3S12"	SV-1-T	T					EXTERNAL CONDUIT APS-4W
⑦	1-A (10')		21	3S12"	TV-1-T	T		89 28	1S-COUNT 1S-COUNT	SP-1 SP-1(22")	APS-4W APS-4W
⑧	MARBELITE SL W/DUAL LUMINAIRE ARMS		43	4S12"GLA	SV-1-T	T					

TABLE OF REVISIONS				
NO.	DATE	DESCRIPTION	BY	APP.
2	2/4/19	(N) GRS & TYPE III BOXES AT NW CORNER BY 2264J; ADD APS PER SRC 2018-099	DYeung	DeLeon
1	8/5/15	2543J PUNCHLIST WALKTHROUGH; UPGRADE TO 12"; ADD PCS XING DIVISADERO	DYeung	Velasco
0	10/11/01	1434N SID CONVERTED FROM AS-BUILT; PCS XING HAIGHT	AScales	Velasco

CHECK WITH TRACING TO SEE IF YOU HAVE LATEST REVISION

REFERENCE INFORMATION
& FILE NO. OF SURVEYS



SAN FRANCISCO MUNICIPAL TRANSPORTATION AGENCY
CITY AND COUNTY OF SAN FRANCISCO

DRAWN: DATE:
AScales 12/2015
CHECKED: DATE:
MVelasco 12/2015

SCALE:

AS SHOWN

SHEET OF SHEETS

1 OF 1

TRAFFIC SIGNAL INVENTORY DIAGRAM

DIVISADERO STREET AND HAIGHT STREET

CNN NO.

26026000

REV NO.