



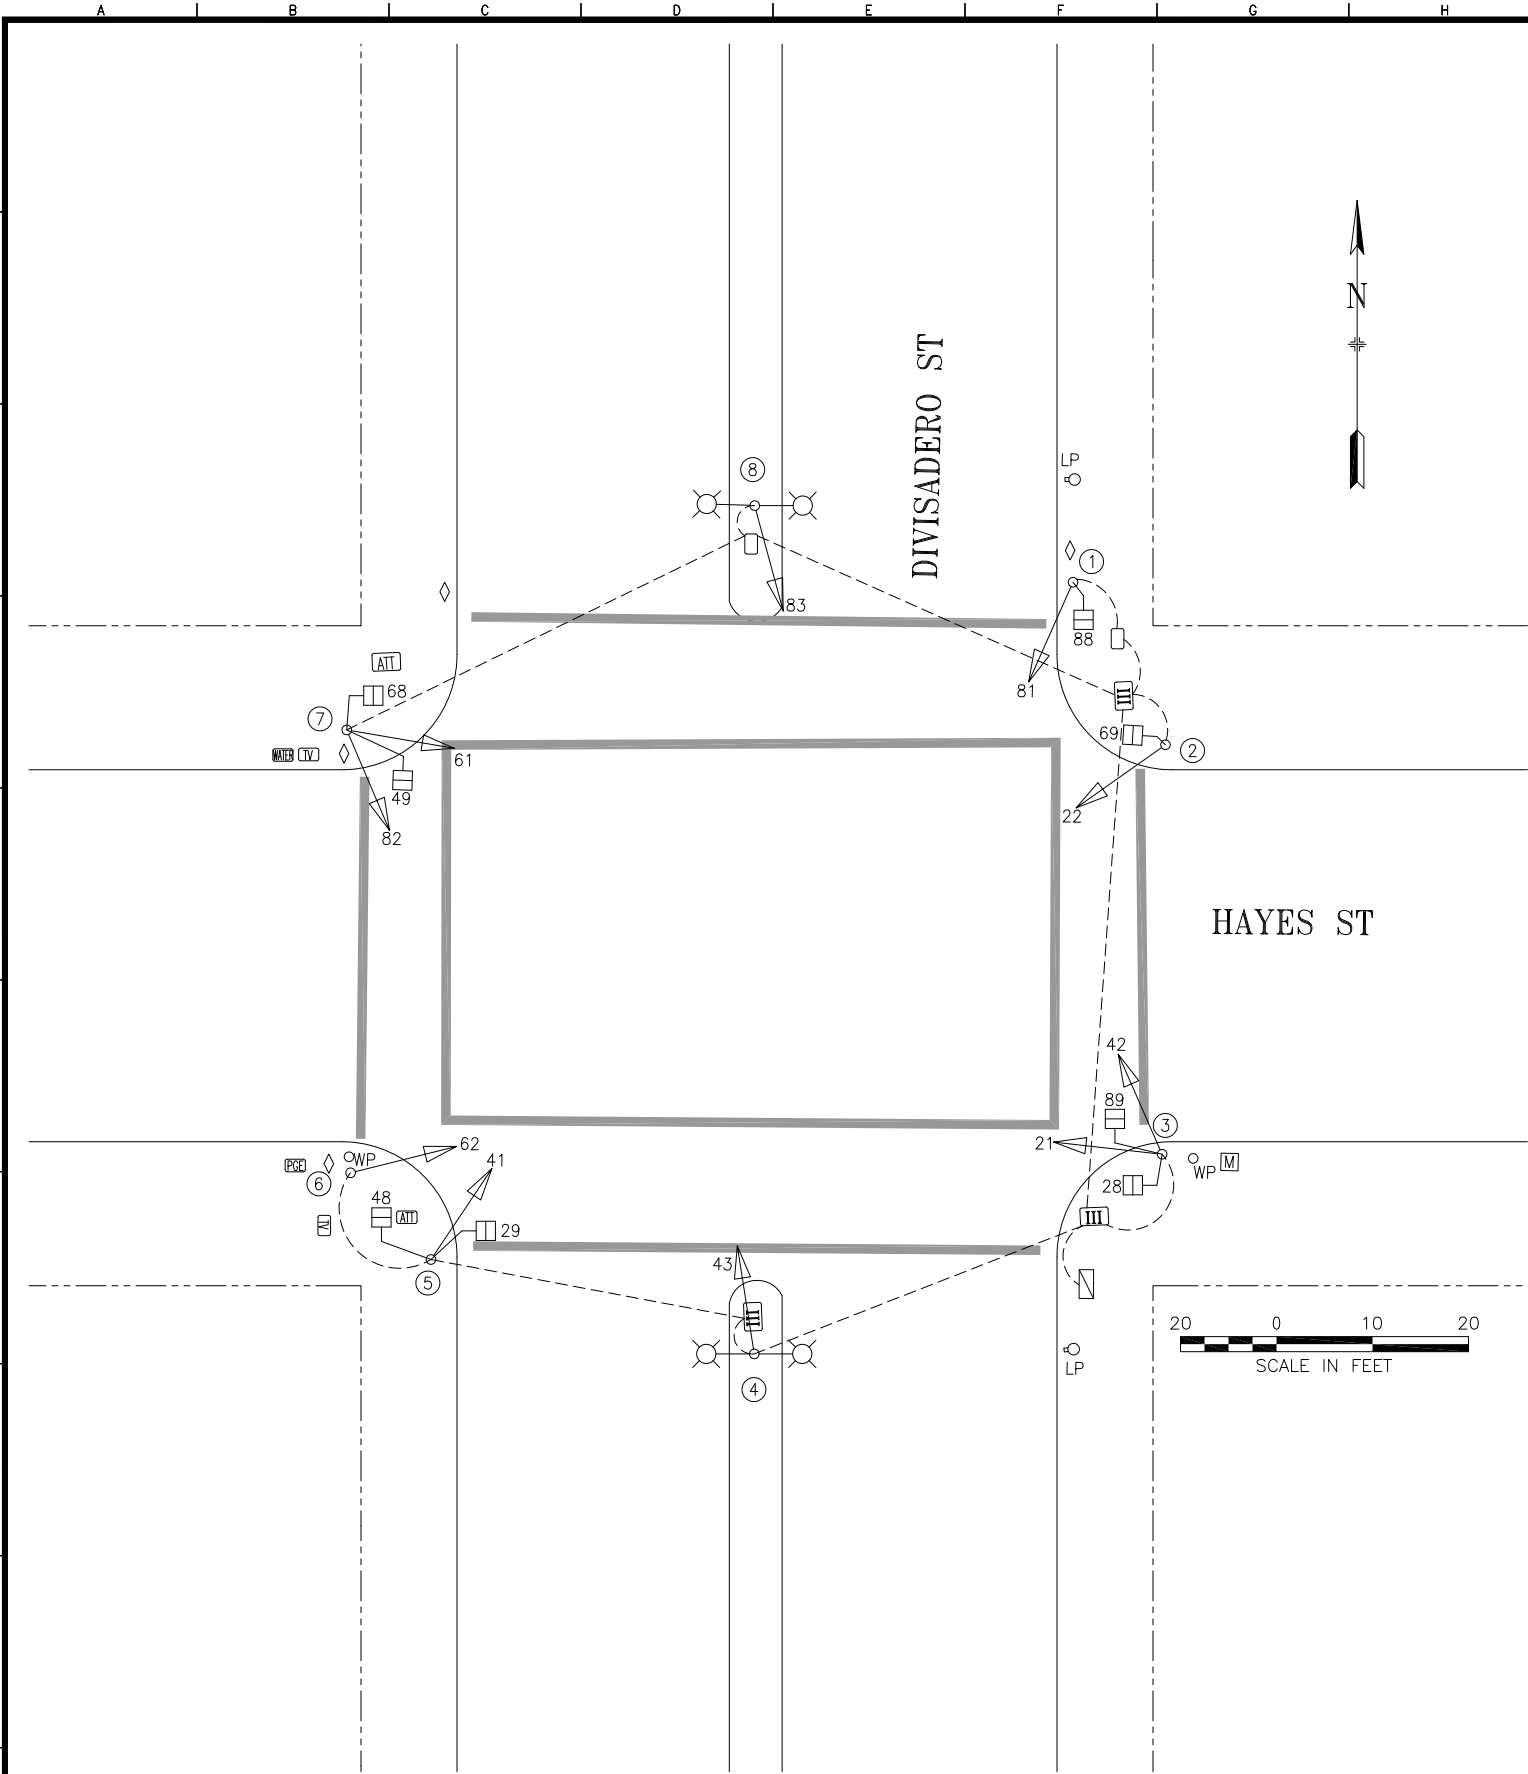

POLE AND EQUIPMENT SCHEDULE											
POLE No.	TYPE OF POLE	LUMINAIRE VOLTAGE/ WATTAGE	VEHICLE SIGNAL					PEDESTRIAN SIGNAL			REMARKS
			No.	TYPE	MOUNTING	VISORS	LOUVERS	No.	TYPE	MOUNTING	
①	MARBELITE (10')		81	3S12"	TV-1-T	FC		88	1S-COUNT	SP-1	
②	1-B (10')		22	3S12"	TV-1-T	FC		69	1S-COUNT	SP-1	
③	MARBELITE (10')		21 42	3S12" 3S12"	TV-2-T	FC FC		28 89	1S-COUNT 1S-COUNT	SP-2-T-SF	
④	MARBELITE STREETLIGHT		43	3S12"	SV-1-T	FC					EXTERNAL CONDUIT
⑤	MARBELITE (10')		41	3S12"	TV-1-T	FC		29 48	1S-COUNT 1S-COUNT	SP-2-T-SF	
⑥	WOOD POLE		62	3S12"	SV-1-T	FC					WOOD POLE WITH EXTERNAL CONDUIT
⑦	MARBELITE (10')		61 82	3S12" 3S12"	TV-2-T	FC FC		49 68	1S-COUNT 1S-COUNT	SP-2-T-SF	
⑧	MARBELITE STREETLIGHT		83	3S12"	SV-1-T	T					

PHASE DIAGRAM

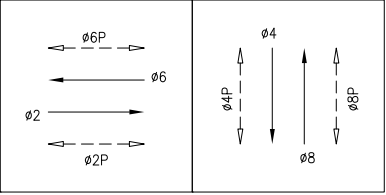

PHASE SEQUENCE

G		Y	R			HAYES (EB+WB) – ø2+ø6	
R		G			Y	R	DIVISADERO (SB +NB) – ø4+ø8
WM		FRH	RH			PED XING DIVISADERO (SS+NS) – ø2P+ø6P	
RH		WM		FRH		RH	PED XING HAYES (WS+ES) – ø4P+ø8P

NO.		DATE	DESCRIPTION	BY	APP.
2	10/30/19		SRC 2019-127 REPLACED ALL 8" SIGNAL HEADS WITH 12" SIGNAL HEADS	S.SHARAT	G.HD
1	10/28/08		INSTALL COUNTDOWN PED SIGNALS (VIA DPT SIGNAL SHOP).	G.DALEON	H.QUAN
TABLE OF REVISIONS CHECK WITH TRACING TO SEE IF YOU HAVE LATEST REVISION					

COMPLETION DATE / ELECTRICIAN INITIAL
--



DEPARTMENT OF PARKING AND TRAFFIC
DIVISION OF TRAFFIC ENGINEERING
CITY AND COUNTY OF SAN FRANCISCO

DRAWN:	DATE:	SCALE:
GD/CXL	11/08	AS SHOWN
CHECKED:	DATE:	SHEET OF SHEETS
BBD	11/08	1 OF 1

TRAFFIC SIGNAL INVENTORY DIAGRAM
DIVISADERO AND HAYES

CNN NO.	26053000
REV. NO.	2

EXTERNAL REFERENCES:
FONT(S) USED:

SCALE FACTOR:
PLOT SCALE:

ORIGIN: Special Projects

FILE NAME:
DATE: