

Caltrans
Metric

DIST	COUNTY	ROUTE	KILOMETER POST TOTAL PROJECT	SHEET NO.	TOTAL SHEETS
04	SF	101	10.8/12.9	46	61

Kenneth Y. Xu 4-2-04
REGISTERED ELECTRICAL ENGINEER

8-9-04
FLAME APPROVAL DATE

THE STATE OF CALIFORNIA OR ITS OFFICERS OR AGENTS SHALL NOT BE RESPONSIBLE FOR THE ACCURACY OR COMPLETENESS OF ELECTRONIC COPIES OF THIS PLAN SHEET.

Caltrans now has a web site! To get to the web site go to <http://www.dot.ca.gov>

[illegible]

* OTHER REQUIREMENTS ARE COVERED BY NOTES, LEGEND, SPECIAL PROVISIONS, AND STANDARD SPECIFICATION.
FOR TYPE OF STANDARD, VEHICLE AND PEDESTRIAN SIGNAL MOUNTING. SEE STANDARD PLANS.

MODIFY SIGNAL AND LIGHTING
(CONDUCTOR, POLE AND EQUIPMENT SCHEDULES)
LOCATION 11

E-23


THIS PLAN IS ACCURATE FOR ELECTRICAL WORK ONLY

ALL DIMENSIONS ARE IN
METERS UNLESS OTHERWISE SHOWN


```
USERNAME => trm1tzi
```

LAST REVISION: 03-18-04 DATE PUBLISHED => 10-AUG-2004
TIME TED => 13:43

2-78

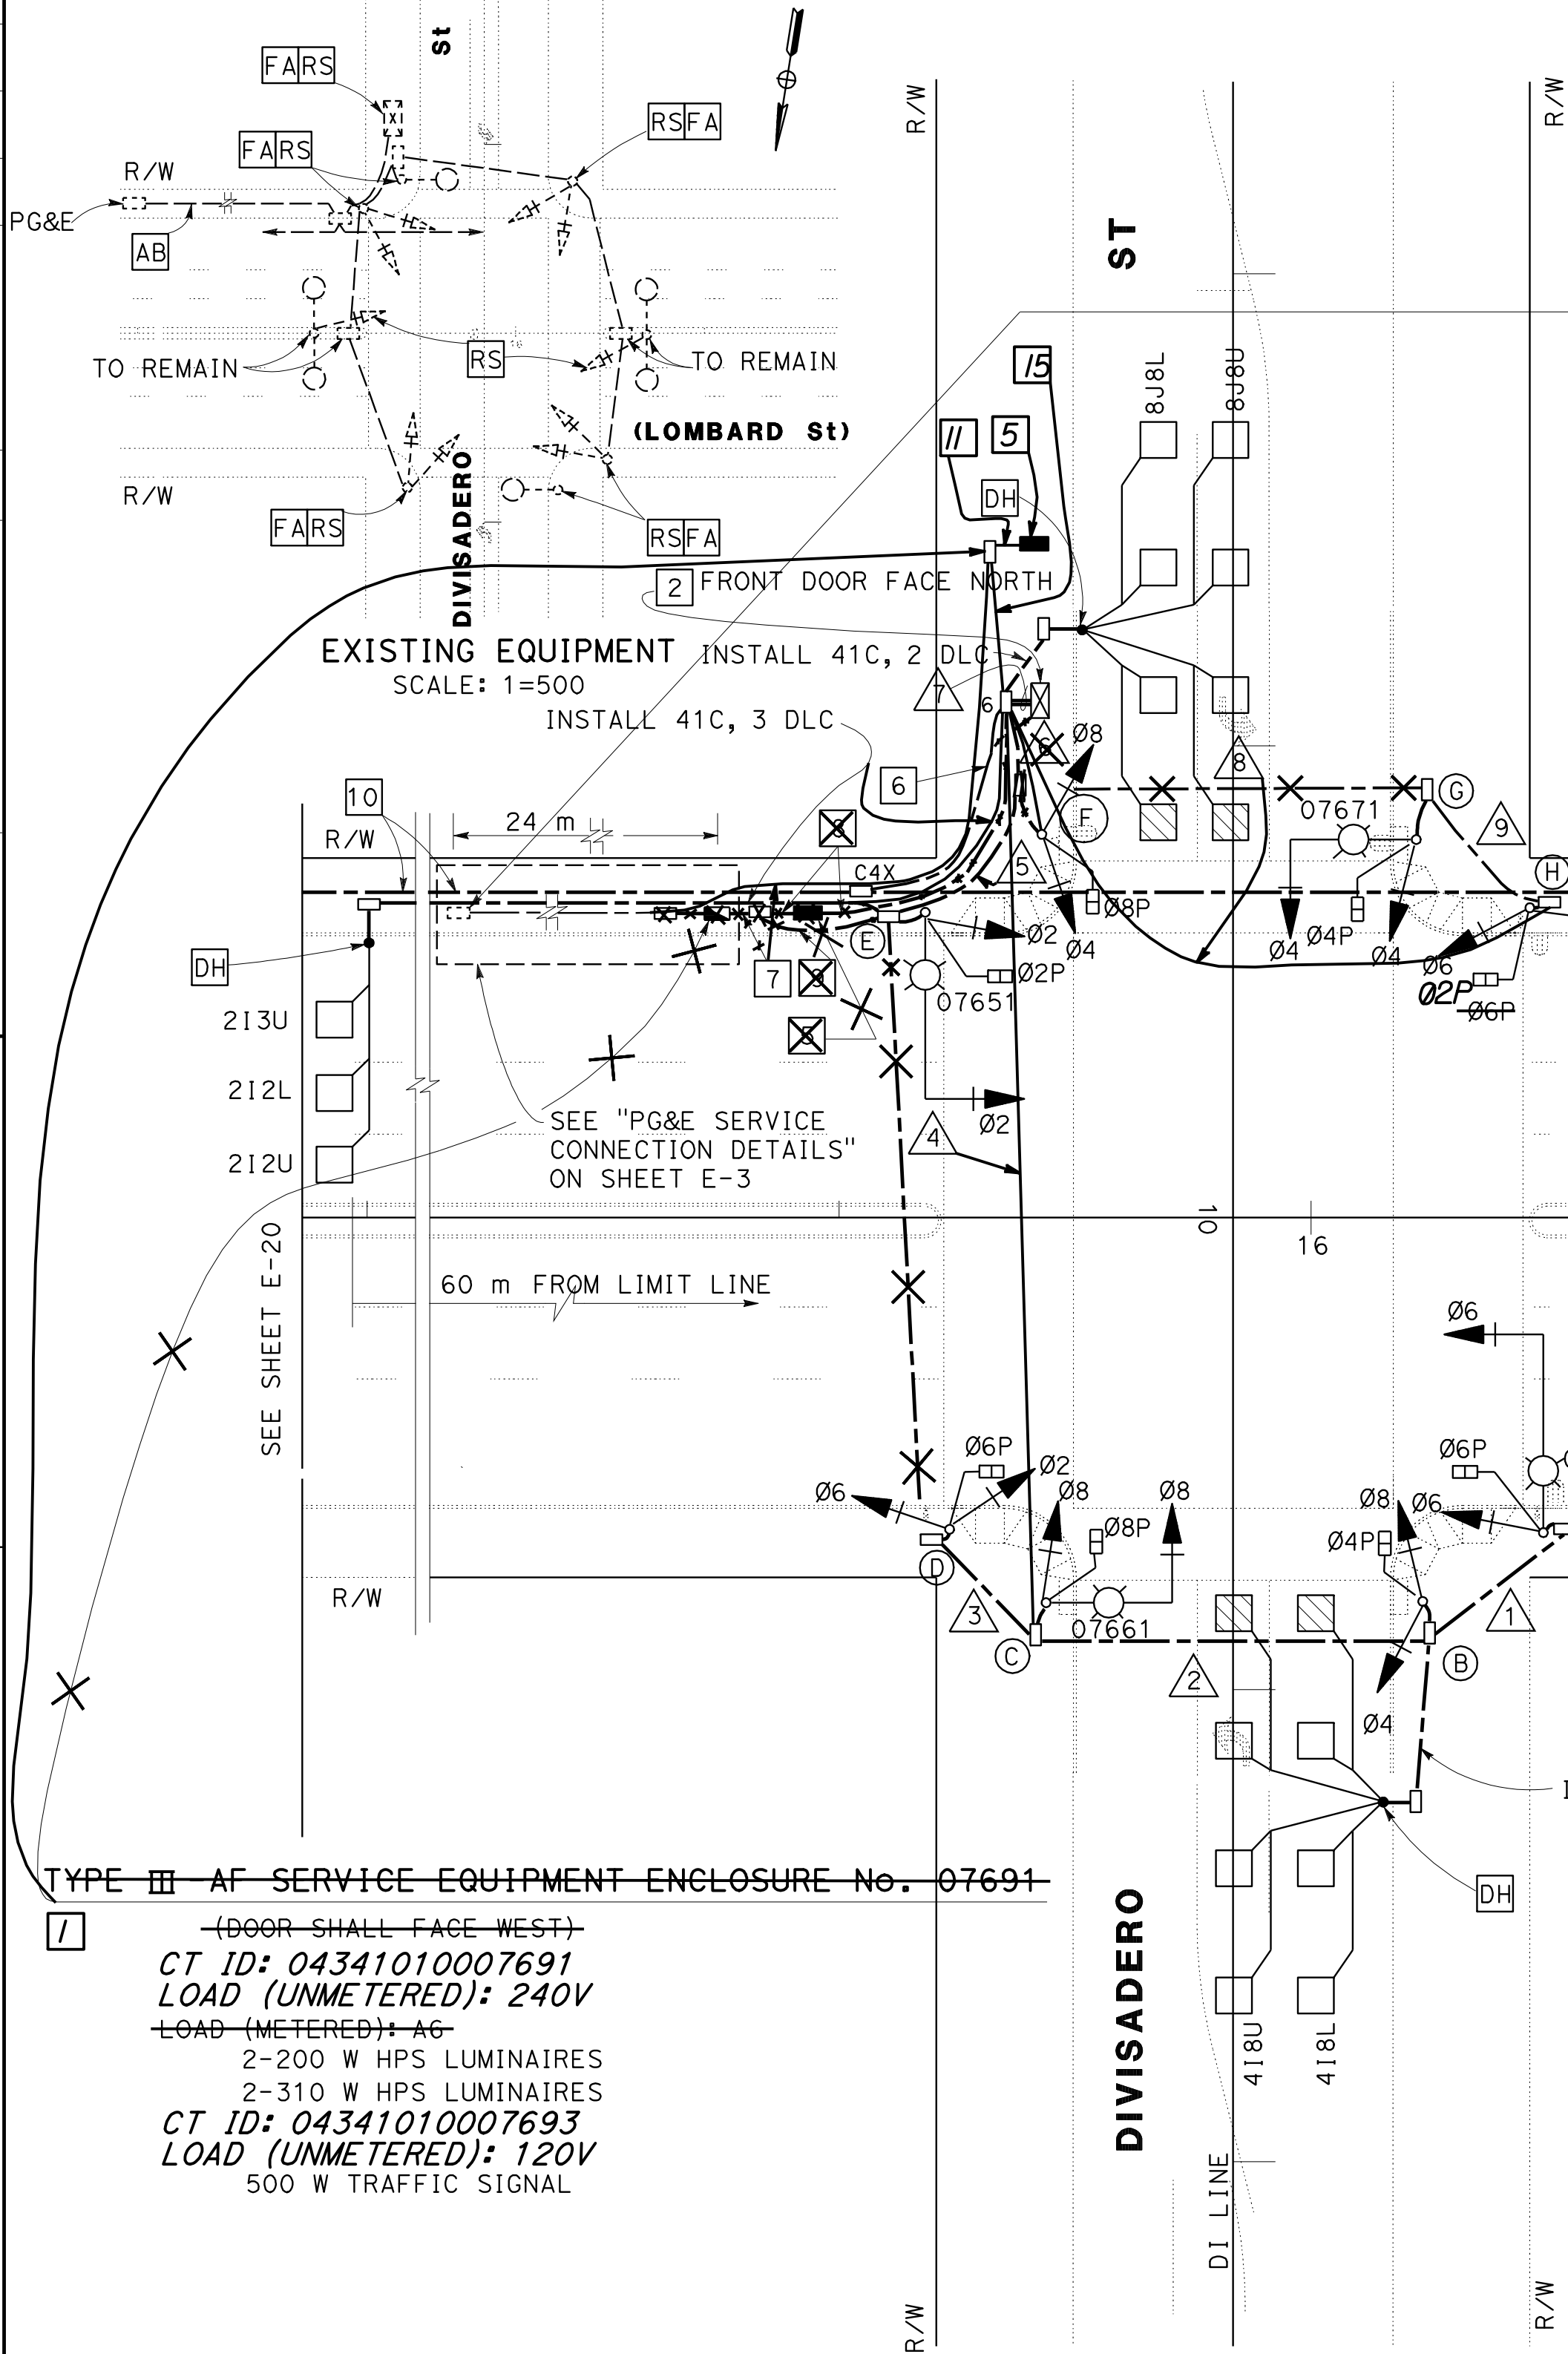

SYSTEM No. 34-101-07691 (PG&E)
UNDERGROUND SERVICE (120/240 V)
SYSTEM No. 34-101-07693 (PG&E)
UNDERGROUND SERVICE (120V)

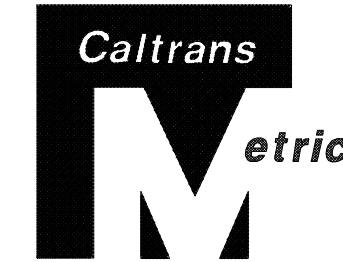


DIST	COUNTY	ROUTE	KILOMETER POST TOTAL PROJECT	SHEET No	TOTAL SHEETS
04	SF	101	10.8/12.9	45	61

REGISTERED ELECTRICAL ENGINEER

8-9-04
PLANS APPROVAL DATE

The State of California or its officers or agents shall not be responsible for the accuracy or completeness of electronic copies of this plan sheet.

Caltrans now has a web site! To get to the web site, go to: <http://www.dot.ca.gov>

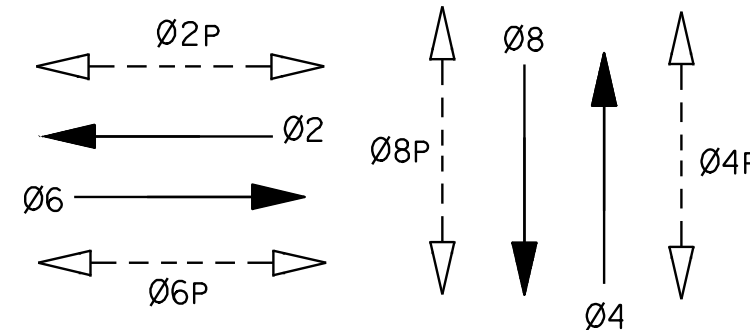

PHASE DIAGRAM

ROUTE 101 (LOMBARD ST)

EXISTING EQUIPMENT TO BE REMOVED AND SALVAGED

- 4 CITY CONCRETE POLE (SIMILAR TYPE 1-A)
- 2 CITY TYPE D CONCRETE STREET LIGHT STANDARD AND LUMINAIRE
- 4 TYPE TV-2-T SIGNAL HEAD MOUNTING
- 2 TYPE SV-1-T SIGNAL HEAD MOUNTING
- 1 TYPE "M" INTERSECTION CONTROLLER ASSEMBLY

- AB ALL CONDUITS AND CONDUCTORS RELATED TO EXISTING TRAFFIC SIGNAL SYSTEM EXCEPT AS NOTED
- RC ALL PULL BOXES RELATED TO EXISTING TRAFFIC SIGNAL SYSTEM EXCEPT AS NOTED
- AB EXISTING INTERCONNECTION CABLE (sic)

Resident Engineer Responsible for Construction Changes

CONTRACT No.	04-171204
DATE ACCEPTED	12/20/06
AS BUILT	
RESIDENT ENGINEER	F Duan
SIGNATURE	12/12/07
CHECKED BY	R.L. DATE 04/08

MODIFY SIGNAL AND LIGHTING LOCATION 11

ROUTE 101 (LOMBARD St./DIVISADERO St)
SCALE 1:200

THIS PLAN IS ACCURATE FOR ELECTRICAL WORK ONLY

ALL DIMENSIONS ARE IN METERS UNLESS OTHERWISE SHOWN

FOR REDUCED PLANS ORIGINAL SCALE IS IN MILLIMETERS

0 20 40 60 80

USERNAME => s117499
DGN FILE => 417120U022.asb

CU 04220

EA 171201

