


O'FARRELL & DIVISADERO

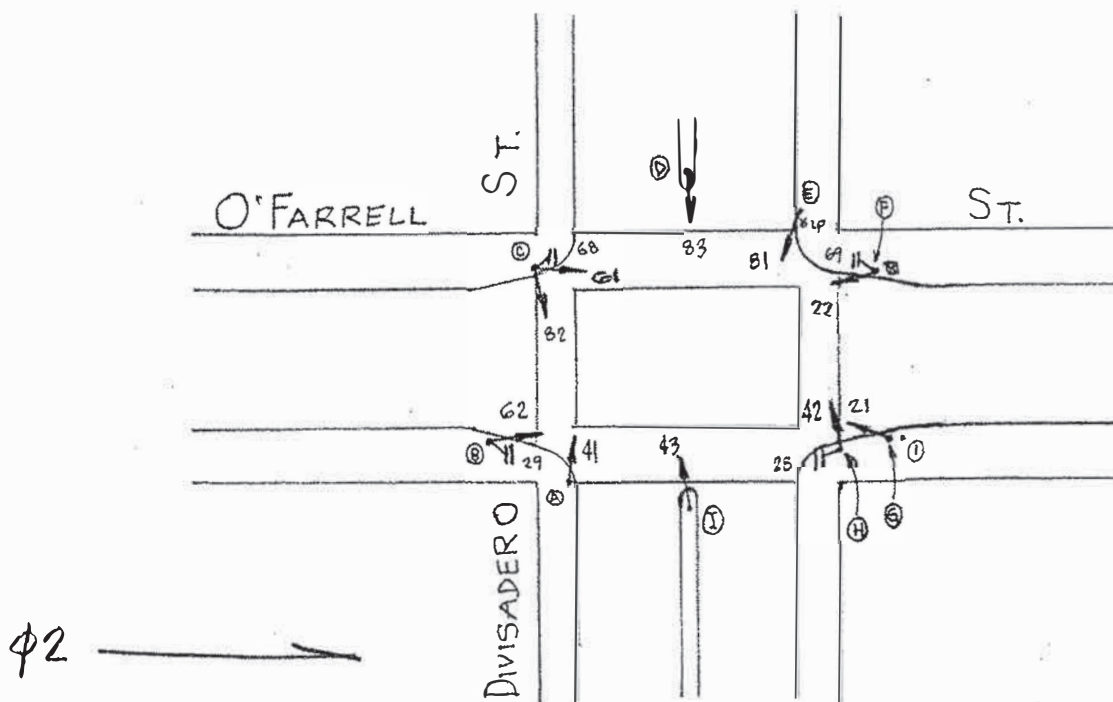

1-17-2020

POLE	FUNC.	MAT'L	SIGNAL NO.	MAKE	NO. OF SECT.	SIZE	VISOR	B.P. OR LOUVERS	MOUNT	PED SIGNAL NO.	LEGEND	MESSAGE		MAKE	MOUNT
												ELEMENT	COLOR		
A	S	S	41	EC	3	12"	T	NO	T	29	DI	IS-1	W/OR	ICC	S
B	S	S	62	EC	3	12"	T	NO	T	68	DI	IS-1	W/OR	ICC	S
C	L	C	82	EC	3	12"	T	NO	S	69	DI	IS-1	W/OR	ICC	S
D	L	C	61	EC	3	12"	T	NO	S	28	DI	IS-1	W/OR	ICC	S
E	S	S	83	EC	3	12"	T	NO	S						
F	S	S	81	EC	3	12"	T	NO	T						
G	S	S	22	EC	3	12"	T	NO	T						
H	L	C	21	EC	3	12"	T	NO	T						
I	L	C	42	EC	3	12"	T	NO	S						
			43	EC	3	12"	T	NO	S						
I	U	W													

CONTROLLER CABINET SIZE : ORDINARY BASE CABINET: YES

COMMENTS :

SRC 2019-414: REPLACE ALL SIGNAL HEADS TO 3S12"
C.SKERRIT (1/17/2020)