


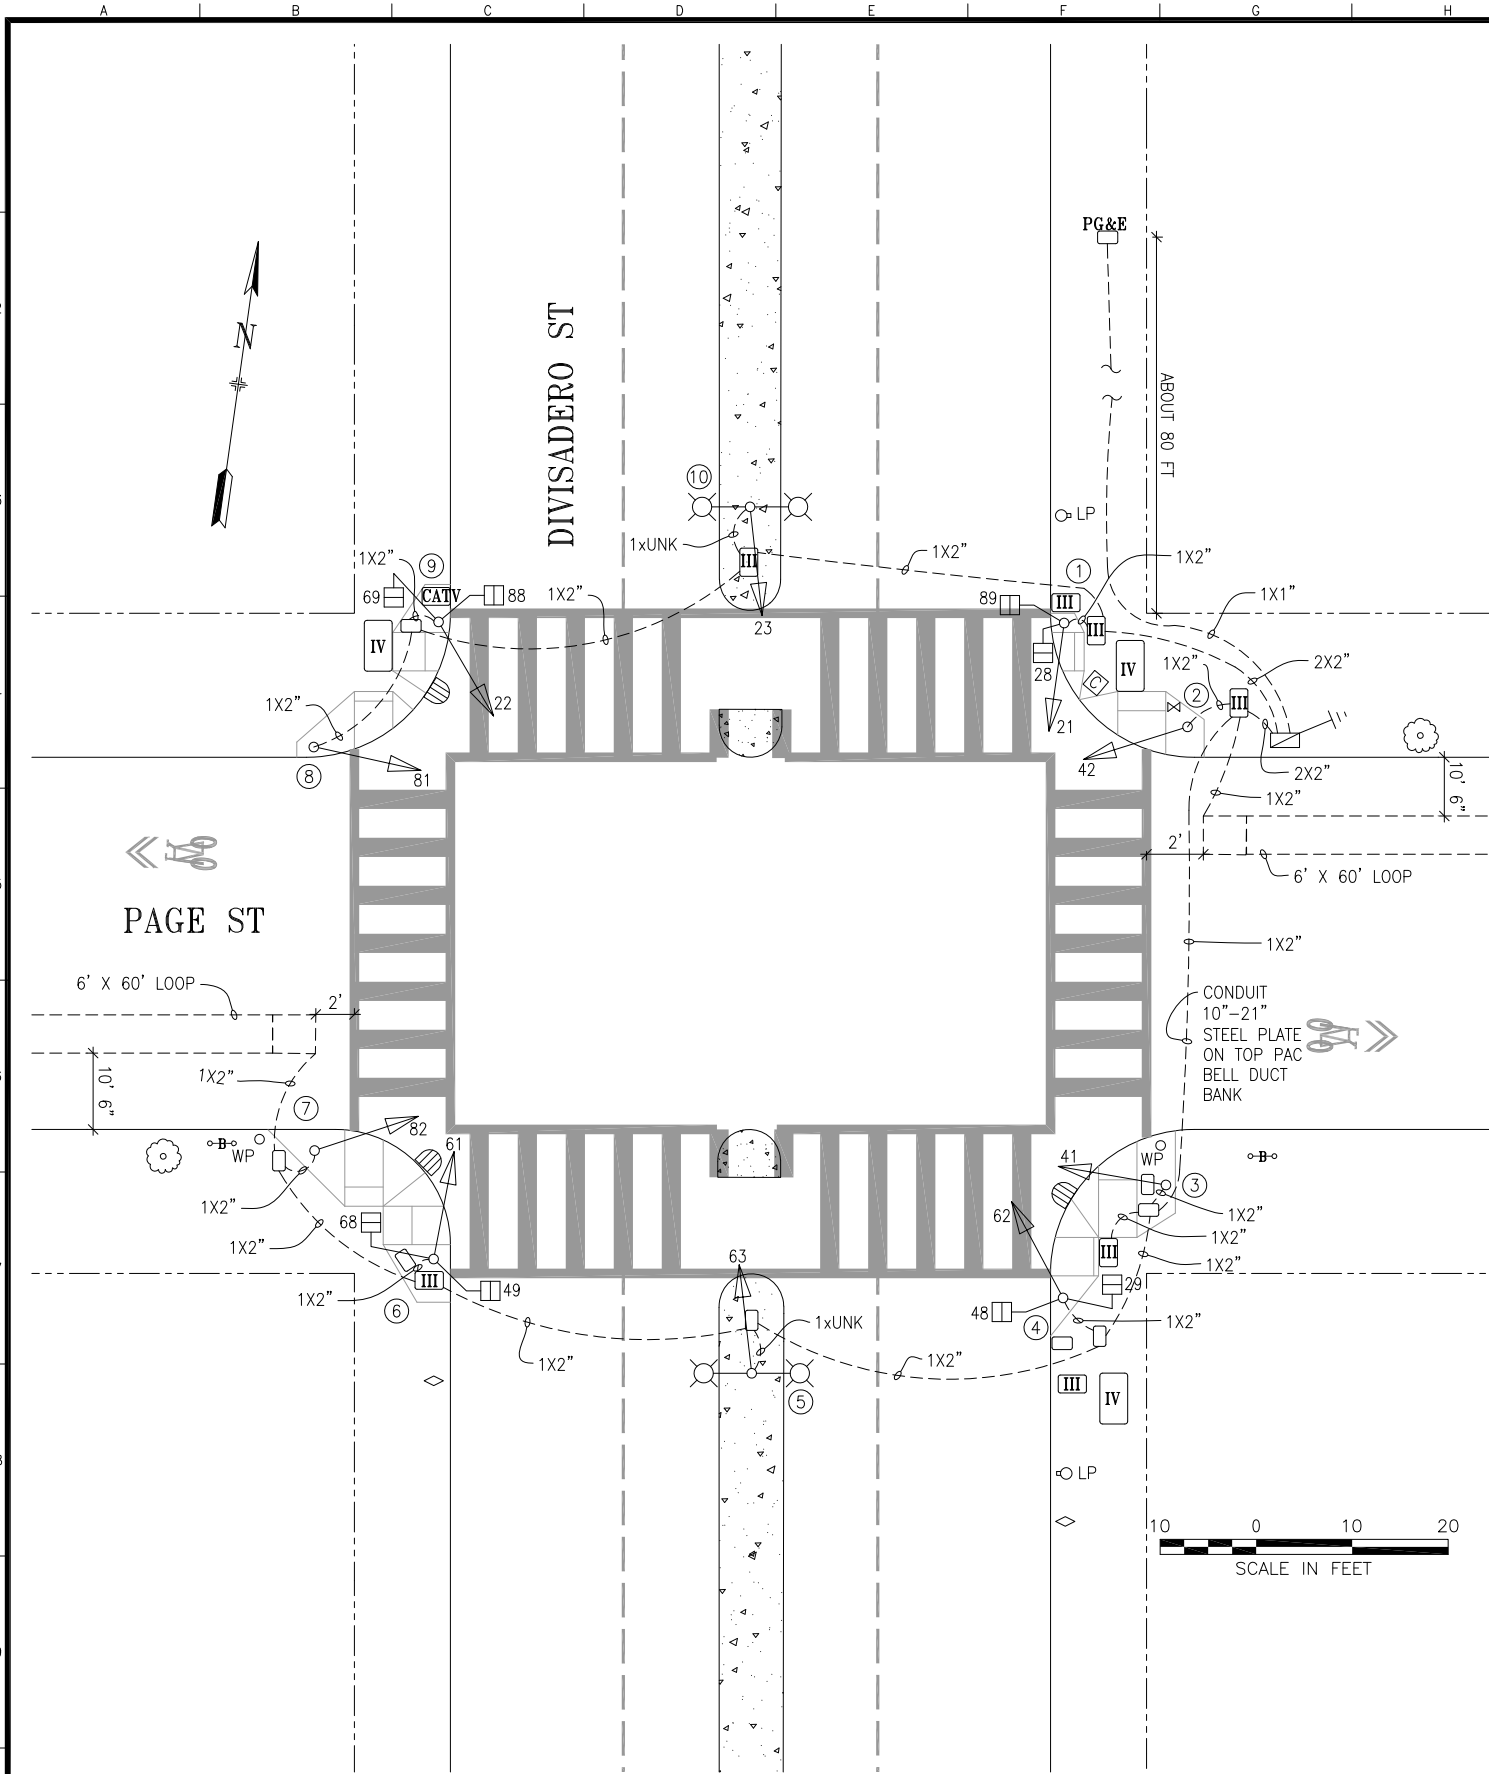

POLE AND EQUIPMENT SCHEDULE											
POLE No.	TYPE OF POLE	LUMINAIRE VOLTAGE/ WATTAGE	VEHICLE SIGNAL					PEDESTRIAN SIGNAL			REMARKS
			No.	TYPE	MOUNTING	VISORS	LOUVERS	No.	TYPE	MOUNTING	
①	1-A (10')		21	3S12"	TV-1-T	T		28 89	1S-COUNT 1S-COUNT	SP-1 SP-1	
②	1-A (10')		42	3S12"	TV-1-T	T					
③	1-A (10')		41	3S12"	TV-1-T	T					
④	1-A (10')		62	3S12"	TV-1-T	T		29 48	1S-COUNT 1S-COUNT	SP-1 SP-1	
⑤	MARBELITE SL W/ DUAL 6" LA		63	3S12"	SV-1-T	T					
⑥	1-A (10')		61	3S12"	TV-1-T	T		49 68	1S-COUNT 1S-COUNT	SP-1 SP-1	
⑦	1-A (10')		82	3S12"	TV-1-T	T					
⑧	1-A (10')		81	3S12"	TV-1-T	T					
⑨	1-A (10')		22	3S12"	TV-1-T	T		69 88	1S-COUNT 1S-COUNT	SP-1 SP-1	
⑩	MARBELITE SL W/ DUAL 6" LA		23	3S12"	SV-1-T	T					

TABLE OF REVISIONS				
NO.	DATE	DESCRIPTION	BY	APP.
3	11/2/19	SRC 2019-127 REPLACED ALL 8" SIGNAL HEADS WITH NEW 12" HEADS	S.SHWARTZ	G.HO
2	7/20/18	REMOVED MEDIAN PPBP PER SRC 2018-270	L.Humboldt	G.deLeon
1	9/10/15	ADDED PCS XING PAGE PER SRC 2015-211	A.Scales	M.Velasco
0	5/28/96	NEW SIGNAL ACTIVATED THROUGH 1019N; SID CONVERTED FROM AS-BUILTS	A.Scales	G.DeLeon

CHECK WITH TRACING TO SEE IF YOU HAVE LATEST REVISION

REFERENCE INFORMATION & FILE NO. OF SURVEYS	



SAN FRANCISCO MUNICIPAL TRANSPORTATION AGENCY

CITY AND COUNTY OF SAN FRANCISCO

DRAWN:	DATE:
A.SCALES	5/10/16
CHECKED:	DATE:
G.DELEON	5/10/16

SCALE:
AS SHOWN
SHEET OF SHEETS
1 OF 1

TRAFFIC SIGNAL INVENTORY DIAGRAM
DIVISADERO STREET AND PAGE STREET

CNN NO.
26029000
REV NO.
3