


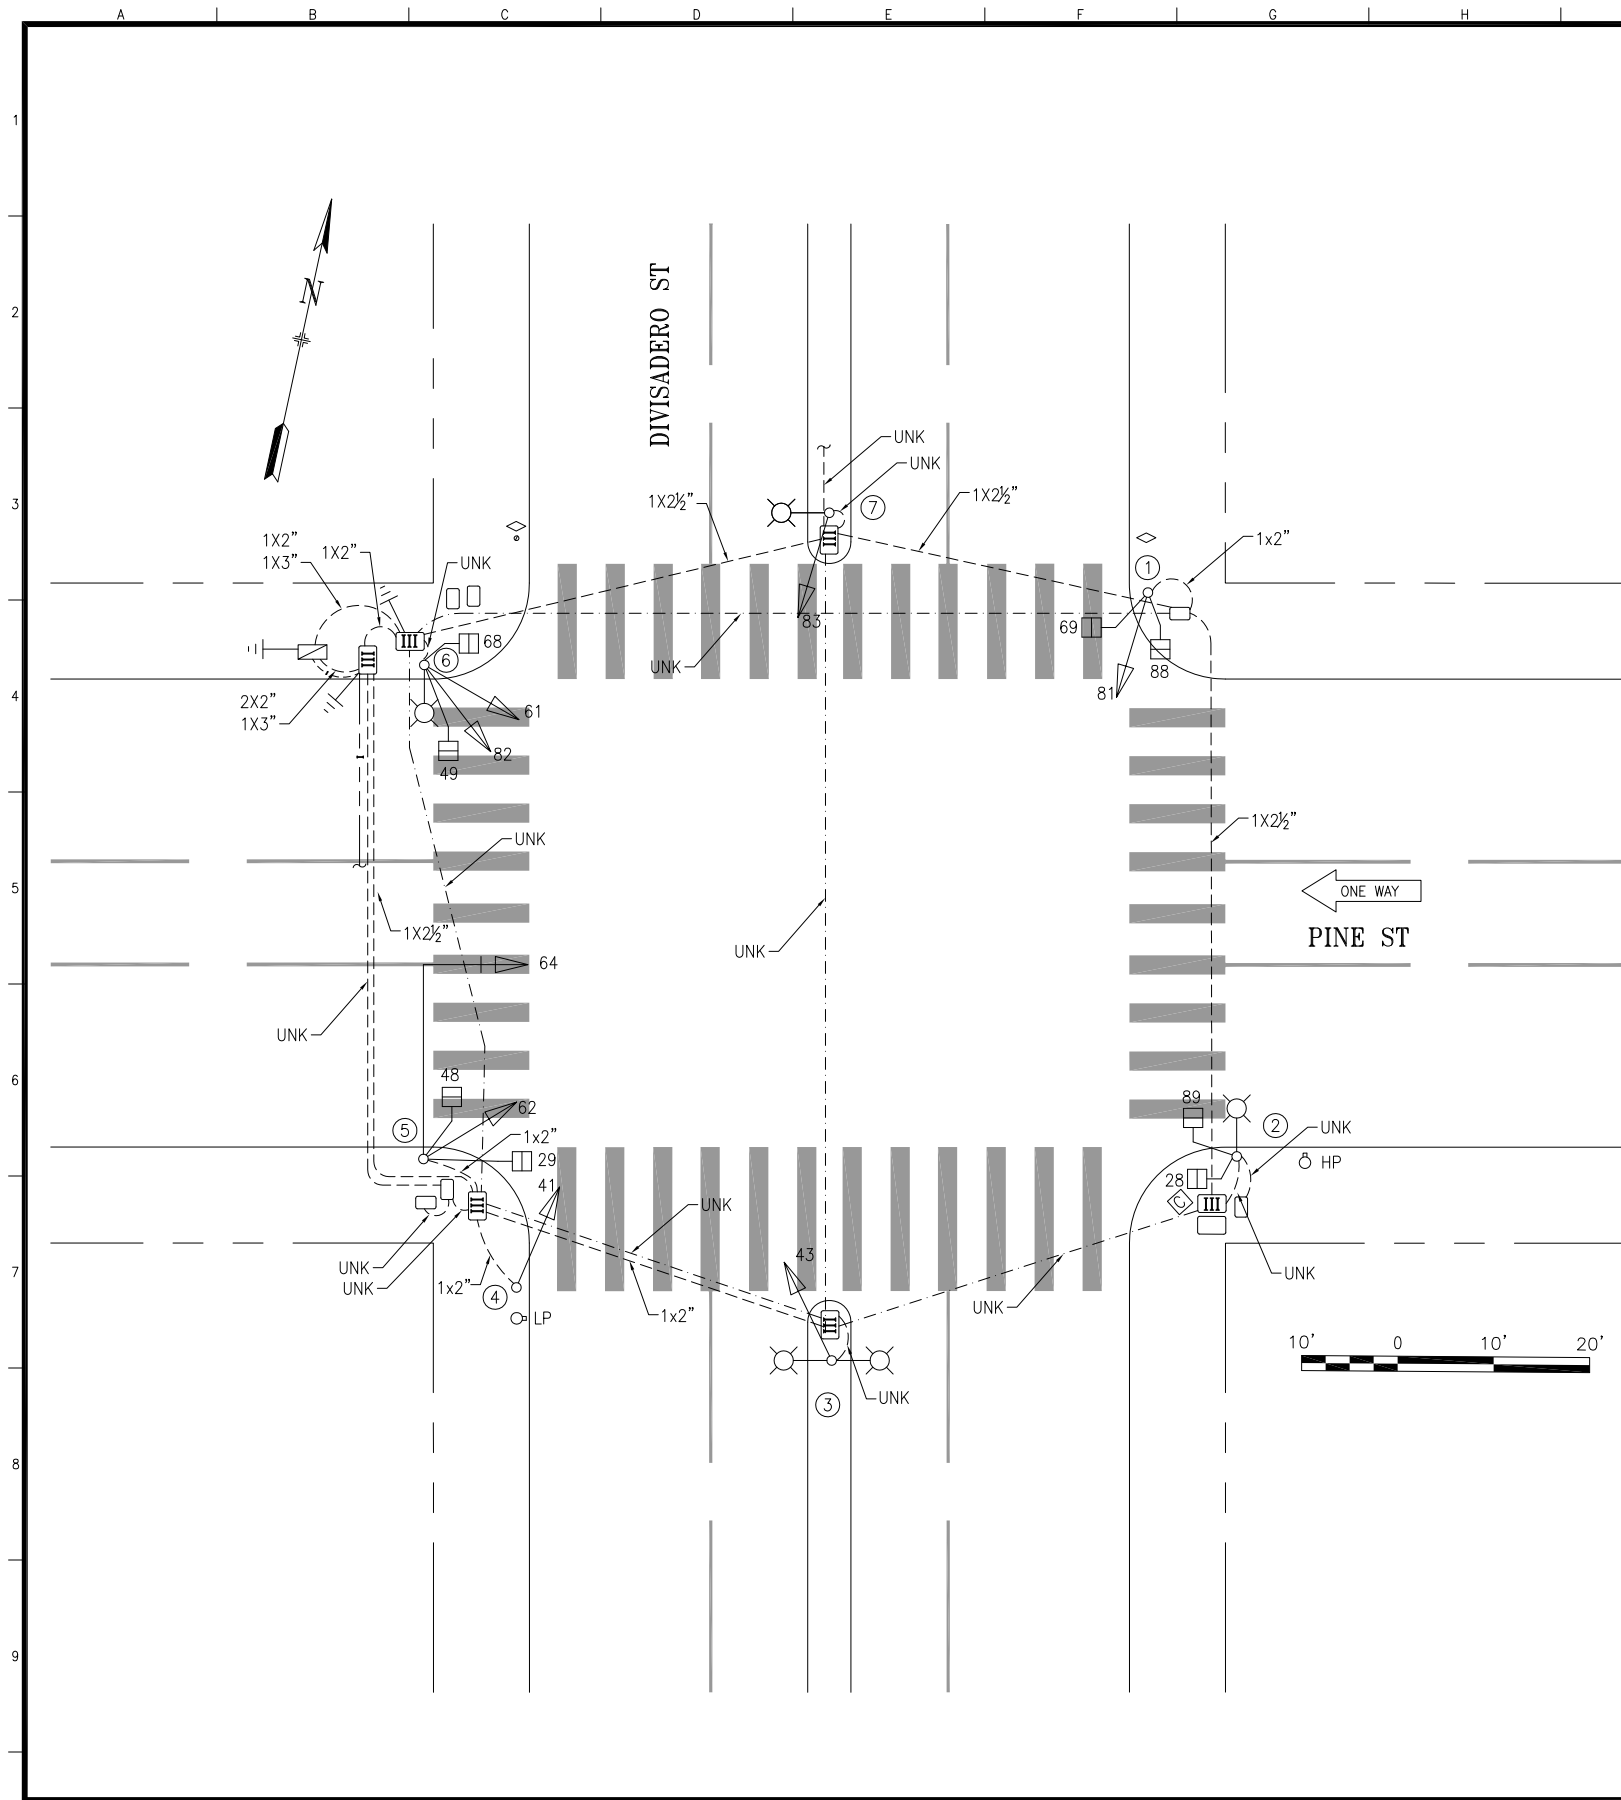

POLE AND EQUIPMENT SCHEDULE										
POLE No.	TYPE OF POLE	VEHICLE SIGNAL					PEDESTRIAN SIGNAL			REMARKS
		No.	TYPE	MOUNTING	VISORS	LOUVERS	No.	TYPE	MOUNTING	
①	1-A (10')	81	3S12"	TV-1-T	T		69 88	1S-COUNT 1S-COUNT	SP-1 SP-1	
②	SL						28 89	1S-COUNT 1S-COUNT	SP-1 SP-1	
③	SL	43	3S12"	SV-1-T	T					
④	1-A (10')	41	3S12"	TV-1-T	T					
⑤	16-1-70 20' MAST ARM	64 62	3S12" 3S12"	MAS SV-1-T	T T		29 48	1S-COUNT 1S-COUNT	SP-1 SP-1	BACKPLATE
⑥	SL	61 82	3S12" 3S12"	SV-2-TC	T T		49 68	1S-COUNT 1S-COUNT	SP-1 SP-1	
⑦	SL	83	3S12"	SV-1-T	T					



1	12/29/15	UPGRADE ALL SIGNALS TO 12-INCH	DYeung	GDeLeon	
0	4/18/02	SIGNAL UPGRADE THRU 1986N; SID CONVERTED FROM CONTRACT PLANS	Svohra	MVelasco	
NO.	DATE	DESCRIPTION	BY	APP.	
TABLE OF REVISIONS					
CHECK WITH TRACING TO SEE IF YOU HAVE LATEST REVISION					

REFERENCE INFORMATION & FILE NO. OF SURVEYS



SAN FRANCISCO MUNICIPAL TRANSPORTATION AGENCY

CITY AND COUNTY OF SAN FRANCISCO

DRAWN:	DATE:
SVohra	11/2015
CHECKED:	DATE:
MVelasco	11/2015

SCALE:
AS SHOWN
SHEET OF SHEETS
1 OF 1

TRAFFIC SIGNAL INVENTORY DIAGRAM
DIVISADERO ST AND PINE ST

CNN NO.
26643000
REV NO.
1