


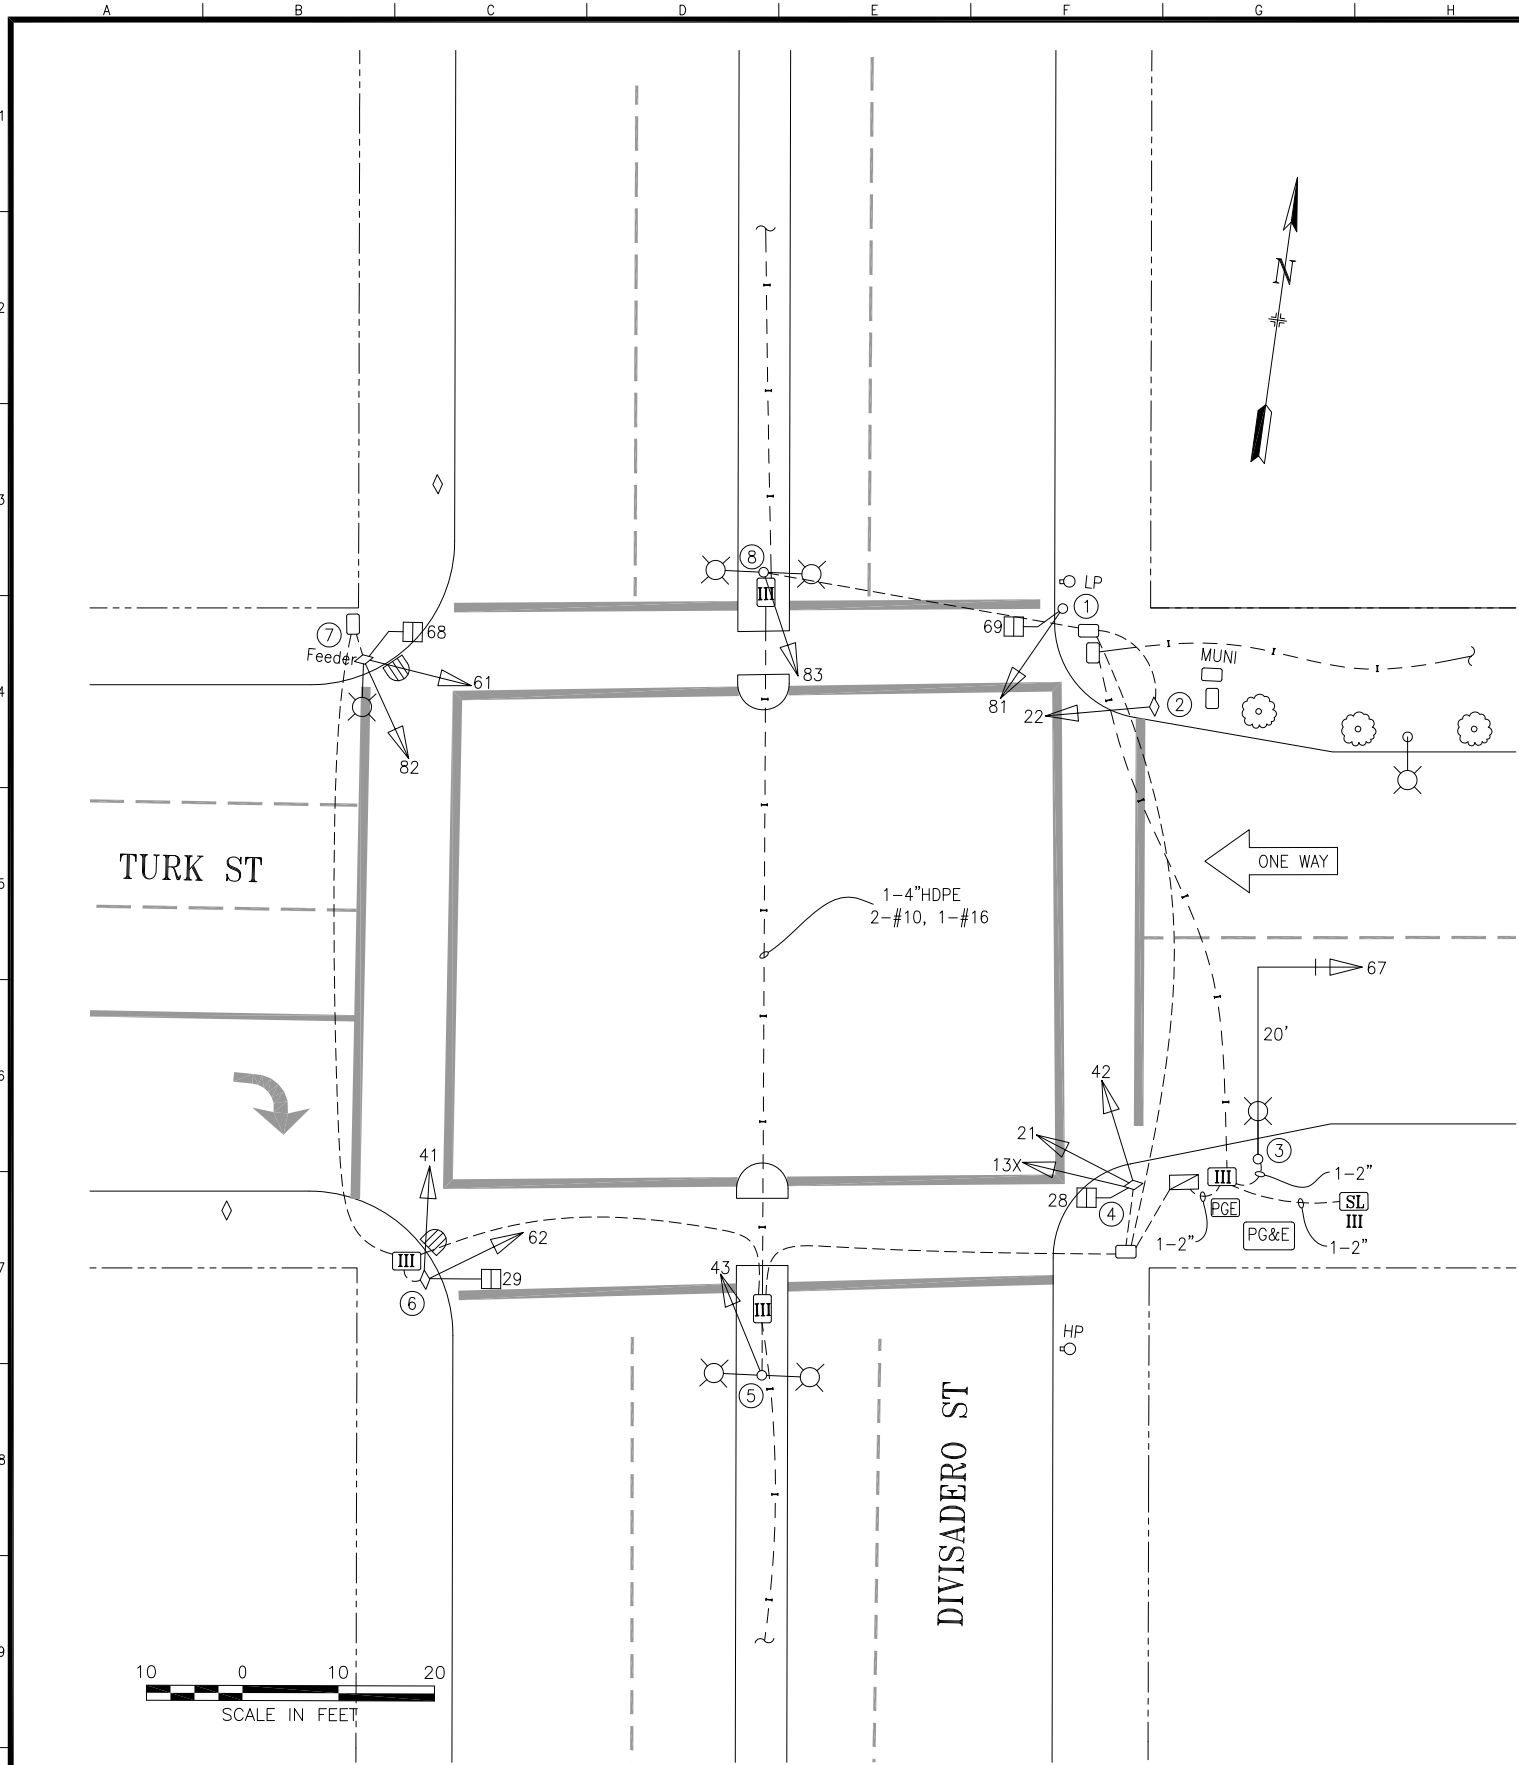

POLE AND EQUIPMENT SCHEDULE											
POLE No.	TYPE OF POLE	LUMINAIRE VOLTAGE/WATTAGE	VEHICLE SIGNAL					PEDESTRIAN SIGNAL			REMARKS
			No.	TYPE	MOUNTING	VISORS	LOUVERS	No.	TYPE	MOUNTING	
①	EXISTING 10' MARBELITE POLE		81	3S12"	TV-1-T	T		69	1S-COUNT	SP-1	
②	EXISTING MUNI POLE		22	3S12"RYY	SV-1-T	T					EXTERNAL CONDUIT
③	19-1-100 WITH 20' MAST ARM & 6" LUMINAIRE	120V 150W	67	3S12"	MAS	T					BACKPLATE
④	EXISTING MUNI POLE		21 42 13X	3S12" 3S12"RYY 1S12"GX	SV-2-T SV-1	T T T		28	1S-COUNT	SP-1-T	
⑤	EX MARBELITE SL W/ DUAL LUMINAIRE ARMS		43	3S12"	SV-1-T	T					
⑥	EXISTING MUNI POLE		41 62	3S12" 3S12"	SV-1-T SV-1-T-SF SEE DETAIL BELOW	T T		29	1S-COUNT	SP-1	MOUNT 41 AT 10', MOUNT 62 AT 13', 45°, W/ 36" NIPPLES
⑦	EXISTING MUNI POLE		61 82	3S12" 3S12"	SV-2-T	T T		68	1S-COUNT	SP-1	SPECIAL CONDUIT BTWN VEH AND PED SIGNAL
⑧	EX MARBELITE SL W/ DUAL LUMINAIRE ARMS		83	3S12"	SV-1-T	T					

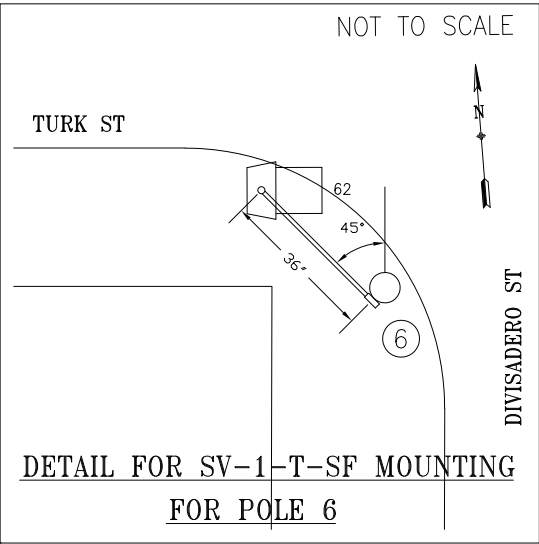


TABLE OF REVISIONS			
NO.	DATE	DESCRIPTION	BY APP.
1	12/04/19	SRC 2019-127 REPLACED ALL 8" SIGNAL HEADS WITH NEW 12" SIGNAL HEADS	S.SHARIATI G.HO
0	7/3/14	MOD ACTIVATED THRU 2108J; CONVERTED FROM CONTRACT PLANS	J.HORN M.VELASOZ
CHECK WITH TRACING TO SEE IF YOU HAVE LATEST REVISION			



SAN FRANCISCO MUNICIPAL TRANSPORTATION AGENCY

CITY AND COUNTY OF SAN FRANCISCO

DRAWN: J.HORN	DATE: 09/2015	SCALE: AS SHOWN	TRAFFIC SIGNAL INVENTORY DIAGRAM	CNN NO. 26077000
CHECKED: M.VELAS	DATE: 09/2015	SHEET OF SHEETS 1 OF 1	DIVISADERO STREET AND TURK STREET	REV NO.