


DRUMM & WASHINGTON

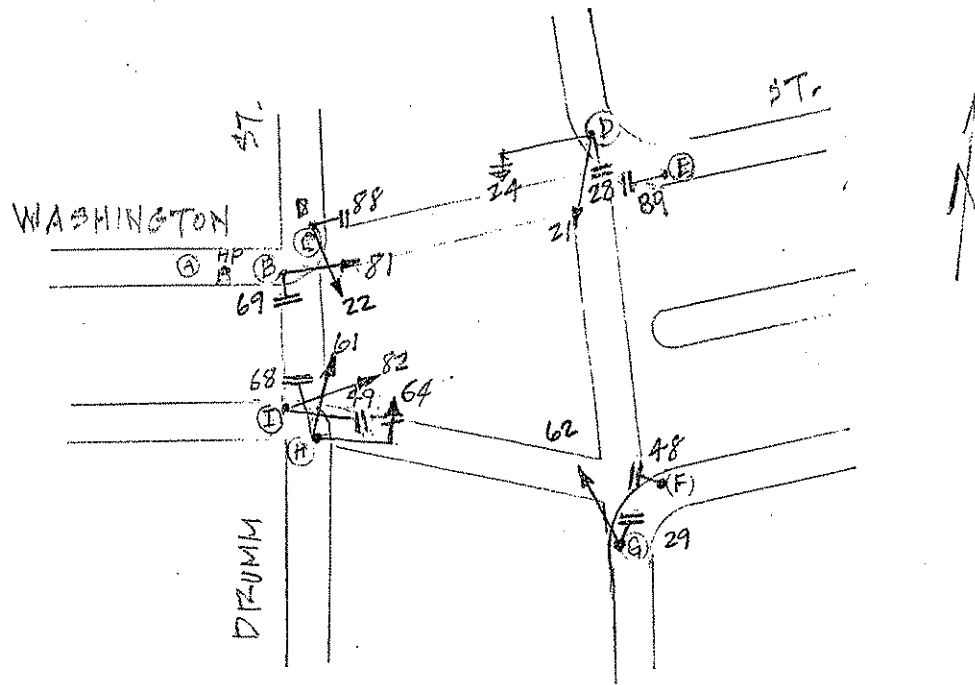

3-16-07

POLE	FUNC	MAT'L	SIGNAL NO.	MAKE	NO. OF SECT.	SIZE	VISOR	B.P. OR LOUVERS	MOUNT	PED SIGNAL NO.	LEGEND	MESSAGE		MAKE	MOUNT
												ELEMENT	COLOR		
A	L	S	81	TCT	3	8"	FC8"	NO	T	69	I	IS-1	W/O	ICC	S
B	S	S	22	TCT	3	8"	FC8"	NO	T	88	I	IS-1	W/O	ICC	S
C	S	S	24	TCT	3	12"	FC12"	BP	MAT	89	I	IS-1	W/O	ICC	S
D	L	S	21	EA	3	12"	FC12"	NO	S	48	I	IS-1	W/O	ICC	S
E	L	S	61	EA	3	12"	FC12"	NO	S	29	I	IS-1	W/O	ICC	S
F	L	S	64	TCT	3	12"	FC12"	BP	MAT	68	I	IS-1	W/O	ICC	S
G	L	S	82	TCT	3	8"	FC8"	NO	T	28	I	IS-1	W/O	ICC	S
H	L	S	62	TCT	3	8"	FC8"	NO	S	49	I	IS-1	W/O	ICC	S
I	S	S													

CONTROLLER CABINET SIZE : Ordinary BASE CABINET : Yes

COMMENTS : DELETE 65 AND 25 AND ADD 62 AND 22