


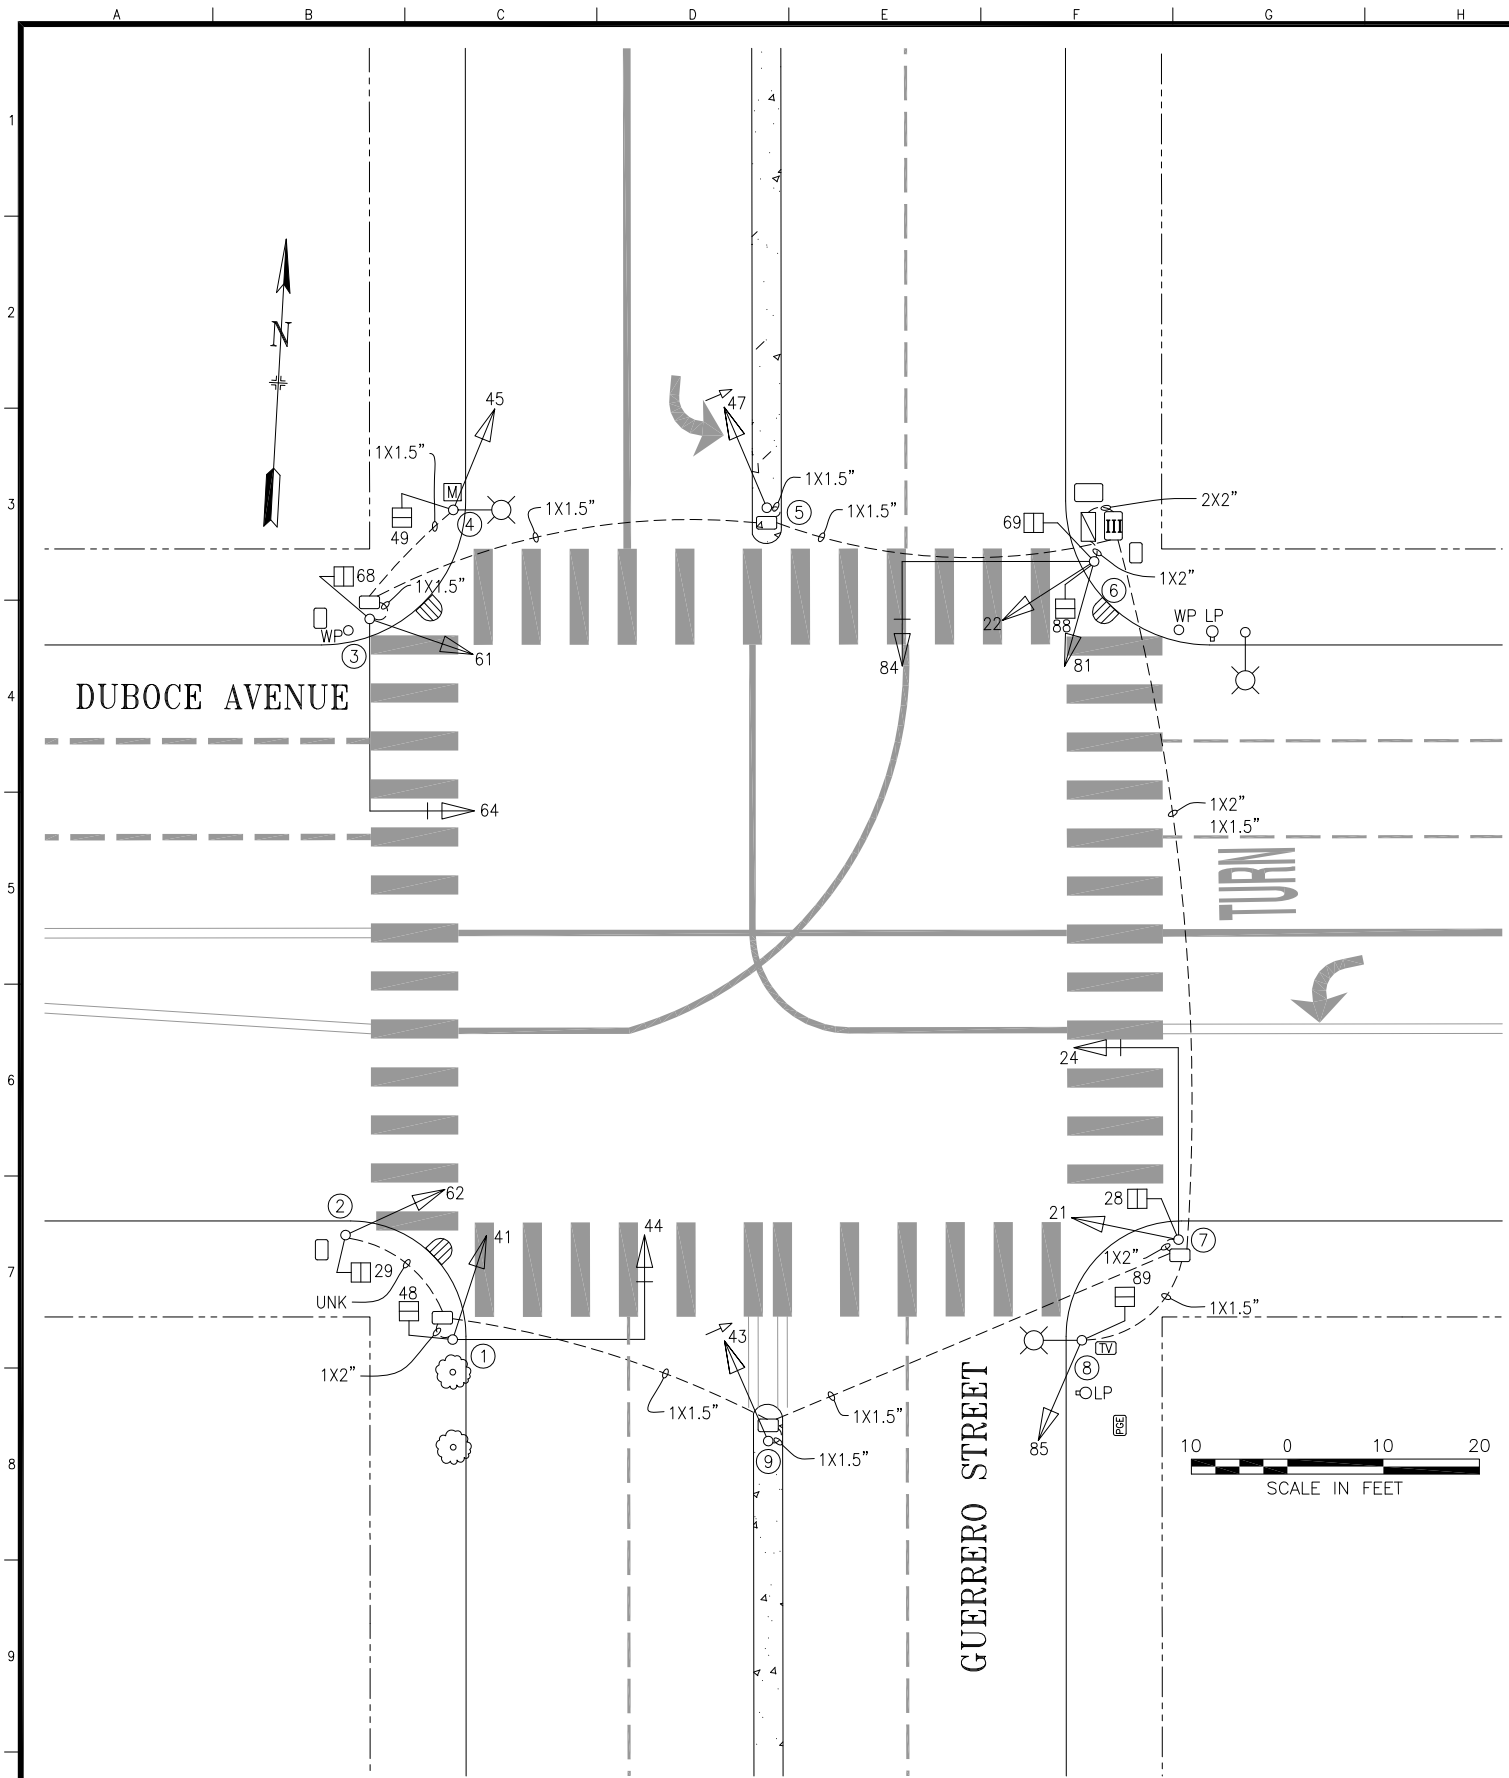

POLE AND EQUIPMENT SCHEDULE											
POLE No.	TYPE OF POLE	LUMINAIRE VOLTAGE/WATTAGE	VEHICLE SIGNAL					PEDESTRIAN SIGNAL			REMARKS
			No.	TYPE	MOUNTING	VISORS	LOUVERS	No.	TYPE	MOUNTING	
①	16-1-70 W/20' SIGNAL MAST ARM		41 44	3S12" 3S12"	SV-1-T MAS	T FC		48	1S-COUNT	SP-1	BACKPLATE
②	PEDESTAL STREET LIGHT POLE		62	3S12"	SV-1-T	T		29	1S-COUNT	SP-1	
③	16-1-70 W/20' SIGNAL MAST ARM		61 64	3S12" 3S12"	SV-1-T MAS	T FC		68	1S-COUNT	SP-1	BACKPLATE
④	PEDESTAL STREET LIGHT POLE		45	3S12"	SV-1-T	T		49	1S-COUNT	SP-1	
⑤	1-A (10')		47	3S12"LA	TV-1-T	T					
⑥	16-1-70 W/20' SIGNAL MAST ARM		84 81 22	3S12" 3S12" 3S12"	MAS SV-2-TA	FC T T		88 69	1S-COUNT 1S-COUNT	SP-1 SP-1	BACKPLATE
⑦	16-1-70 W/20' SIGNAL MAST ARM		21 24	3S12" 3S12"	SV-1-T MAS	T FC		28	1S-COUNT	SP-1	BACKPLATE
⑧	PEDESTAL STREET LIGHT POLE		85	3S12"	SV-1-T	T		89	1S-COUNT	SP-1	
⑨	1-A (10')		43	3S12"LA	TV-1-T	T					

0	8/04/2015	2543J PUNCHLIST WALKTHROUGH, UPGRADE TO 12", ADD PCS XING GUERRERO	DYeung	MVelasco	
NO.	DATE	DESCRIPTION	BY	APP.	
TABLE OF REVISIONS					
CHECK WITH TRACING TO SEE IF YOU HAVE LATEST REVISION					

REFERENCE INFORMATION & FILE NO. OF SURVEYS



SAN FRANCISCO MUNICIPAL TRANSPORTATION AGENCY
CITY AND COUNTY OF SAN FRANCISCO

DRAWN:	DATE:
AScales	12/2015
CHECKED:	DATE:
MVelasco	12/2015

SCALE:
AS SHOWN
SHEET OF SHEETS
1 OF 1

TRAFFIC SIGNAL INVENTORY DIAGRAM
DUBOCE AVENUE AND GUERRERO STREET

CNN NO.
25860000
REV NO.
0