


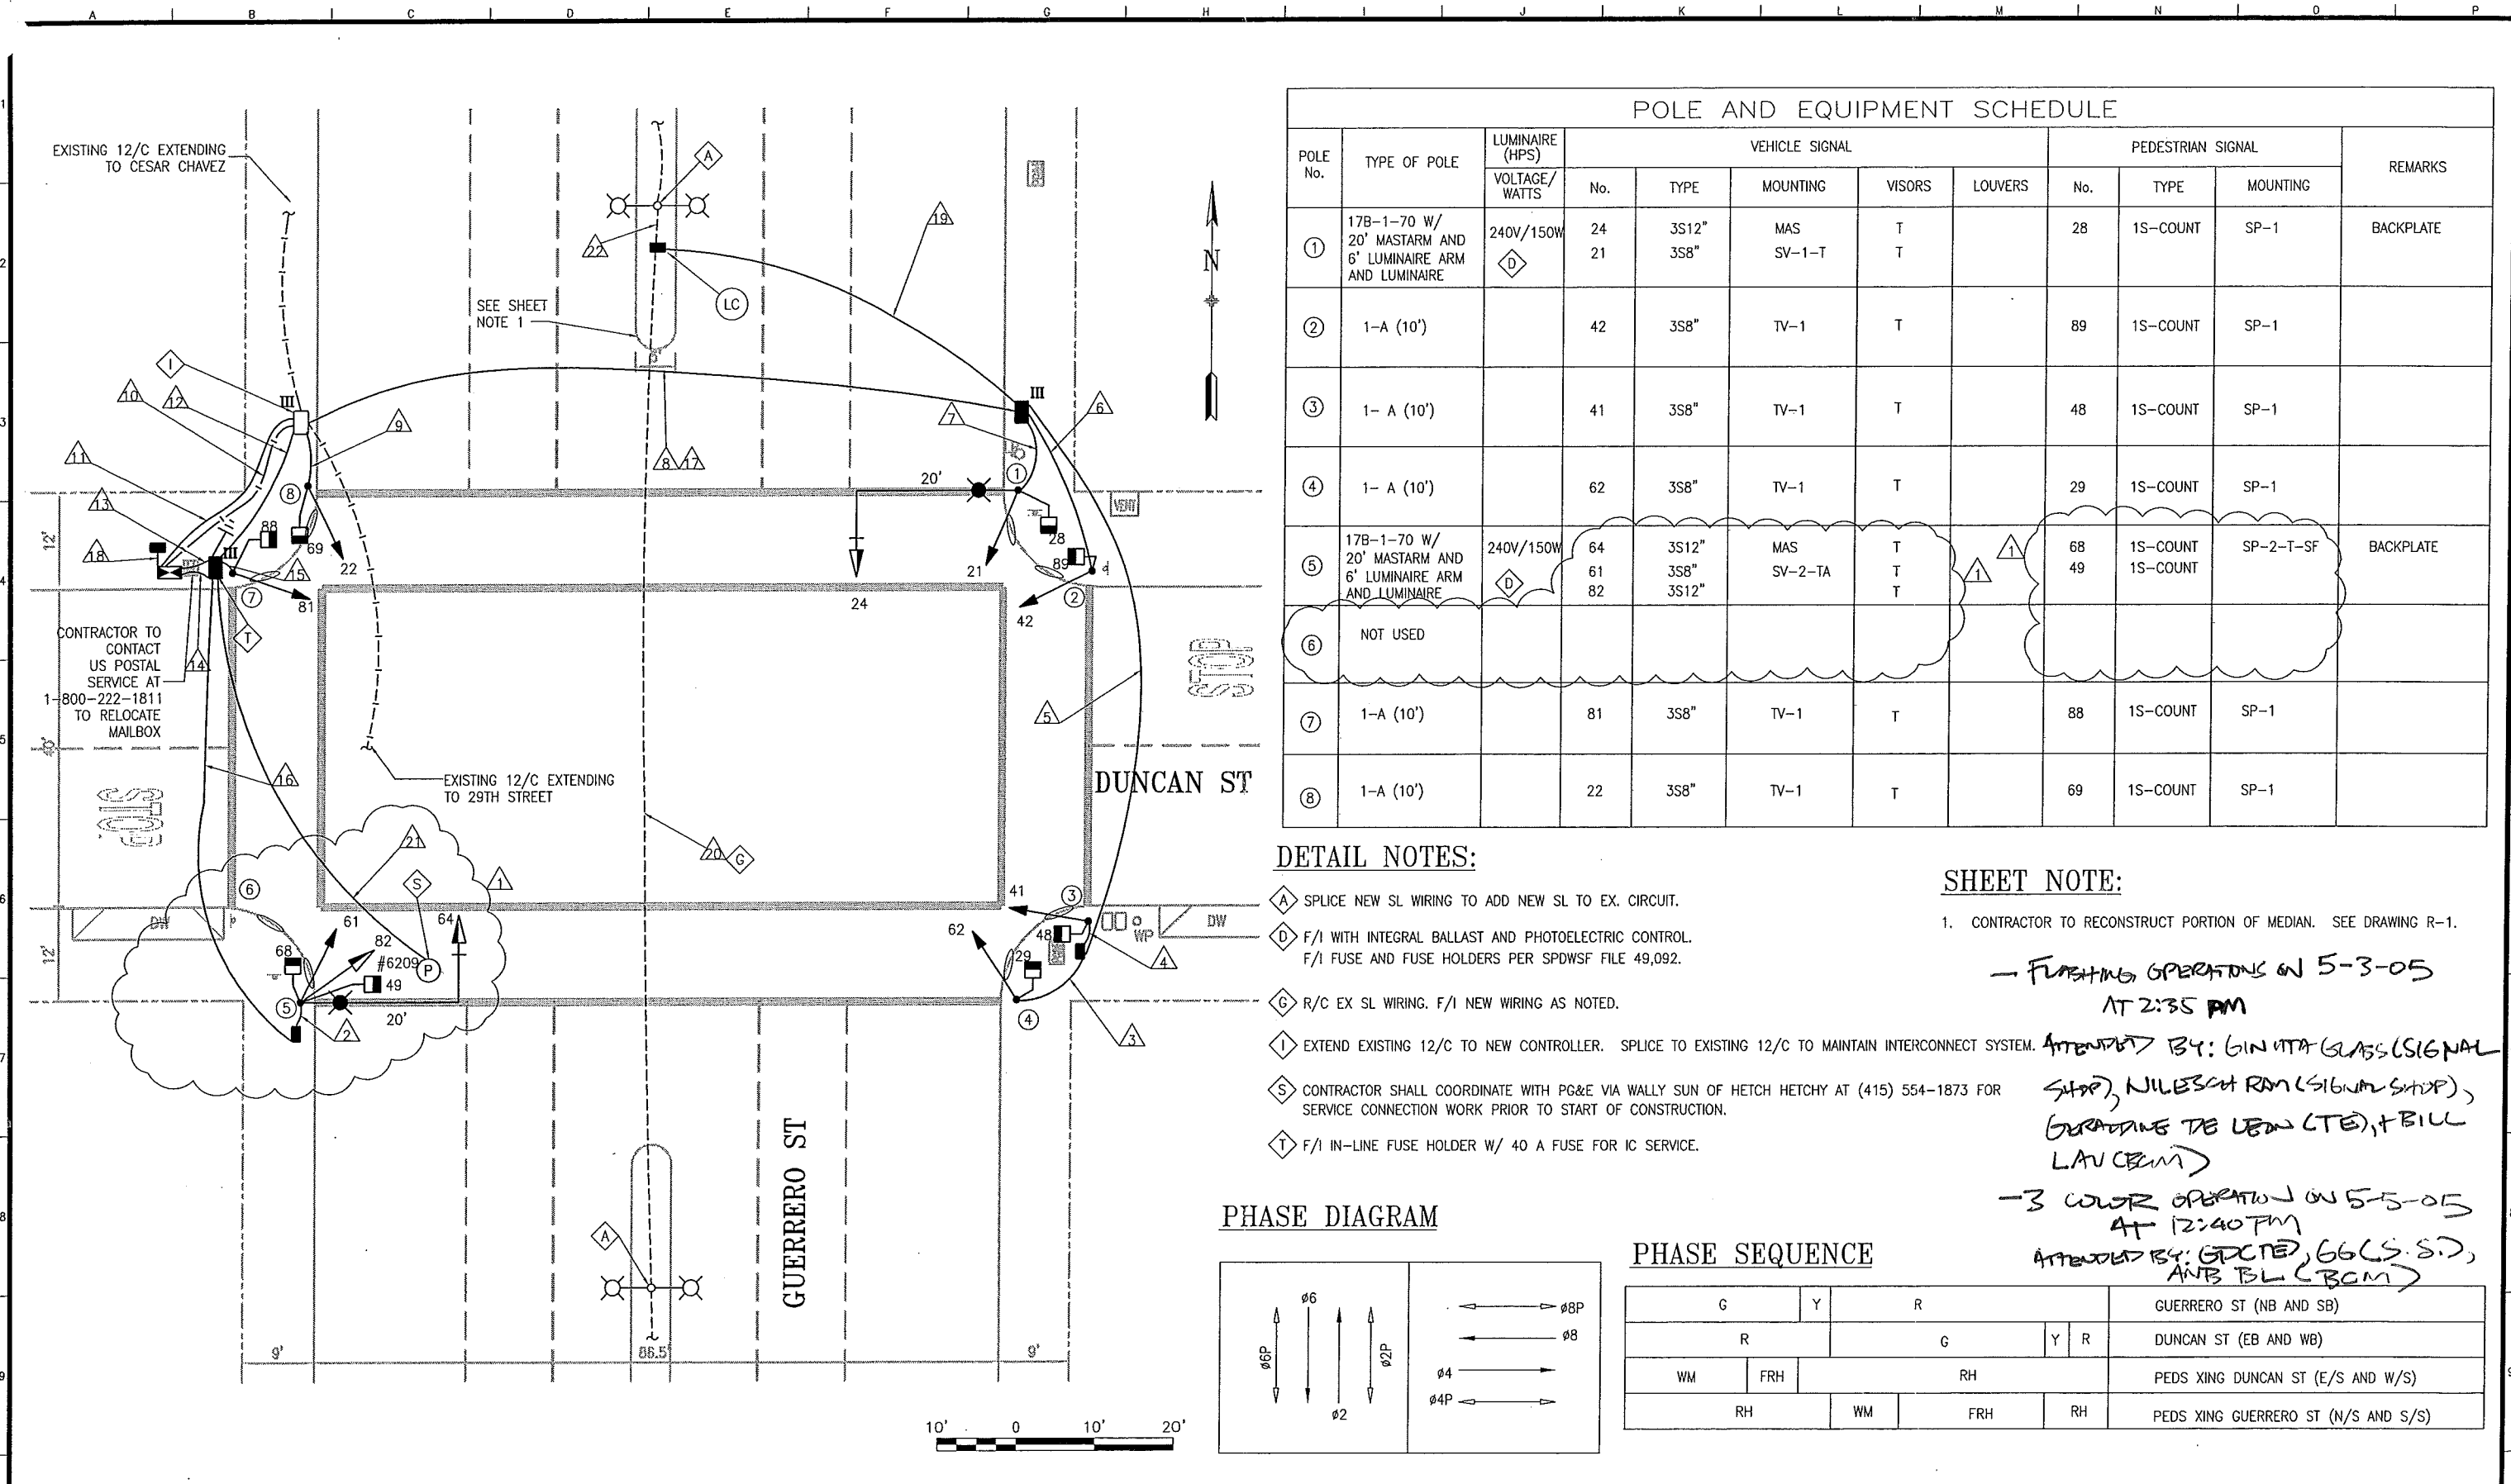

POLE AND EQUIPMENT SCHEDULE											
POLE No.	TYPE OF POLE	LUMINAIRE (HPS) VOLTAGE/ WATTS	VEHICLE SIGNAL					PEDESTRIAN SIGNAL			REMARKS
			No.	TYPE	MOUNTING	VISORS	LOUVERS	No.	TYPE	MOUNTING	
①	17B-1-70 W/ 20' MASTARM AND 6' LUMINAIRE ARM AND LUMINAIRE	240V/150W D	24	3S12"	MAS	T		28	1S-COUNT	SP-1	BACKPLATE
			21	3S8"	SV-1-T	T					
②	1-A (10')		42	3S8"	TV-1	T		89	1S-COUNT	SP-1	
③	1- A (10')		41	3S8"	TV-1	T		48	1S-COUNT	SP-1	
④	1- A (10')		62	3S8"	TV-1	T		29	1S-COUNT	SP-1	
⑤	17B-1-70 W/ 20' MASTARM AND 6' LUMINAIRE ARM AND LUMINAIRE	240V/150W D	64	3S12"	MAS	T		68	1S-COUNT	SP-2-T-SF	BACKPLATE
			61	3S8"	SV-2-TA	T		49	1S-COUNT		
			82	3S12"		T					
⑥	NOT USED										
⑦	1-A (10')		81	3S8"	TV-1	T		88	1S-COUNT	SP-1	
⑧	1-A (10')		22	3S8"	TV-1	T		69	1S-COUNT	SP-1	

DETAIL NOTES:


- A SPLICE NEW SL WIRING TO ADD NEW SL TO EX. CIRCUIT.
- D F/I WITH INTEGRAL BALLAST AND PHOTOELECTRIC CONTROL. F/I FUSE AND FUSE HOLDERS PER SPDWSF FILE 49,092.
- G R/C EX SL WIRING. F/I NEW WIRING AS NOTED.
- I EXTEND EXISTING 12/C TO NEW CONTROLLER. SPLICE TO EXISTING 12/C TO MAINTAIN INTERCONNECT SYSTEM.
- S CONTRACTOR SHALL COORDINATE WITH PG&E VIA WALLY SUN OF HETCH HETCHY AT (415) 554-1873 FOR SERVICE CONNECTION WORK PRIOR TO START OF CONSTRUCTION.
- T F/I IN-LINE FUSE HOLDER W/ 40 A FUSE FOR IC SERVICE.

SHEET NOTE:

1. CONTRACTOR TO RECONSTRUCT PORTION OF MEDIAN. SEE DRAWING R-1.

FLASHING OPERATIONS ON 5-3-05
AT 2:35 PM
ATTENDED BY: GINATA (SIGNAL SHOP), NILESCH RAM (SIGNAL SHOP), GUERRERO DE LEON (TE), BILL LAUCER (BM)
3 COLOR OPERATION ON 5-5-05
AT 12:40 PM
ATTENDED BY: GDC (TE), GG (S.S.), ANTB BL (BM)

PHASE DIAGRAM

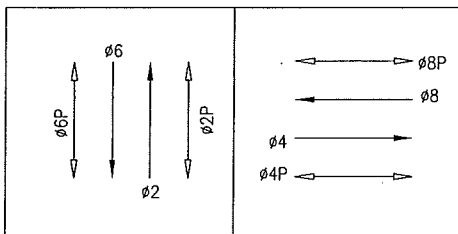

PHASE SEQUENCE

G	Y	R			GUERRERO ST (NB AND SB)
R		G	Y	R	DUNCAN ST (EB AND WB)
WM	FRH	RH			PEDS XING DUNCAN ST (E/S AND W/S)
RH		WM	FRH	RH	PEDS XING GUERRERO ST (N/S AND S/S)


NO.	DATE	DESCRIPTION	BY	APP.
1	01/05	DELETE POLE 6		BC
0	01/04	ISSUED FOR BID		

TABLE OF REVISIONS
CHECK WITH TRACING TO SEE IF YOU HAVE LATEST REVISION

REFERENCE INFORMATION
& FILE NO. OF SURVEYS



BUREAU OF ENGINEERING
DEPARTMENT OF PUBLIC WORKS
CITY AND COUNTY OF SAN FRANCISCO

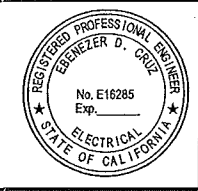

DESIGNED: DATE: 01/04
GD
DRAWN: DATE: 01/04
GD
CHECKED: DATE: 01/04
BC

APPROVED
SECTION MANAGER DATE:
DEPUTY BUREAU MANAGER DATE:
CITY ENGINEER DATE:

SCALE:
AS SHOWN
SHEET OF SHEETS

NEW TRAFFIC SIGNALS CONTRACT 56
DUNCAN AND GUERRERO STREETS
TRAFFIC SIGNAL WORK
AND POLE & EQUIPMENT SCHEDULE

SPECIFICATION NO. 0761J
DRAWING NO. E-1.0
FILE NO. 84,253
REV. NO. 1

Drawing Path: V:\0761J New Traffic Signals Contract 56\3 Construction Change Orders Drawings\0761J LED rev\PCO\Drawings\Signal\0761J Title Block.dwg
Plot Time: Wed, 09 Mar 2005 - 1:01pm
Model Units: Feet

