


2007 & FILLMORE STS

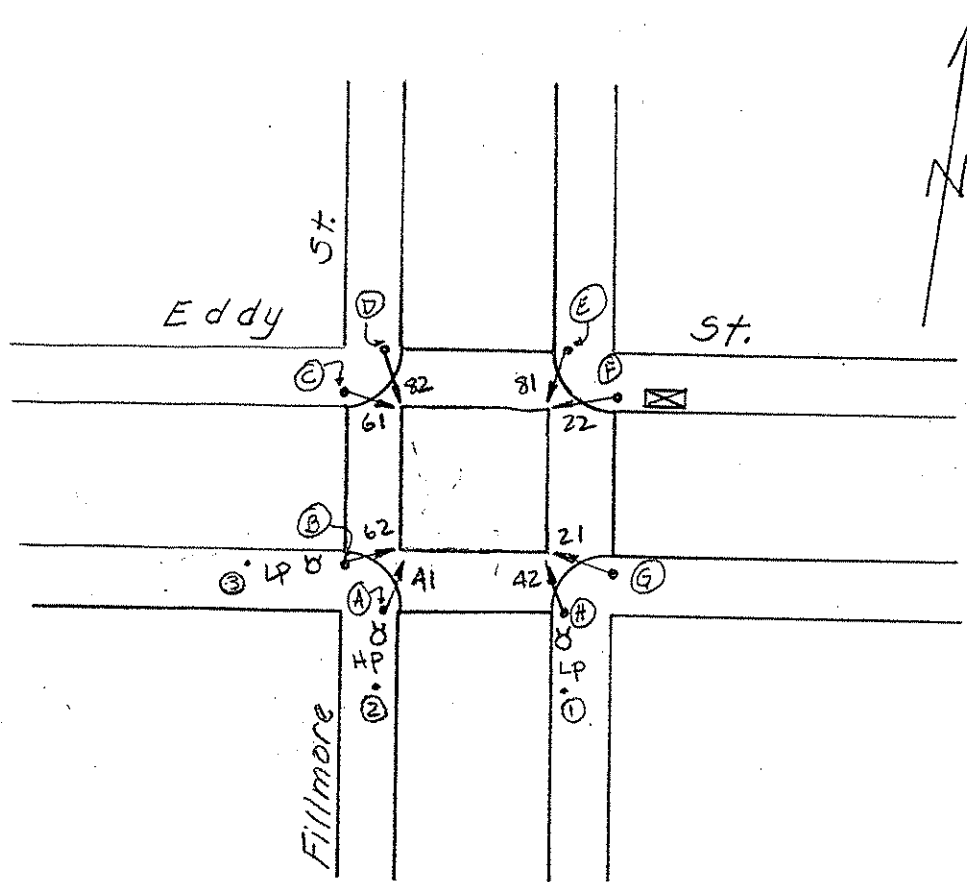

φ2 →

6-94

POLE	FUNC.	MAT'L	SIGNAL NO.	MAKE	NO. OF SECT.	SIZE	VISOR	B.P. OR LOUVERS	MOUN'T	PED SIGNAL NO.	LEGEND	MESSAGE		MAKE	MOUN'T
												ELEMENT	COLOR		
A	L	S	41	EC	3	8"	FC-8"	NO	S						
B	S	S	62	GA	3	8"	FC-8"	NO	S						
C	M	S	61	TCT	3	8"	FC-8"	NO	S						
D	M	S	82	TCT	3	8"	FC-8"	NO	S						
E	M	S	81	TCT	3	8"	FC-8"	NO	S						
F	M	S	22	TCT	3	8"	FC-8"	NO	S						
G	M	S	21	TCT	3	8"	FC-8"	NO	S						
H	U	S	42	EC	3	8"	FC-8"	NO	S						
1	M	S													
2	M	S													
3	M	S													

CONTROLLER CABINET SIZE : ORDINARY BASE CABINET : YES

COMMENTS : NEW MUNI POLES C, D, E, F & G AND NEW SIGNALS 61, 81, 22, 21 WERE INSTALLED UNDER CONTRACT MR 881 #31 BALBOA LINE.