


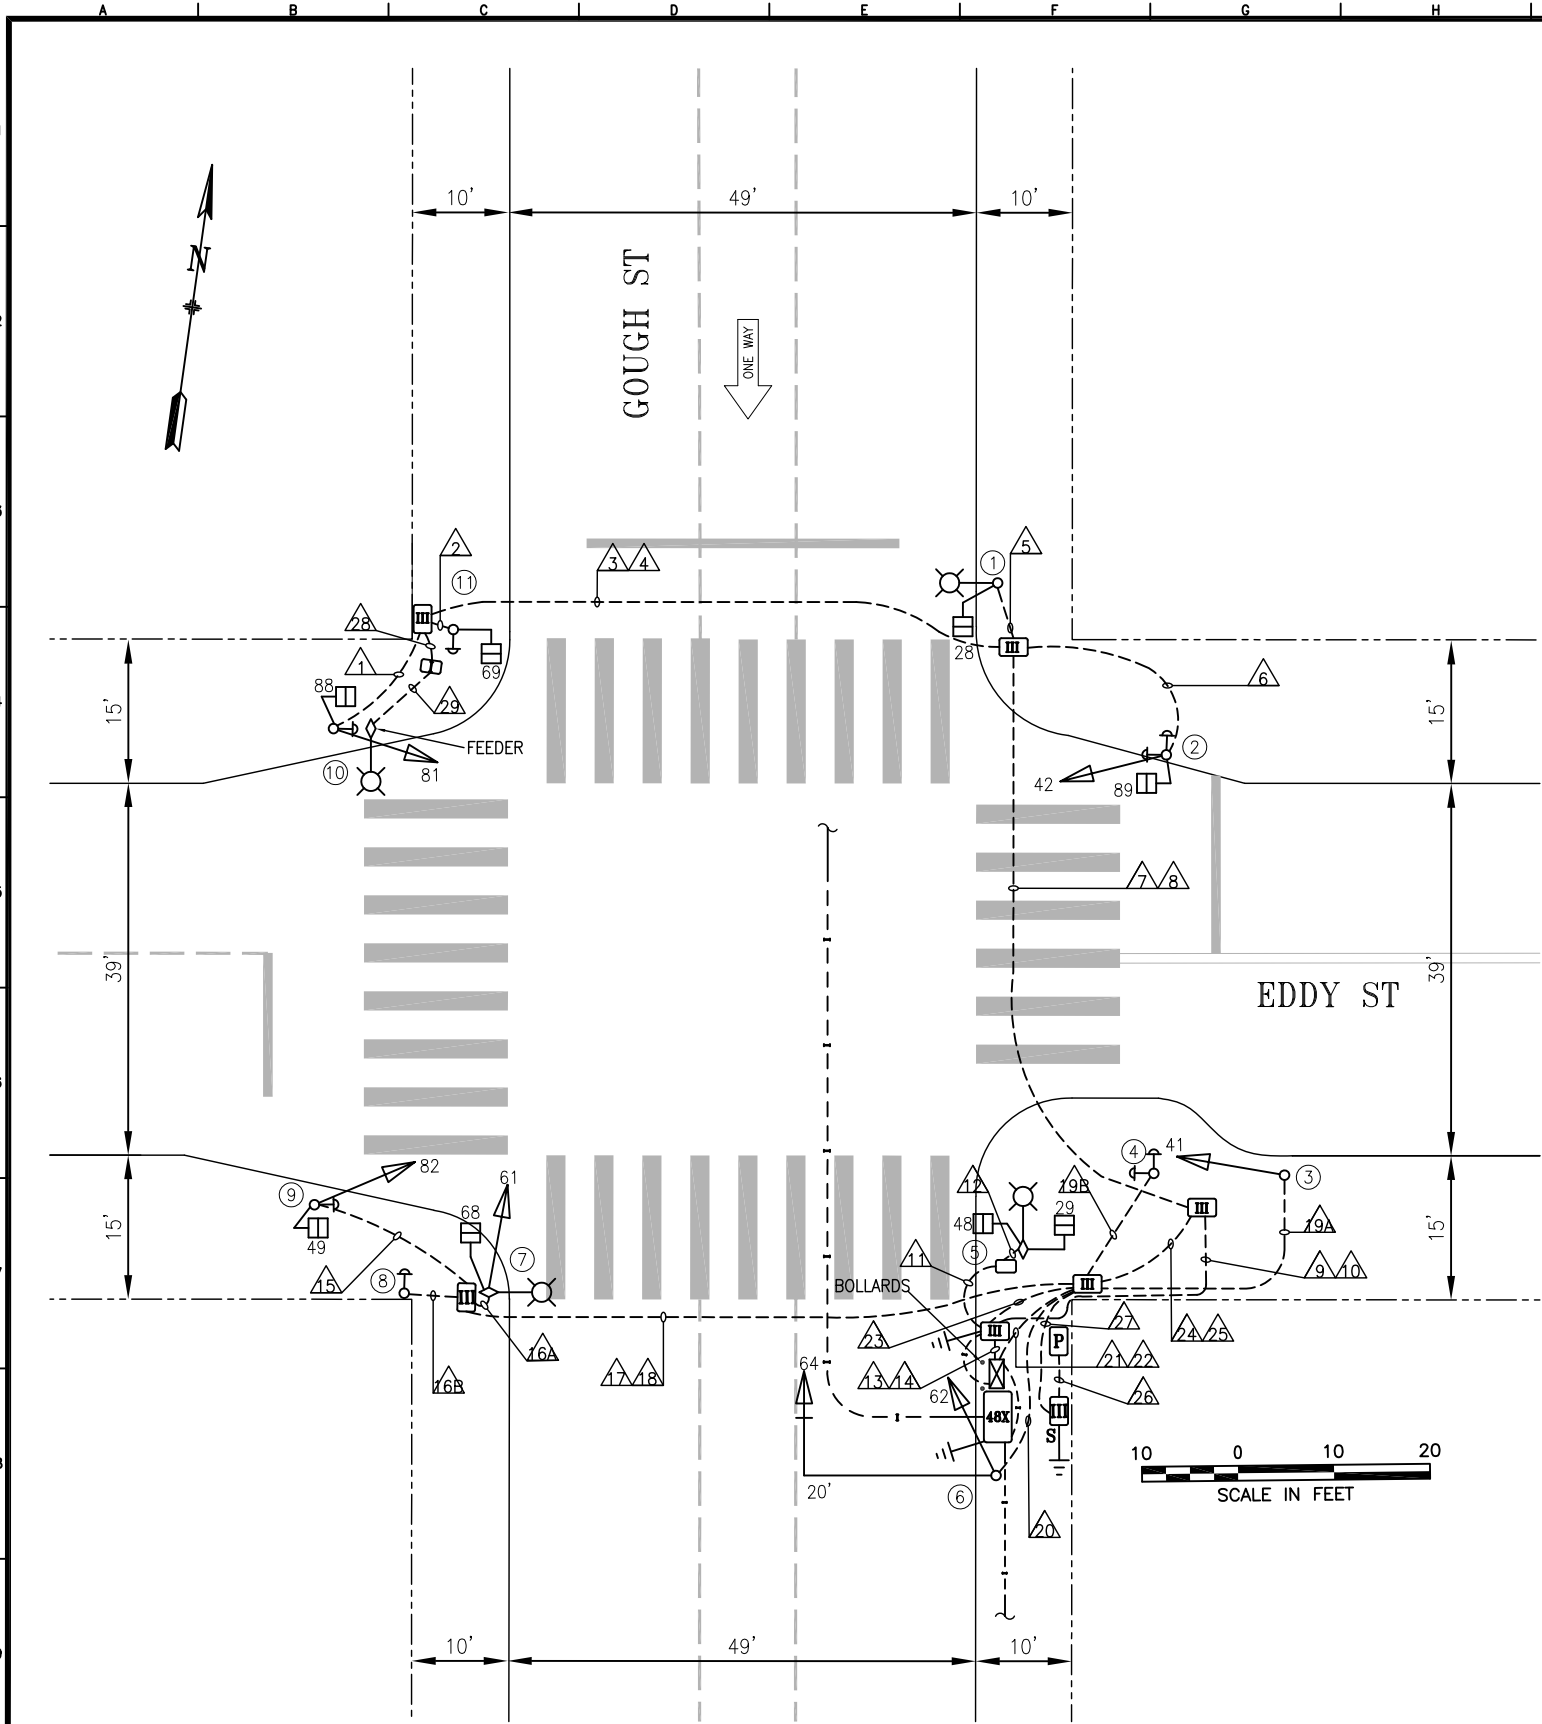

POLE AND EQUIPMENT SCHEDULE											
POLE No.	TYPE OF POLE	LUMINAIRE VOLTAGE/WATTAGE	VEHICLE SIGNAL					PEDESTRIAN SIGNAL			REMARKS
			No.	TYPE	MOUNTING	VISORS	LOUVERS/BP	No.	TYPE	MOUNTING	
①	MUNI POLE STREET LIGHT	LED						28	1S-COUNT	SP-1	
②	1-A (10')		42	3S12"	TV-1-T	T		89	1S-COUNT	SP-1	APS-2W x 2
③	1-A (10')		41	3S12"	TV-1-T	T					
④	1-A (7')										APS-2W x 2
⑤	MUNI POLE STREET LIGHT	LED						29 48	1S-COUNT 1S-COUNT	SP-1 SP-1	
⑥	16-2-100 W/ 20' MAST ARM		62 64	3S12" 3S12"	SV-1-T MAS	T T	BP				62 MOUNTED AT 13'
⑦	MUNI POLE STREET LIGHT	LED	61	3S12"	SV-1-T	T		68	1S-COUNT	SP-1	
⑧	PPB POLE										APS-2W
⑨	1-A (13')		82	3S12"	TV-1-T	T		49	1S-COUNT	SP-1	APS-2W
⑩	1-A (13')		81	3S12"	TV-1-T	T		88	1S-COUNT	SP-1 (22")	APS-2W
⑪	1-A (7')							69	1S-COUNT	TP-1	APS-2W

2	04/05/22	PER SRC 2022-081 INSTALL NE AND SW CORNER APS AND APS PER FIELD.	C. SKERRIT	G. DELEON
1	03/18/22	UPDATE SEC CURB LINE AND LAYOUT PLACEMENTS PER FIELD AND 950 GOUGH AS-BUILT	C. SKERRIT	G. DELEON
0	09/12/19	SIGNAL UPGRADE BY 3003J, CONVERTED FROM CONTRACT PLAN	C. SKERRIT	G. DELEON
NO.	DATE	DESCRIPTION	BY	APPROVED
TABLE OF REVISIONS				
CHECKOUT DRAWING THROUGH THE SID CUSTODIAN FOR THE LATEST REVISION				



DRAWN BY:	DATE:
C SKERRIT	12/2019
CHECKED BY:	DATE:
G DELEON	12/2019

SCALE
AS SHOWN
SHEET OF SHEETS
1 OF 2

TRAFFIC SIGNAL INVENTORY DIAGRAM
EDDY STREET AND GOUGH STREET

CNN NO:
26490000
REV NO:
2

