


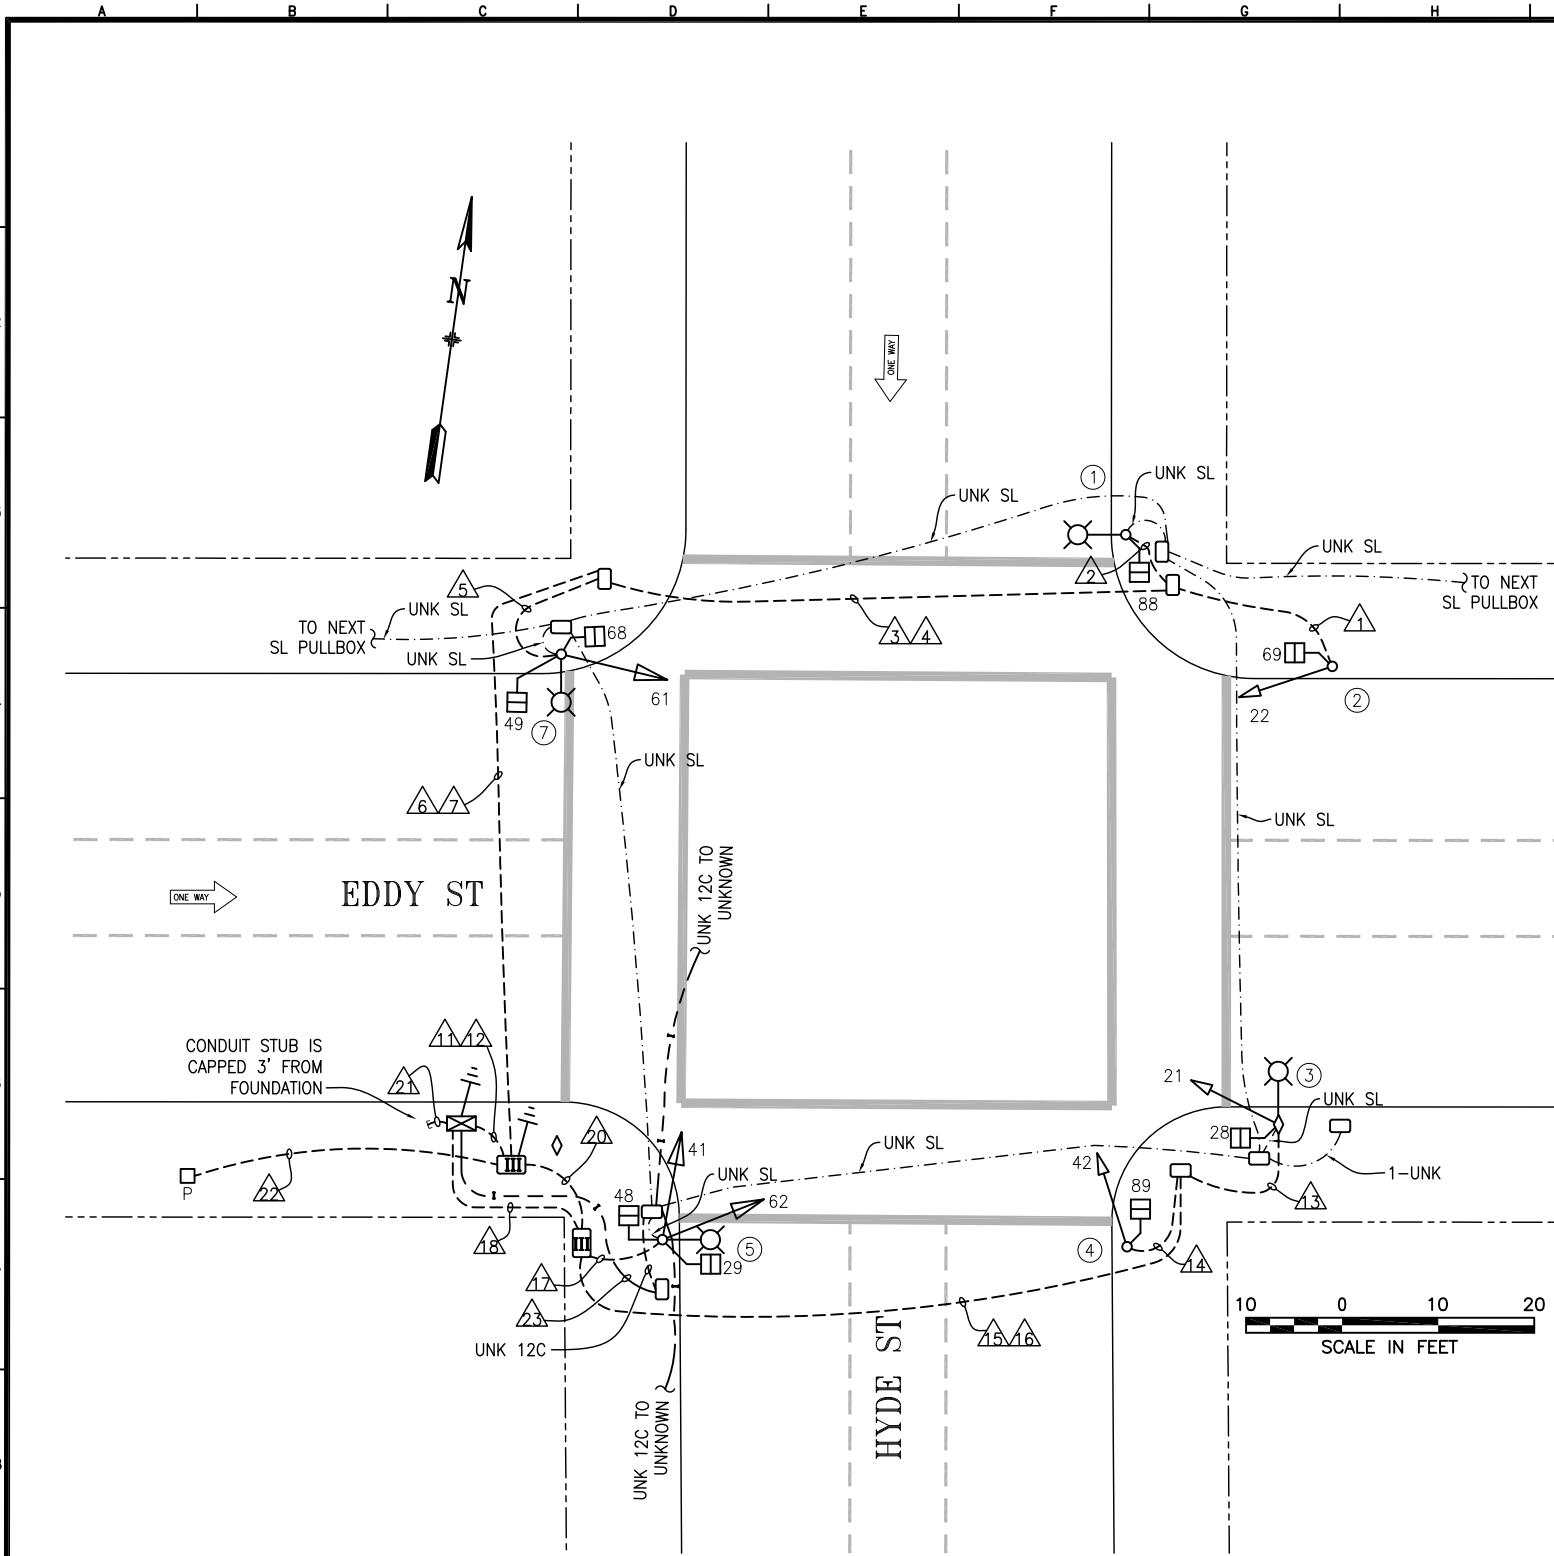

POLE AND EQUIPMENT SCHEDULE										
POLE No.	TYPE OF POLE	VEHICLE SIGNAL					PEDESTRIAN SIGNAL			REMARKS
		No.	TYPE	MOUNTING	VISORS	LOUVERS/BP	No.	TYPE	MOUNTING	
①	STREETLIGHT						88	1S-COUNT	SP-1	
②	1-A (10')	22	3S8"	TV-1	T		69	1S-COUNT	SP-1	
③	MUNI FEEDER POLE W/ 6' LA	21	3S8"	SV-1-T	T		28	1S-COUNT	SP-1-T	EXTERNAL CONDUIT
④	1-A (10')	42	3S8"	TV-1	T		89	1S-COUNT	SP-1	
⑤	STREETLIGHT	41 62	3S12" 3S12"	SV-2-TC	T T		48 29	1S-COUNT 1S-COUNT	SP-1 (22") SP-1-SF (12")	
⑥	NOT USED									
⑦	STREETLIGHT	61	3S12"	SV-1-T	T		49 68	1S-COUNT 1S-COUNT	SP-1 SP-1	

Δ	5/5/11	ADD SIGNALS 61 & 62. UPGRADE 41 TO 3S12" PER SRC 2010-244	M. VELASCO	M. VELASCO	
Δ	3/22/05	CONVERTED FROM CONTRACT 0480J AS-BUILT	D. YEUNG	G. DE LEON	
NO.	DATE	DESCRIPTION	BY	APPROVED	
TABLE OF REVISIONS					
CHECKOUT DRAWING THROUGH THE SID CUSTODIAN FOR THE LATEST REVISION					



SFMTA

DRAWN BY:	DATE:
D. YEUNG	MAR 2023
CHECKED BY:	DATE:
G. DE LEON	MAR 2023

SCALE
AS SHOWN
SHEET OF SHEETS
1 OF 2

TRAFFIC SIGNAL INVENTORY DIAGRAM
EDDY ST AND HYDE ST

CNN NO:
25138000
REV NO:
1

