


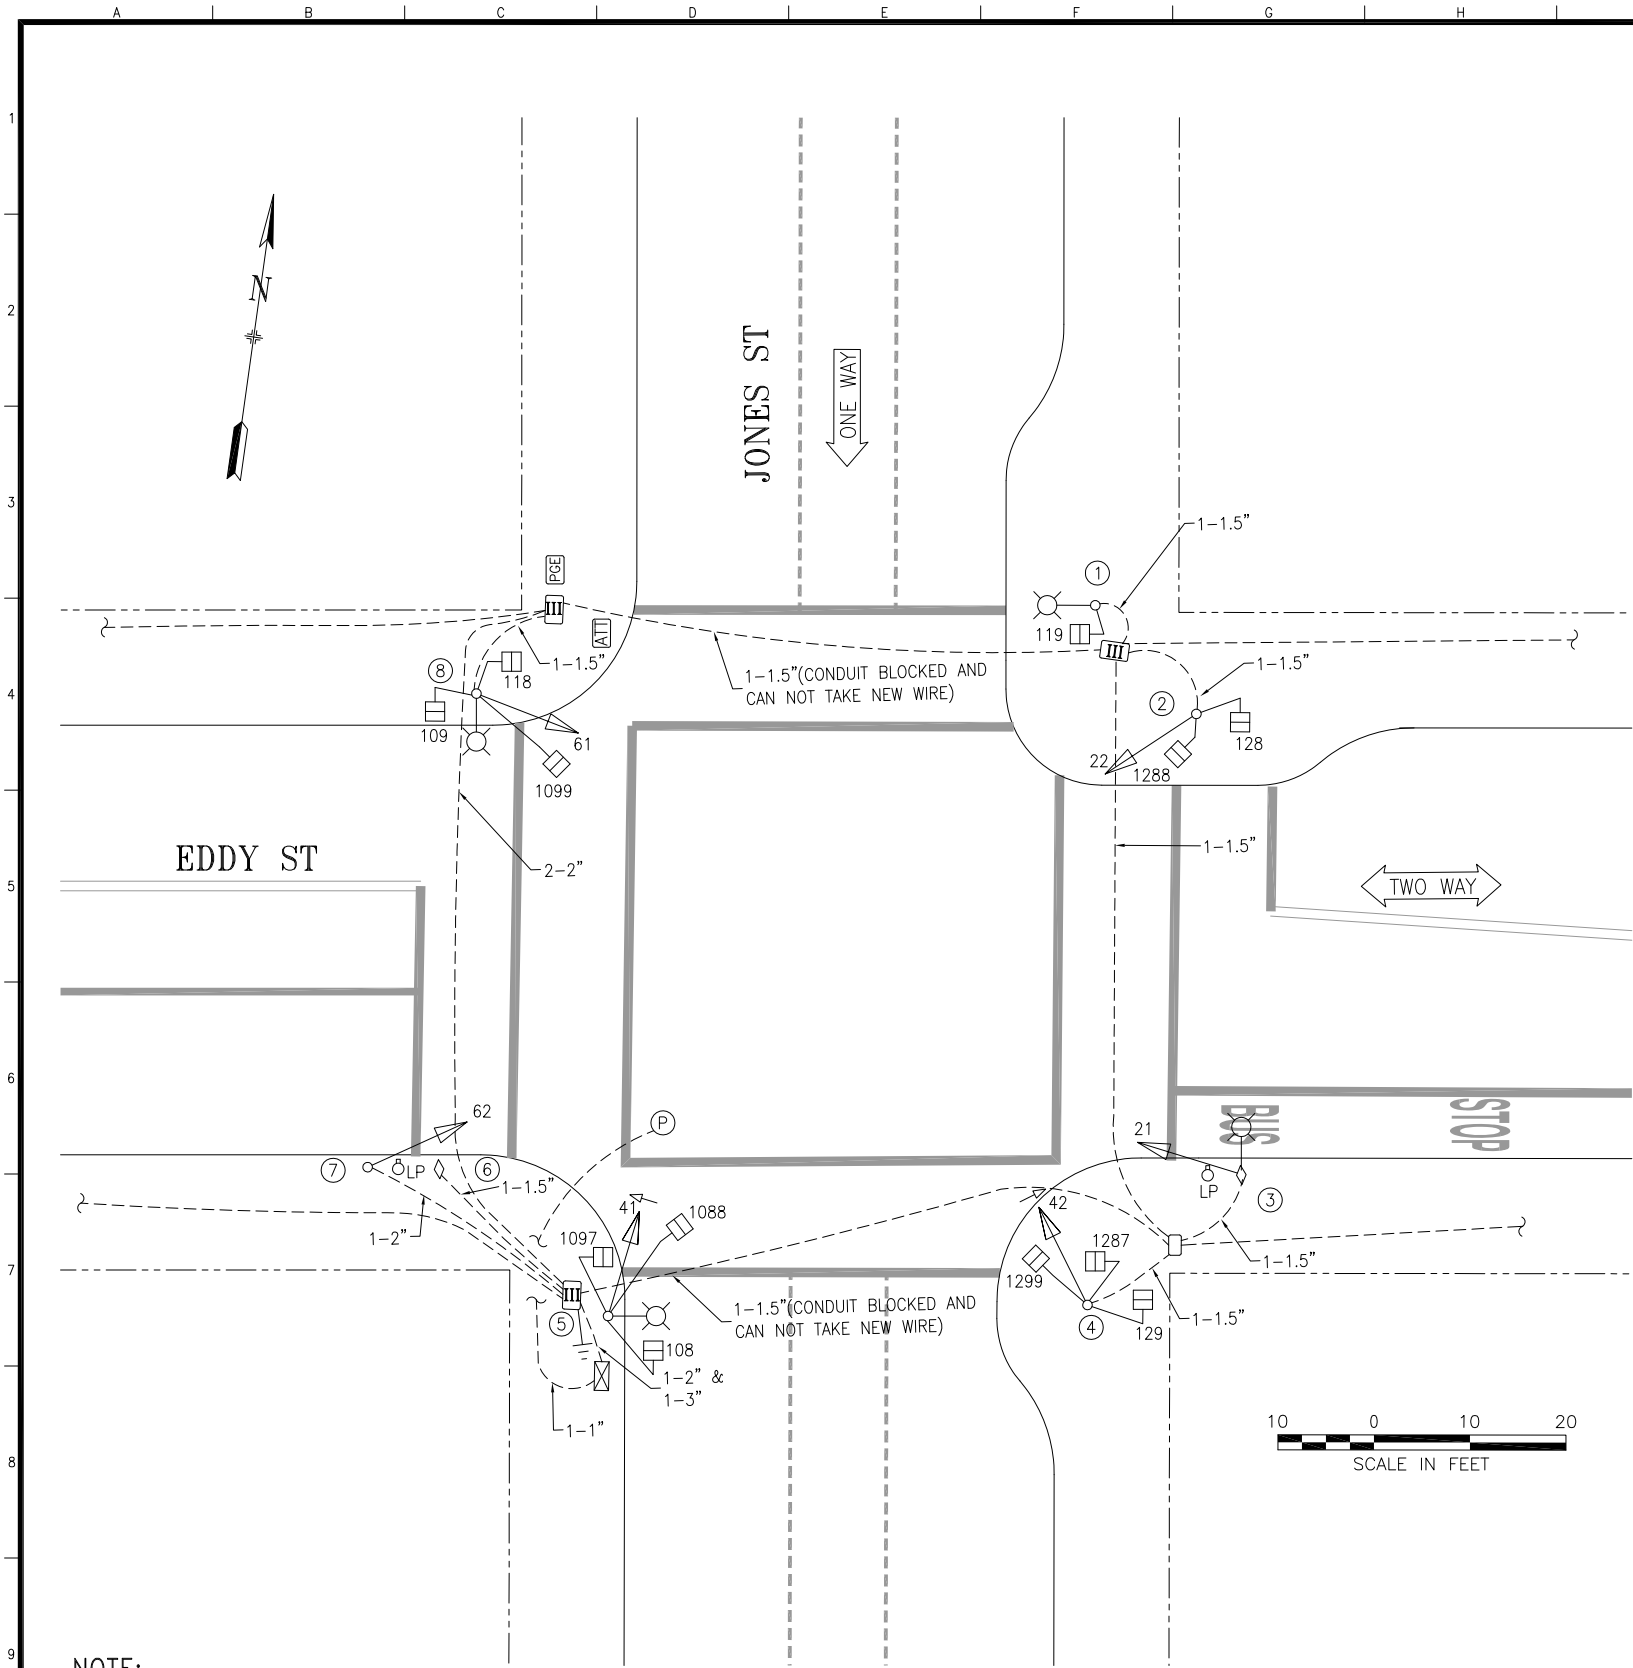

POLE AND EQUIPMENT SCHEDULE											
POLE No.	TYPE OF POLE	LUMINAIRE VOLTAGE/WATTAGE	VEHICLE SIGNAL					PEDESTRIAN SIGNAL			REMARKS
			No.	TYPE	MOUNTING	VISORS	LOUVERS	No.	TYPE	MOUNTING	
①	CITY STANDARD STREET LIGHT							119	1S-COUNT	SP-1	
②	1-A(10')		22	3S12"	TV-1-T	T		128 1288	1S-COUNT 1S-COUNT	SP-2 (CUSTOM)	
③	MUNI POLE		21	3S12"	SV-1	T					
④	TAPER TUBE (10')		42	4S12"GLA	TV-1-T	T		1287 129 1299	1S-COUNT 1S-COUNT 1S-COUNT	SP-3 (CUSTOM)	
⑤	CITY STANDARD STREET LIGHT		41	4S12"GRA	SV-1-T	T		1097 108 1088	1S-COUNT 1S-COUNT 1S-COUNT	SP-3 (CUSTOM)	
⑥	MUNI POLE										
⑦	1-A (10')		62	3S12"	TV-1-T	T					
⑧	CITY STANDARD STREET LIGHT		61	3S12"	SV-1-T	T		109 118 1099	1S-COUNT 1S-COUNT 1S-COUNT	SP-3 (CUSTOM)	

NOTE:
1) CABINET TYPE: M-SF ON ADAPTER PLATE
2) CONTROLLER TYPE: 2070

TABLE OF REVISIONS				
NO.	DATE	DESCRIPTION	BY	APP.
CHECK WITH TRACING TO SEE IF YOU HAVE LATEST REVISION				

REFERENCE INFORMATION & FILE NO. OF SURVEYS	



SAN FRANCISCO MUNICIPAL TRANSPORTATION AGENCY
CITY AND COUNTY OF SAN FRANCISCO

DRAWN:	DATE:
D.Y.	6/09
CHECKED:	DATE:
C.H.	6/09

SCALE:
1" = 10
SHEET OF SHEETS
1 OF 1

TRAFFIC SIGNAL INVENTORY DIAGRAM
EDDY STREET AND JONES STREET

CNN NO.
24929000
REV NO.
3