


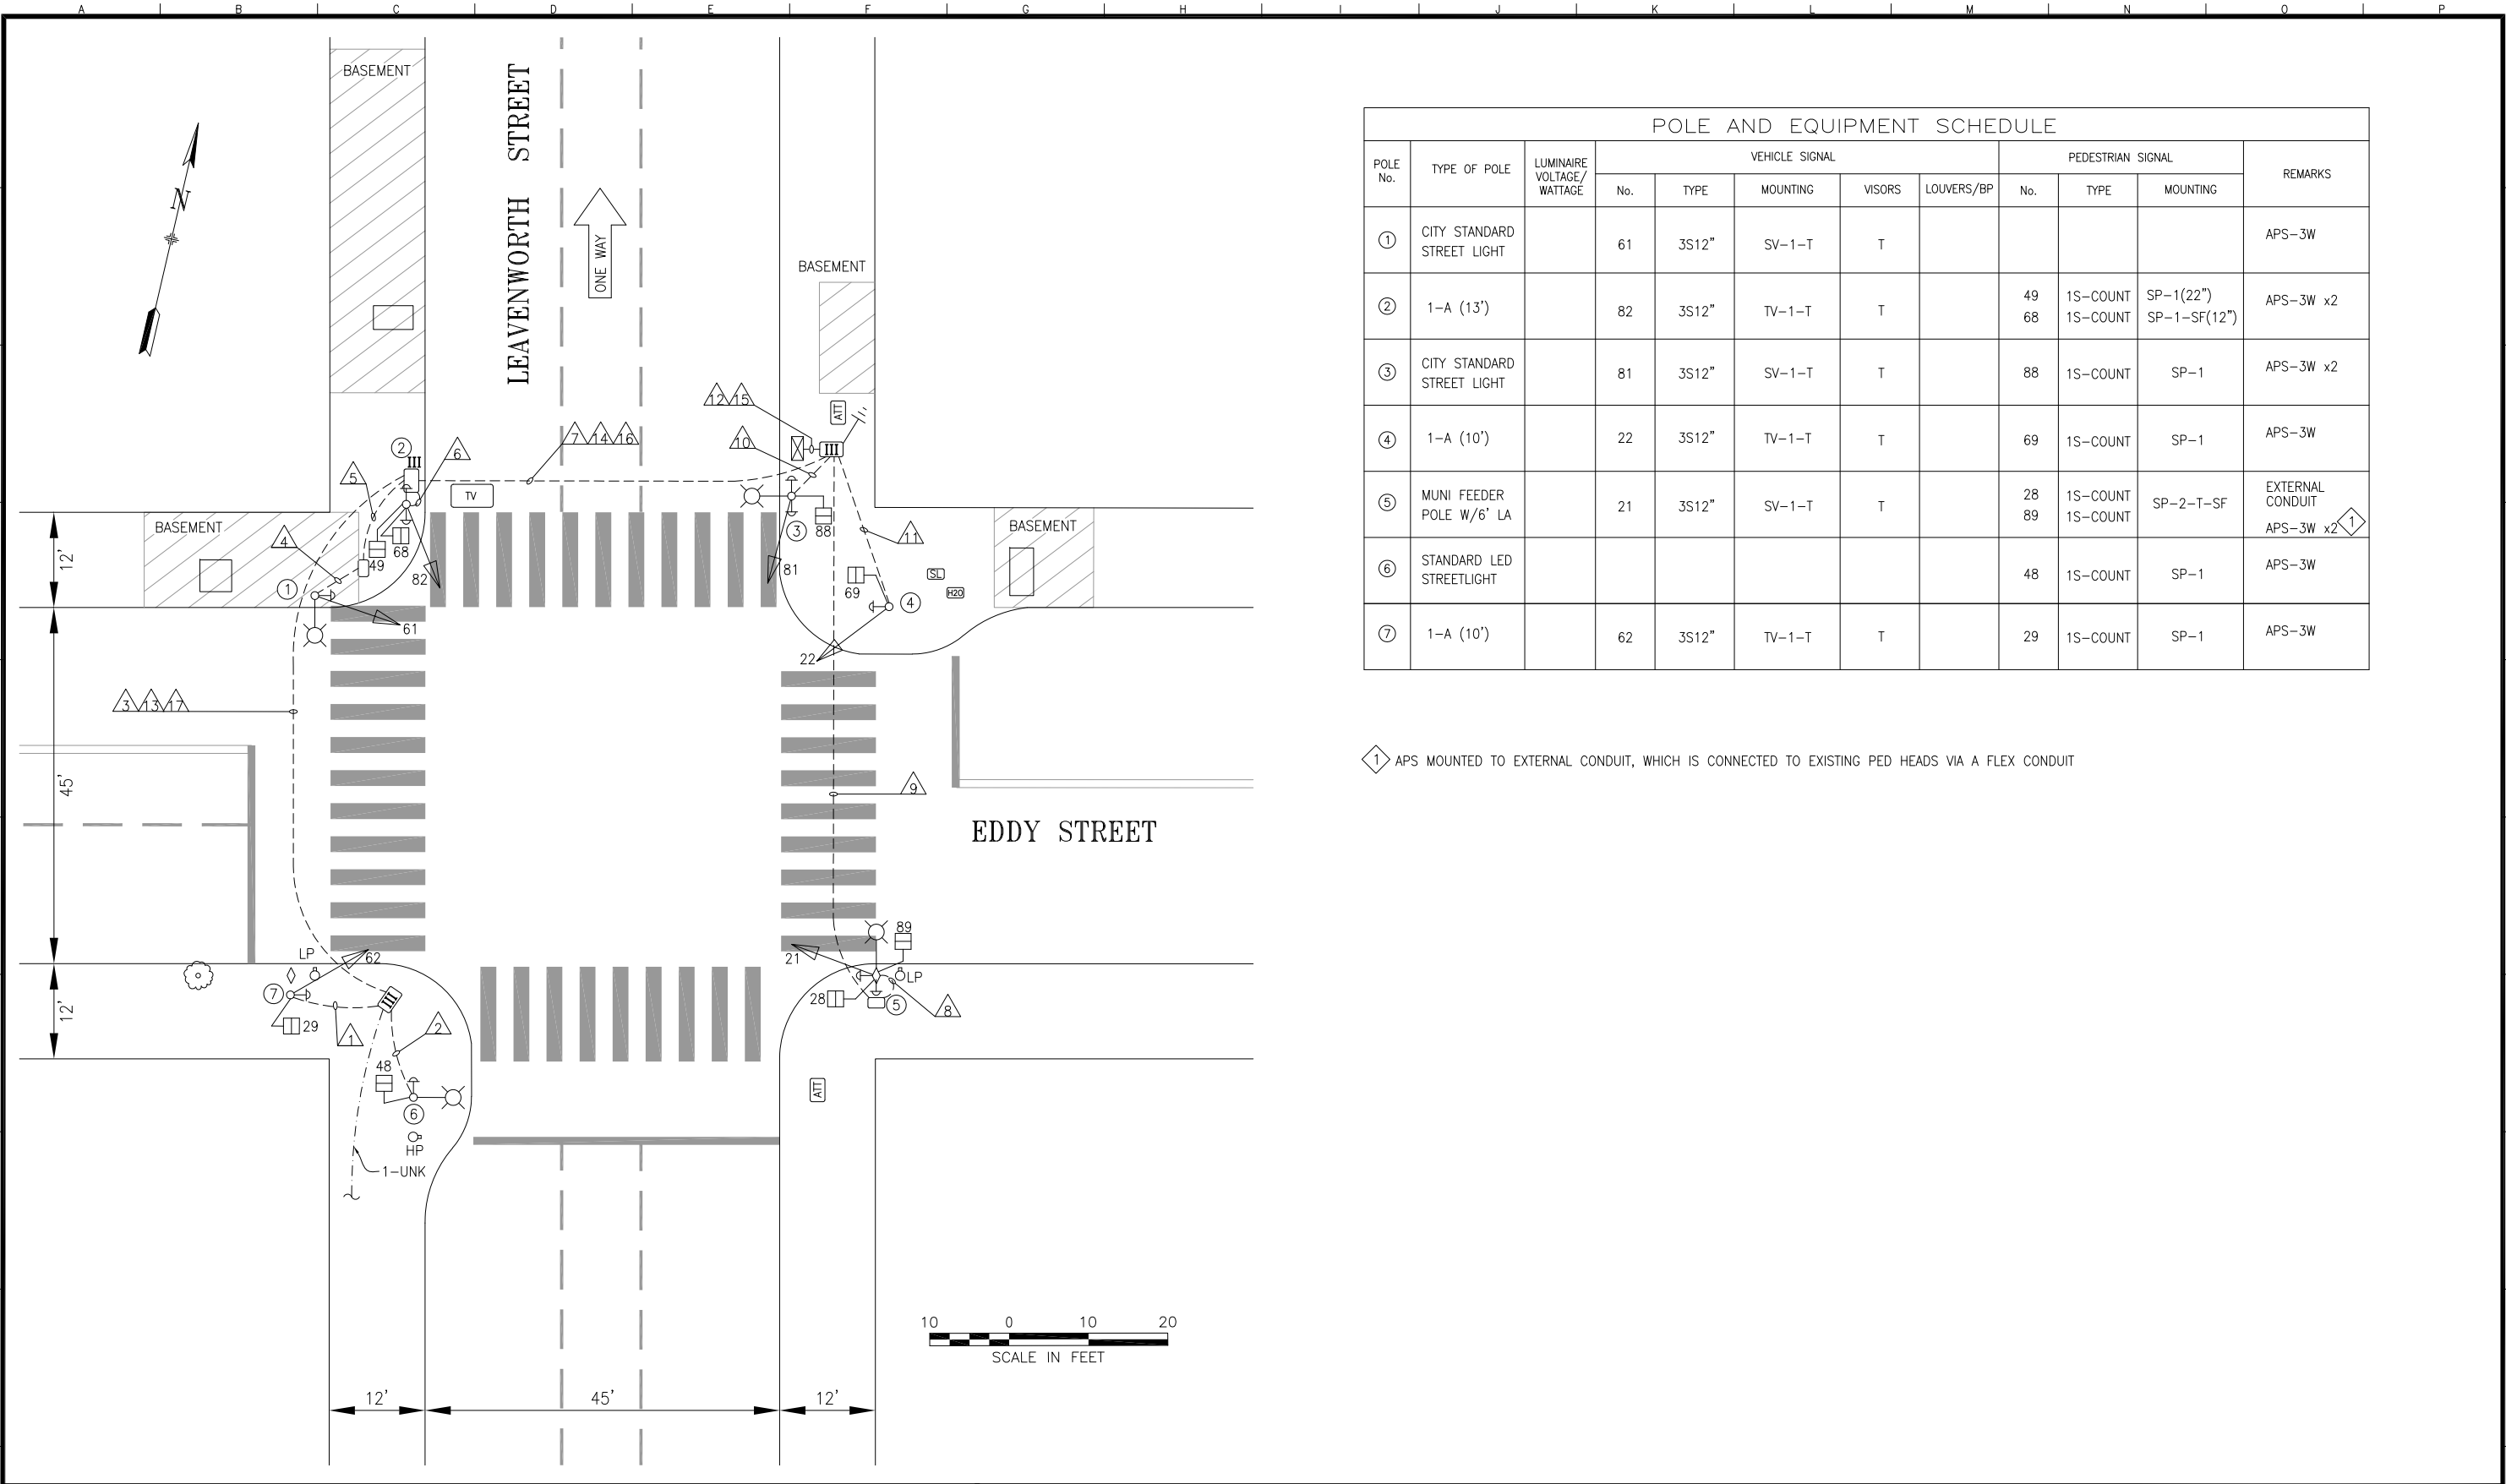

POLE AND EQUIPMENT SCHEDULE											
POLE No.	TYPE OF POLE	LUMINAIRE VOLTAGE/ WATTAGE	VEHICLE SIGNAL					PEDESTRIAN SIGNAL			REMARKS
			No.	TYPE	MOUNTING	VISORS	LOUVERS/BP	No.	TYPE	MOUNTING	
①	CITY STANDARD STREET LIGHT		61	3S12"	SV-1-T	T					APS-3W
②	1-A (13')		82	3S12"	TV-1-T	T		49 68	1S-COUNT 1S-COUNT	SP-1(22") SP-1-SF(12")	APS-3W x2
③	CITY STANDARD STREET LIGHT		81	3S12"	SV-1-T	T		88	1S-COUNT	SP-1	APS-3W x2
④	1-A (10')		22	3S12"	TV-1-T	T		69	1S-COUNT	SP-1	APS-3W
⑤	MUNI FEEDER POLE W/6' LA		21	3S12"	SV-1-T	T		28 89	1S-COUNT 1S-COUNT	SP-2-T-SF	EXTERNAL CONDUIT APS-3W x2 ①
⑥	STANDARD LED STREETLIGHT							48	1S-COUNT	SP-1	APS-3W
⑦	1-A (10')		62	3S12"	TV-1-T	T		29	1S-COUNT	SP-1	APS-3W

① APS MOUNTED TO EXTERNAL CONDUIT, WHICH IS CONNECTED TO EXISTING PED HEADS VIA A FLEX CONDUIT

1	9/19/23	PER SRC 2023-076: INSTALL 3-WIRE APS	D YUNG	G DELEON	
0	11/02/17	SIGNAL UPGRADE BY 2478J, CONVERTED FROM AS BUILT	D YUNG	G DELEON	
NO.	DATE	DESCRIPTION	BY	APPROVED	

TABLE OF REVISIONS
CHECKOUT DRAWING THROUGH THE SID CUSTODIAN FOR THE LATEST REVISION



SFMTA

DRAWN BY: DYEUNG	DATE: 09/2019
CHECKED BY: GdeLEON	DATE: 09/2019

SCALE
AS SHOWN
SHEET OF SHEETS
1 OF 2

TRAFFIC SIGNAL INVENTORY DIAGRAM	CNN NO: 24935000
EDDY STREET AND LEAVENWORTH STREET	REV NO: 1

