


EDDY & MASON

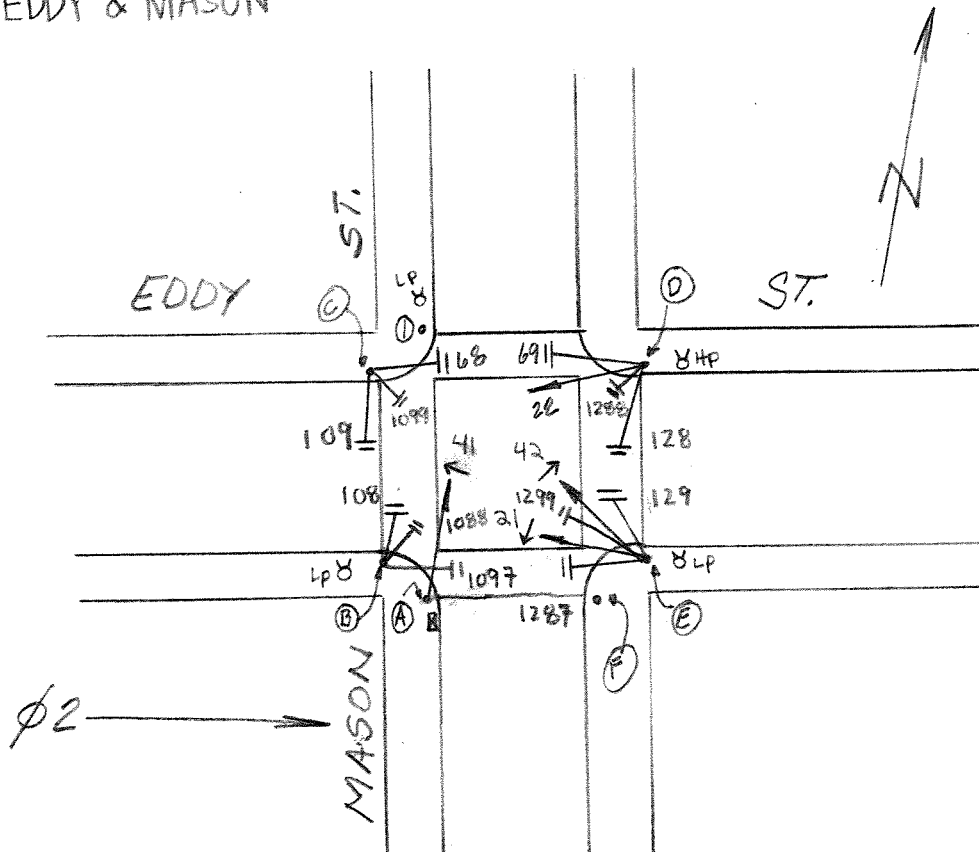

4/21/21

POLE	FUNC.	MAT'L	SIGNAL NO.	MAKE	NO. OF SECT.	SIZE	VISOR	B.P. OR LOUVERS	MOUNT	PED SIGNAL NO.	LEGEND	MESSAGE		MAKE	MOUNT
												ELEMENT	COLOR		
A	S	S	41	EA	4	12" GRA	T	NO	T	1097	COUNT	LED	w/or	ICC	S
B	S	S	22	EA	3	12"	T	NO	S	108	COUNT	LED	w/or	ICC	S
C	L	S	21	EA	4	12"	T	NO	T	109	COUNT	LED	w/or	ICC	S
D	S	C	42	EA	4	12" GLA	T	NO	T	68	COUNT	LED	w/or	ICC	S
E	S	S								69	COUNT	LED	w/or	ICC	S
F	L	O								128	COUNT	LED	w/or	ICC	S
										129	COUNT	LED	w/or	ICC	S
I	L	O								1287	COUNT	LED	w/or	ICC	S
										1288	IS-C				S
										1299	IS-C				S
										1088	IS-C				S
										1099	IS-C				S

CONTROLLER CABINET SIZE : ORDINARY BASE CABINET: YES

COMMENTS: Add Diagonal Ped Signals. Relocate 29 to pole "B" and renumber to 1097. Change 41 to 45 12" GRA. Renumber phase 8 to 12, and 4 to 10. Renumber 28 to 1287. PER SRC 2021-046. D.YEUNG 4-21-21