


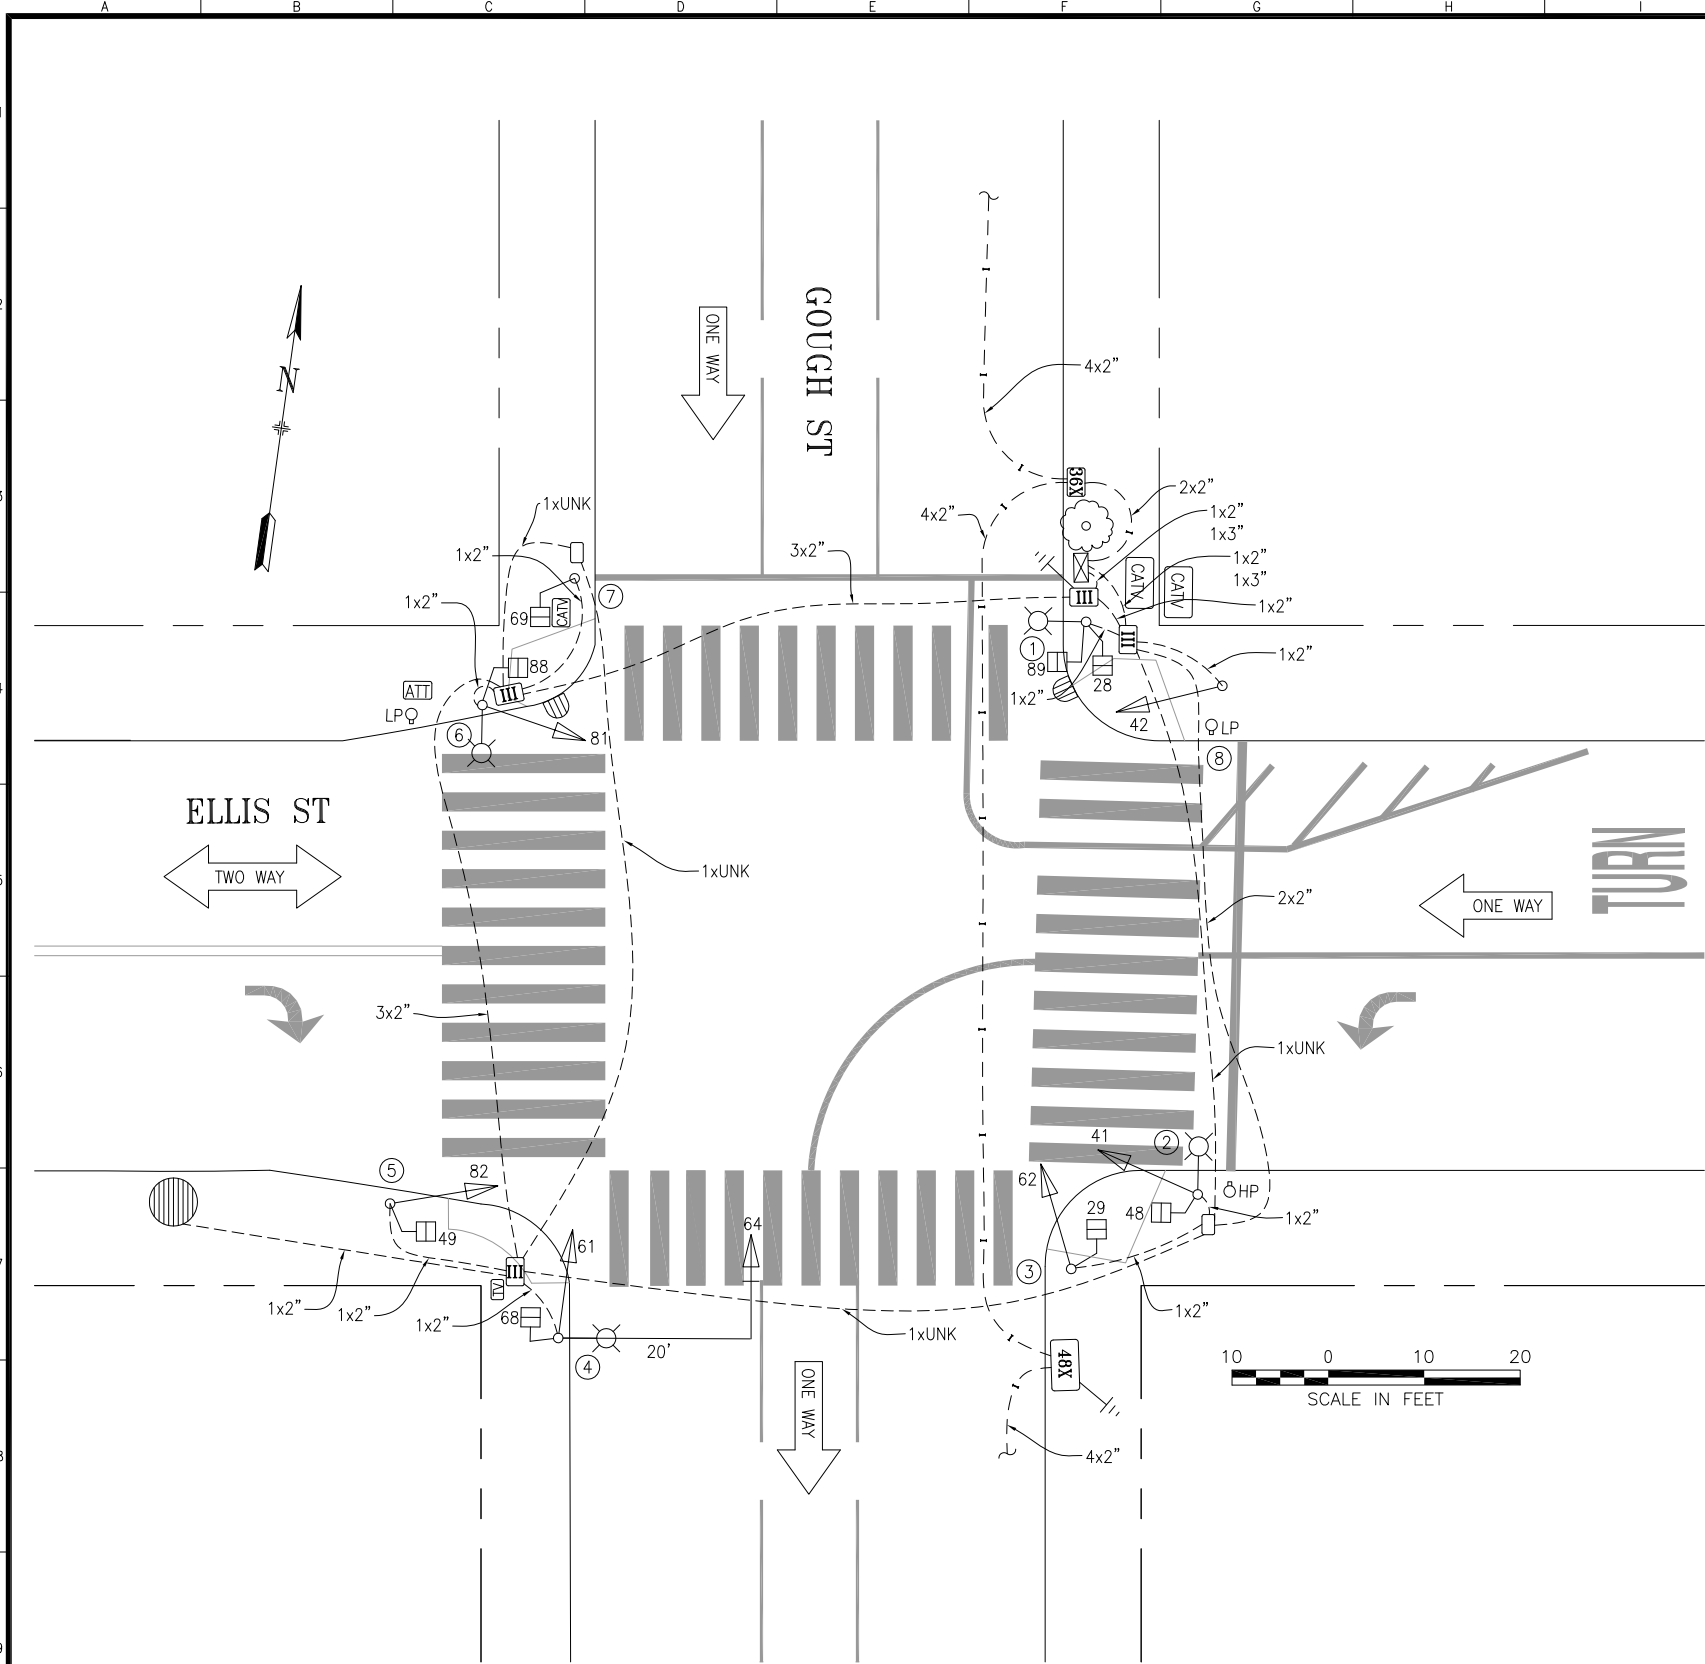

POLE AND EQUIPMENT SCHEDULE											
POLE No.	TYPE OF POLE	LUMINAIRE VOLTAGE/ WATTAGE	VEHICLE SIGNAL					PEDESTRIAN SIGNAL			REMARKS
			No.	TYPE	MOUNTING	VISORS	LOUVERS	No.	TYPE	MOUNTING	
①	MARBELITE STREET LIGHT							28 89	1S-COUNT 1S-COUNT	SP-1 (22") SP-1-SF (12")	
②	MARBELITE STREET LIGHT		41	3S12"FY	SV-1-T	T		48	1S-COUNT	SP-1	
③	1-A (10')		62	3S12"	TV-1-T	T		29	1S-COUNT	SP-1	
④	19-1-100 WITH 20' MAST ARM AND 6' LUMINAIRE ARM	120V/ 200W	64 61	3S12" 3S12"	MAS SV-1-T	T T		68	1S-COUNT	SP-1 (22")	BACKPLATE
⑤	1-A (13')		82	3S12"	TV-1-T	T		49	1S-COUNT	SP-1	
⑥	MARBELITE STREET LIGHT		81	3S12"	SV-1-T	T		88	1S-COUNT	SP-1	
⑦	1-A (7')							69	1S-COUNT	TP-1	
⑧	1-A (10')		42	3S12"FY	TV-1-T	T					

0	4/23/14	SIGNAL UPGRADE THRU 2142; SID CONVERTED FROM CONTRACT PLANS	SVohra	GDeLeon	
NO.	DATE	DESCRIPTION	BY	APP.	
TABLE OF REVISIONS					
CHECK WITH TRACING TO SEE IF YOU HAVE LATEST REVISION					

REFERENCE INFORMATION & FILE NO. OF SURVEYS



SAN FRANCISCO MUNICIPAL TRANSPORTATION AGENCY
CITY AND COUNTY OF SAN FRANCISCO

DRAWN:	DATE:
SVohra	12/2015
CHECKED:	DATE:
G DeLeon	6/6/16

SCALE:
AS SHOWN
SHEET OF SHEETS
1 OF 1

TRAFFIC SIGNAL INVENTORY DIAGRAM
ELLIS STREET AND GOUGH STREET

CNN NO.
26492000
REV NO.
0