


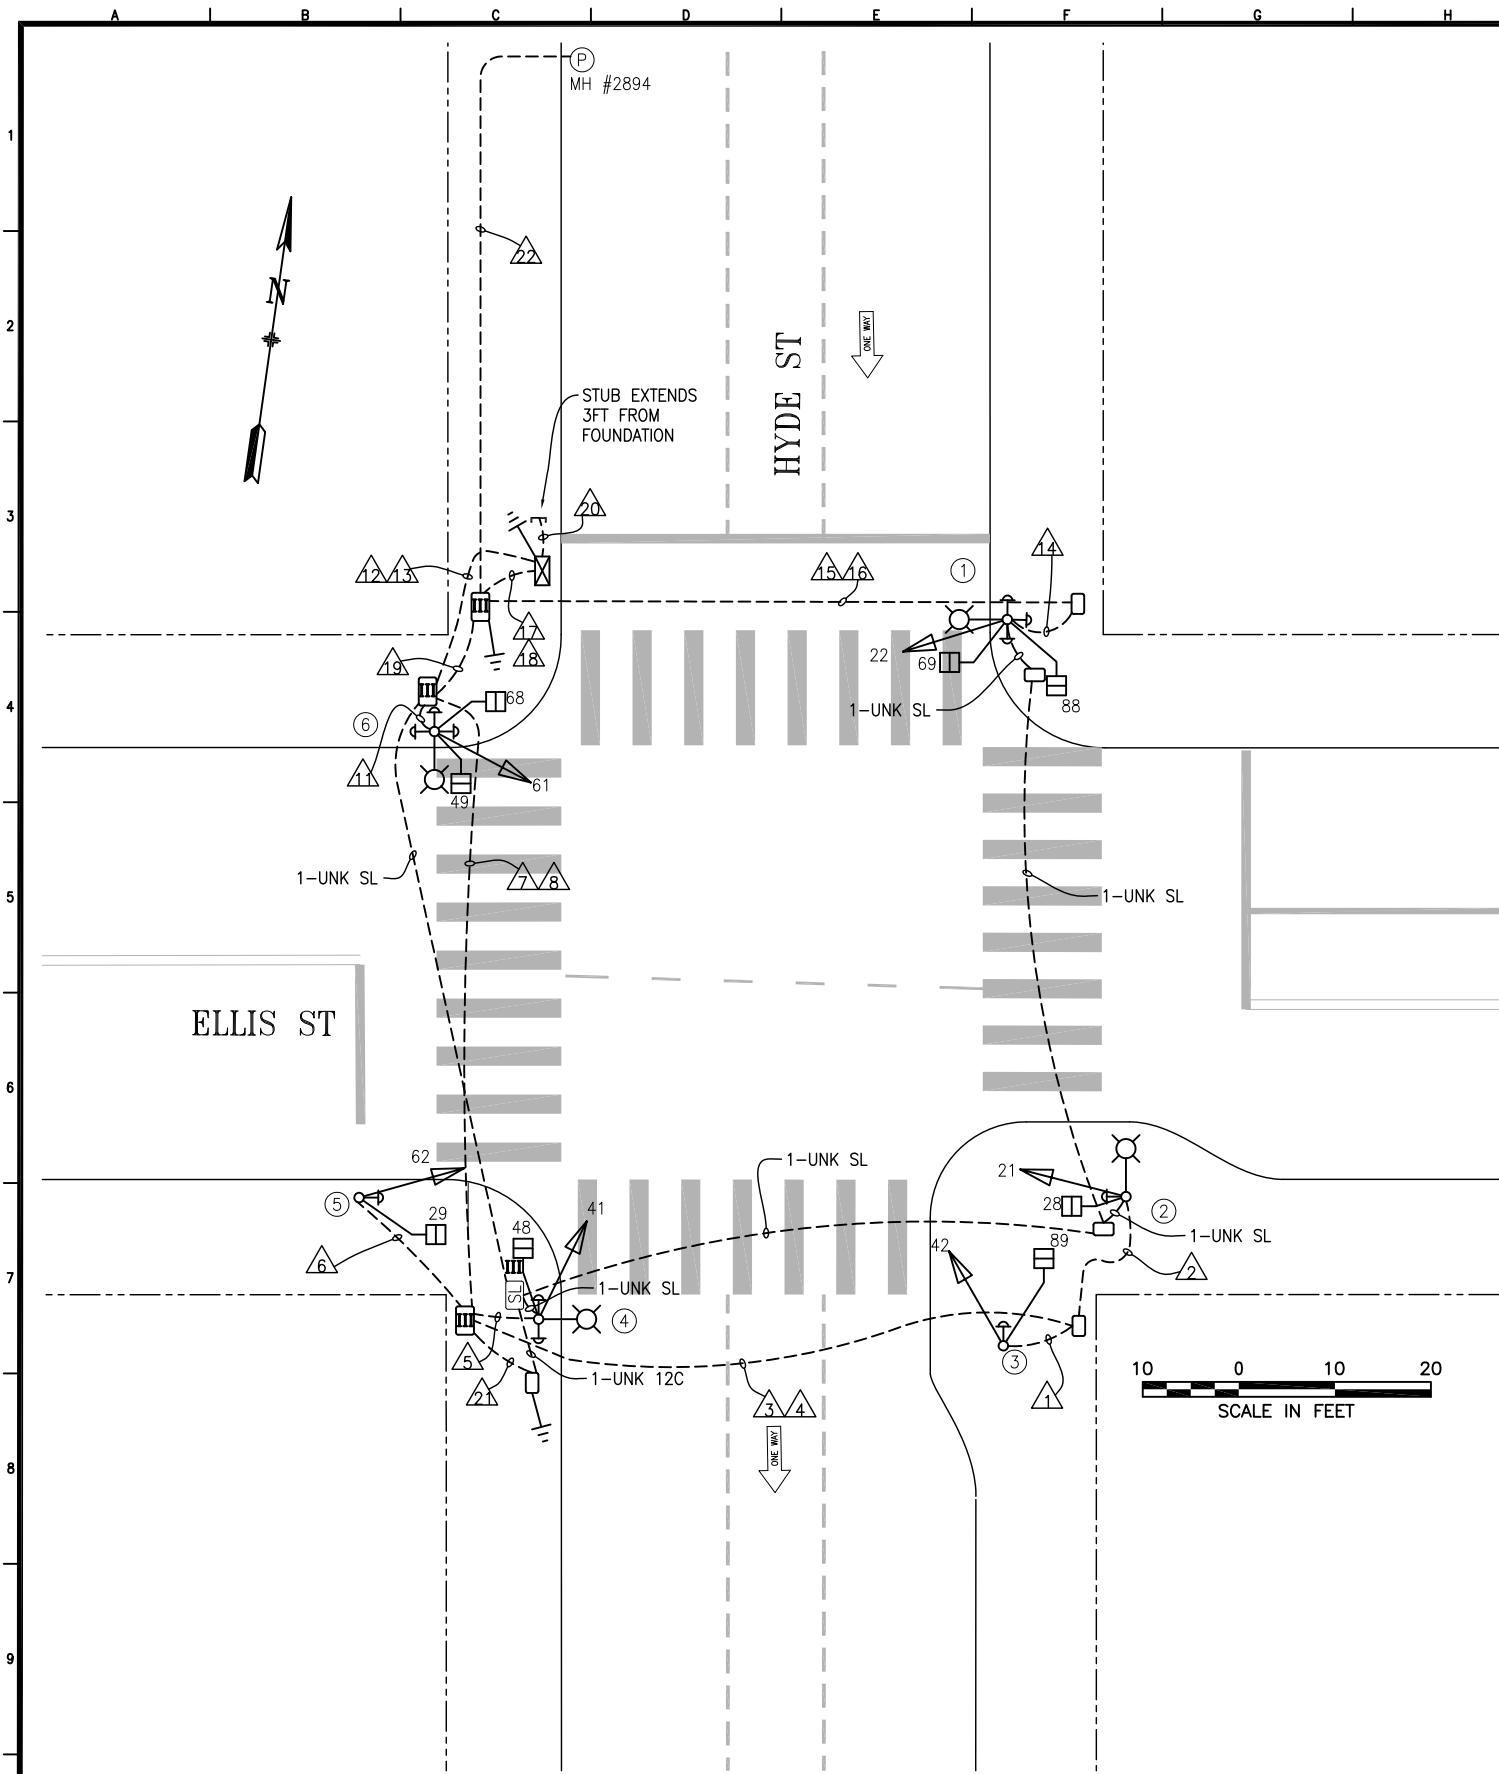

POLE AND EQUIPMENT SCHEDULE										
POLE No.	TYPE OF POLE	VEHICLE SIGNAL					PEDESTRIAN SIGNAL			REMARKS
		No.	TYPE	MOUNTING	VISORS	LOUVERS/BP	No.	TYPE	MOUNTING	
①	STREETLIGHT	22	3S12"	SV-1-T (TERMINAL ON EAST SIDE)	T		69 88	1S-COUNT 1S-COUNT	SP-1 SP-1	APS-3W x3
②	STREETLIGHT	21	3S12"	SV-1-T	T		28	1S-COUNT	SP-1	APS-3W
③	1-A (10')	42	3S12"	TV-1-T	T		89	1S-COUNT	SP-1	APS-3W
④	STREETLIGHT	41	3S12"	SV-1-T (TERMINAL ON SOUTH SIDE)	T		48	1S-COUNT	SP-1	APS-3W x2
⑤	1-A (10')	62	3S12"	TV-1-T	T		29	1S-COUNT	SP-1	APS-3W
⑥	STREETLIGHT	61	3S12"	SV-1-T	T		49 68	1S-COUNT 1S-COUNT	SP-1-SF(12') SP-1 (22")	APS-3W x3

Δ	8/8/23	PER SRC 2023-076: INSTALL NEW APS		D. YEUNG	G. DELEON
Δ	8/18/22	UPDATE PGE PER AS-BUILT. DELETE DUPLICATE CONDUIT 9/10. MINOR MOUNTING UPDATES PER FIELD: 41 & 22		D. YEUNG	G. DELEON
Δ	2/5/21	CONVERTED FROM 0480J CONTRACT PLAN & SRC 2010-244 & 2020-207		D. YEUNG	G. DELEON
NO.	DATE	DESCRIPTION		BY	APPROVED
TABLE OF REVISIONS					
CHECKOUT DRAWING THROUGH THE SID CUSTODIAN FOR THE LATEST REVISION					



SFMTA

DRAWN BY:	DATE:
D. YEUNG	8/2022
CHECKED BY:	DATE:
G. DELEON	8/2022

SCALE
AS SHOWN
SHEET OF SHEETS
1 OF 2

TRAFFIC SIGNAL INVENTORY DIAGRAM
ELLIS ST AND HYDE ST

CNN NO:
25144000
REV NO:
2

