


ELLIS & JONES

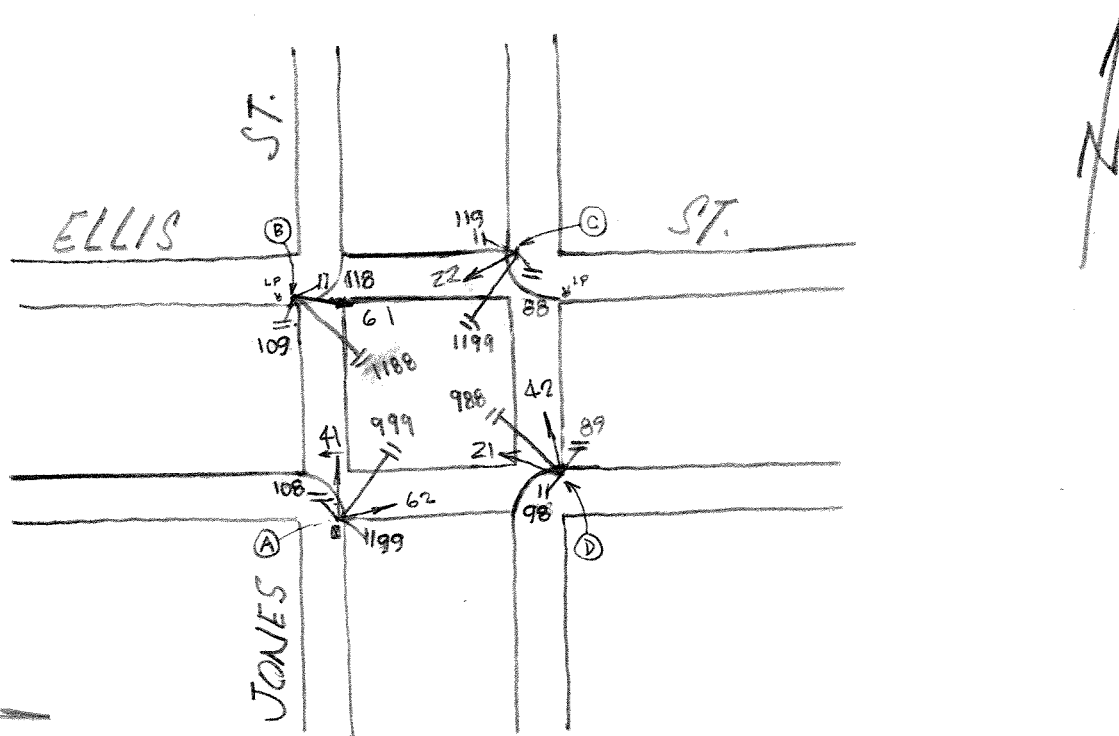

4-21-21

POLE	FUNC.	MAT'L	SIGNAL NO.	MAKE	NO. OF SECT.	SIZE	VISOR	B.P. OR LOUVERS	MOUN'T	PED SIGNAL NO.	LEGEND	MESSAGE		MAKE	MOUN'T
												ELEMENT	COLOR		
A	L	S	62		3	12"	T	NO	S	98	COUNT	IS	W/OR	ICC	SP-1
B	L	S	41		4	12" GRA	T	NO	S	99	COUNT	IS	W/OR	ICC	SP-1
C	L	S	61		3	12"	T	NO	S	108	COUNT	IS	W/OR	ICC	SP-1
D	L	S	42		3	12"	FC	NO	SV-2-TC	109	COUNT	IS	W/OR	ICC	SP-1
										118	COUNT	IS	W/OR	ICC	SP-1
										119	COUNT	IS	W/OR	ICC	SP-1
										88	COUNT	IS	W/OR	ICC	SP-1
										89	COUNT	IS	W/OR	ICC	SP-1
										988	COUNT	IS			
										999	COUNT	IS			
										1188	COUNT	IS			
										1199	COUNT	IS			

CONTROLLER CABINET SIZE : G BASE CABINET: YES

COMMENTS: Add Diagonal Ped Signals. SRC 2021-046

-D. YEUNG 4-21-21