


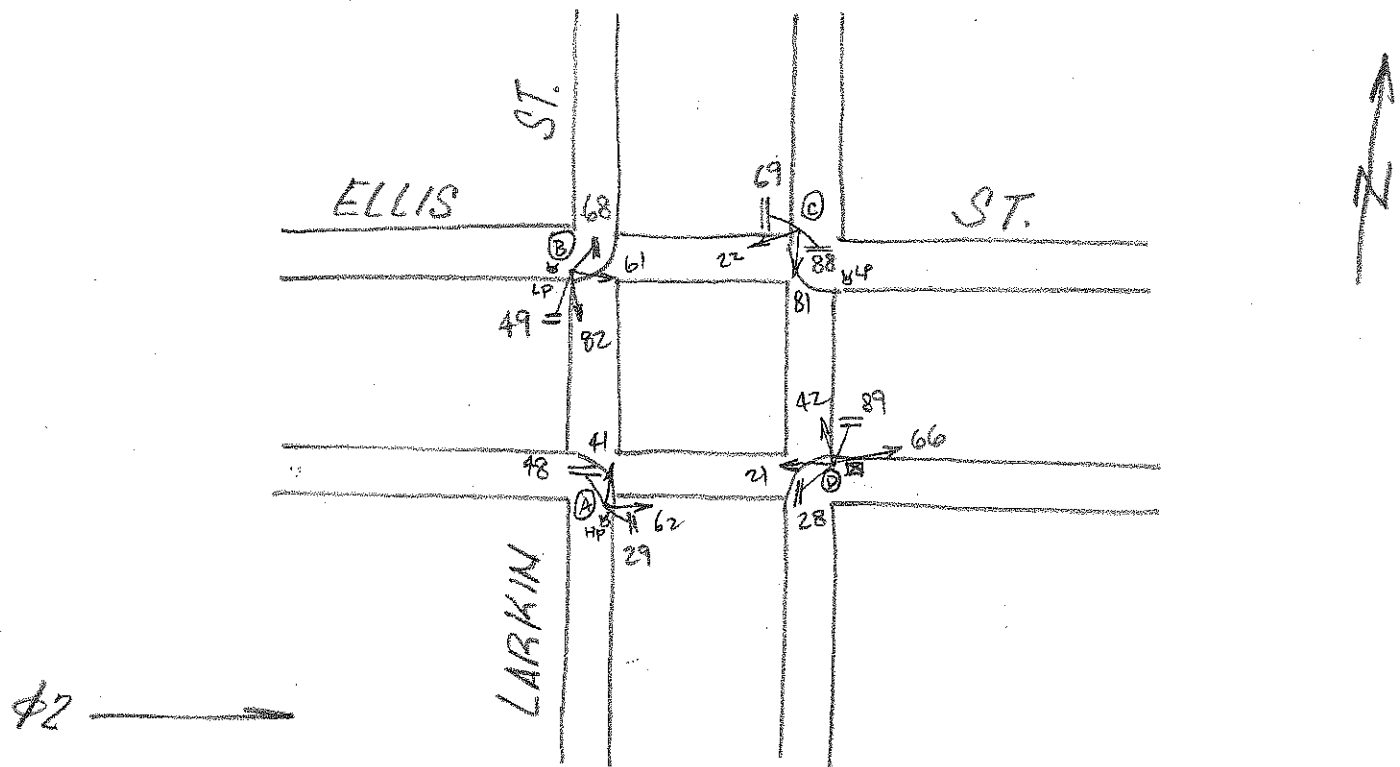

POLE	FUNC.	MAT'L	SIGNAL NO.	MAKE	NO. OF SECT.	SIZE	VISOR	B.P. OR LOUVERS	MOUN'T	PED SIGNAL NO.	LEGEND	MESSAGE		MAKE	MOUN'T
												ELEMENT	COLOR		
A	L	S	62	EC	3	12"	FC 12"	No	S	29	I	13-COUNT			SP-1
B	L	S	41	EC	3	12"	FC 12"	NO	S	48	I	18-COUNT			SP-1
C	L	S	82	EC	3	12"	FC 12"	NO	S	49	I	15-COUNT			SP-1
D	L	S	61	EC	3	12"	FC 12"	No	S	68	I	15-COUNT			SP-1
			12	GA	3	12"	FC 12"	No	S	69	I	15-COUNT			SP-1
			81	GA	3	12"	FC 12"	No	S	88	I	18-COUNT			SP-1
			42	EC	3	12"	FC 12"	No	S	28	I	18-COUNT			SP-1
			21	FC	3	12"	FC 12"	NO	S	89	I	15-COUNT			SP-1
			66	-	3	12"	12"	NO	S						

CONTROLLER CABINET SIZE : ORDINARY BASE CABINET: No

COMMENTS: NEW PED SIGNALS - SRC WORK ORDER 2010-261
AND 12" SIGNALS