


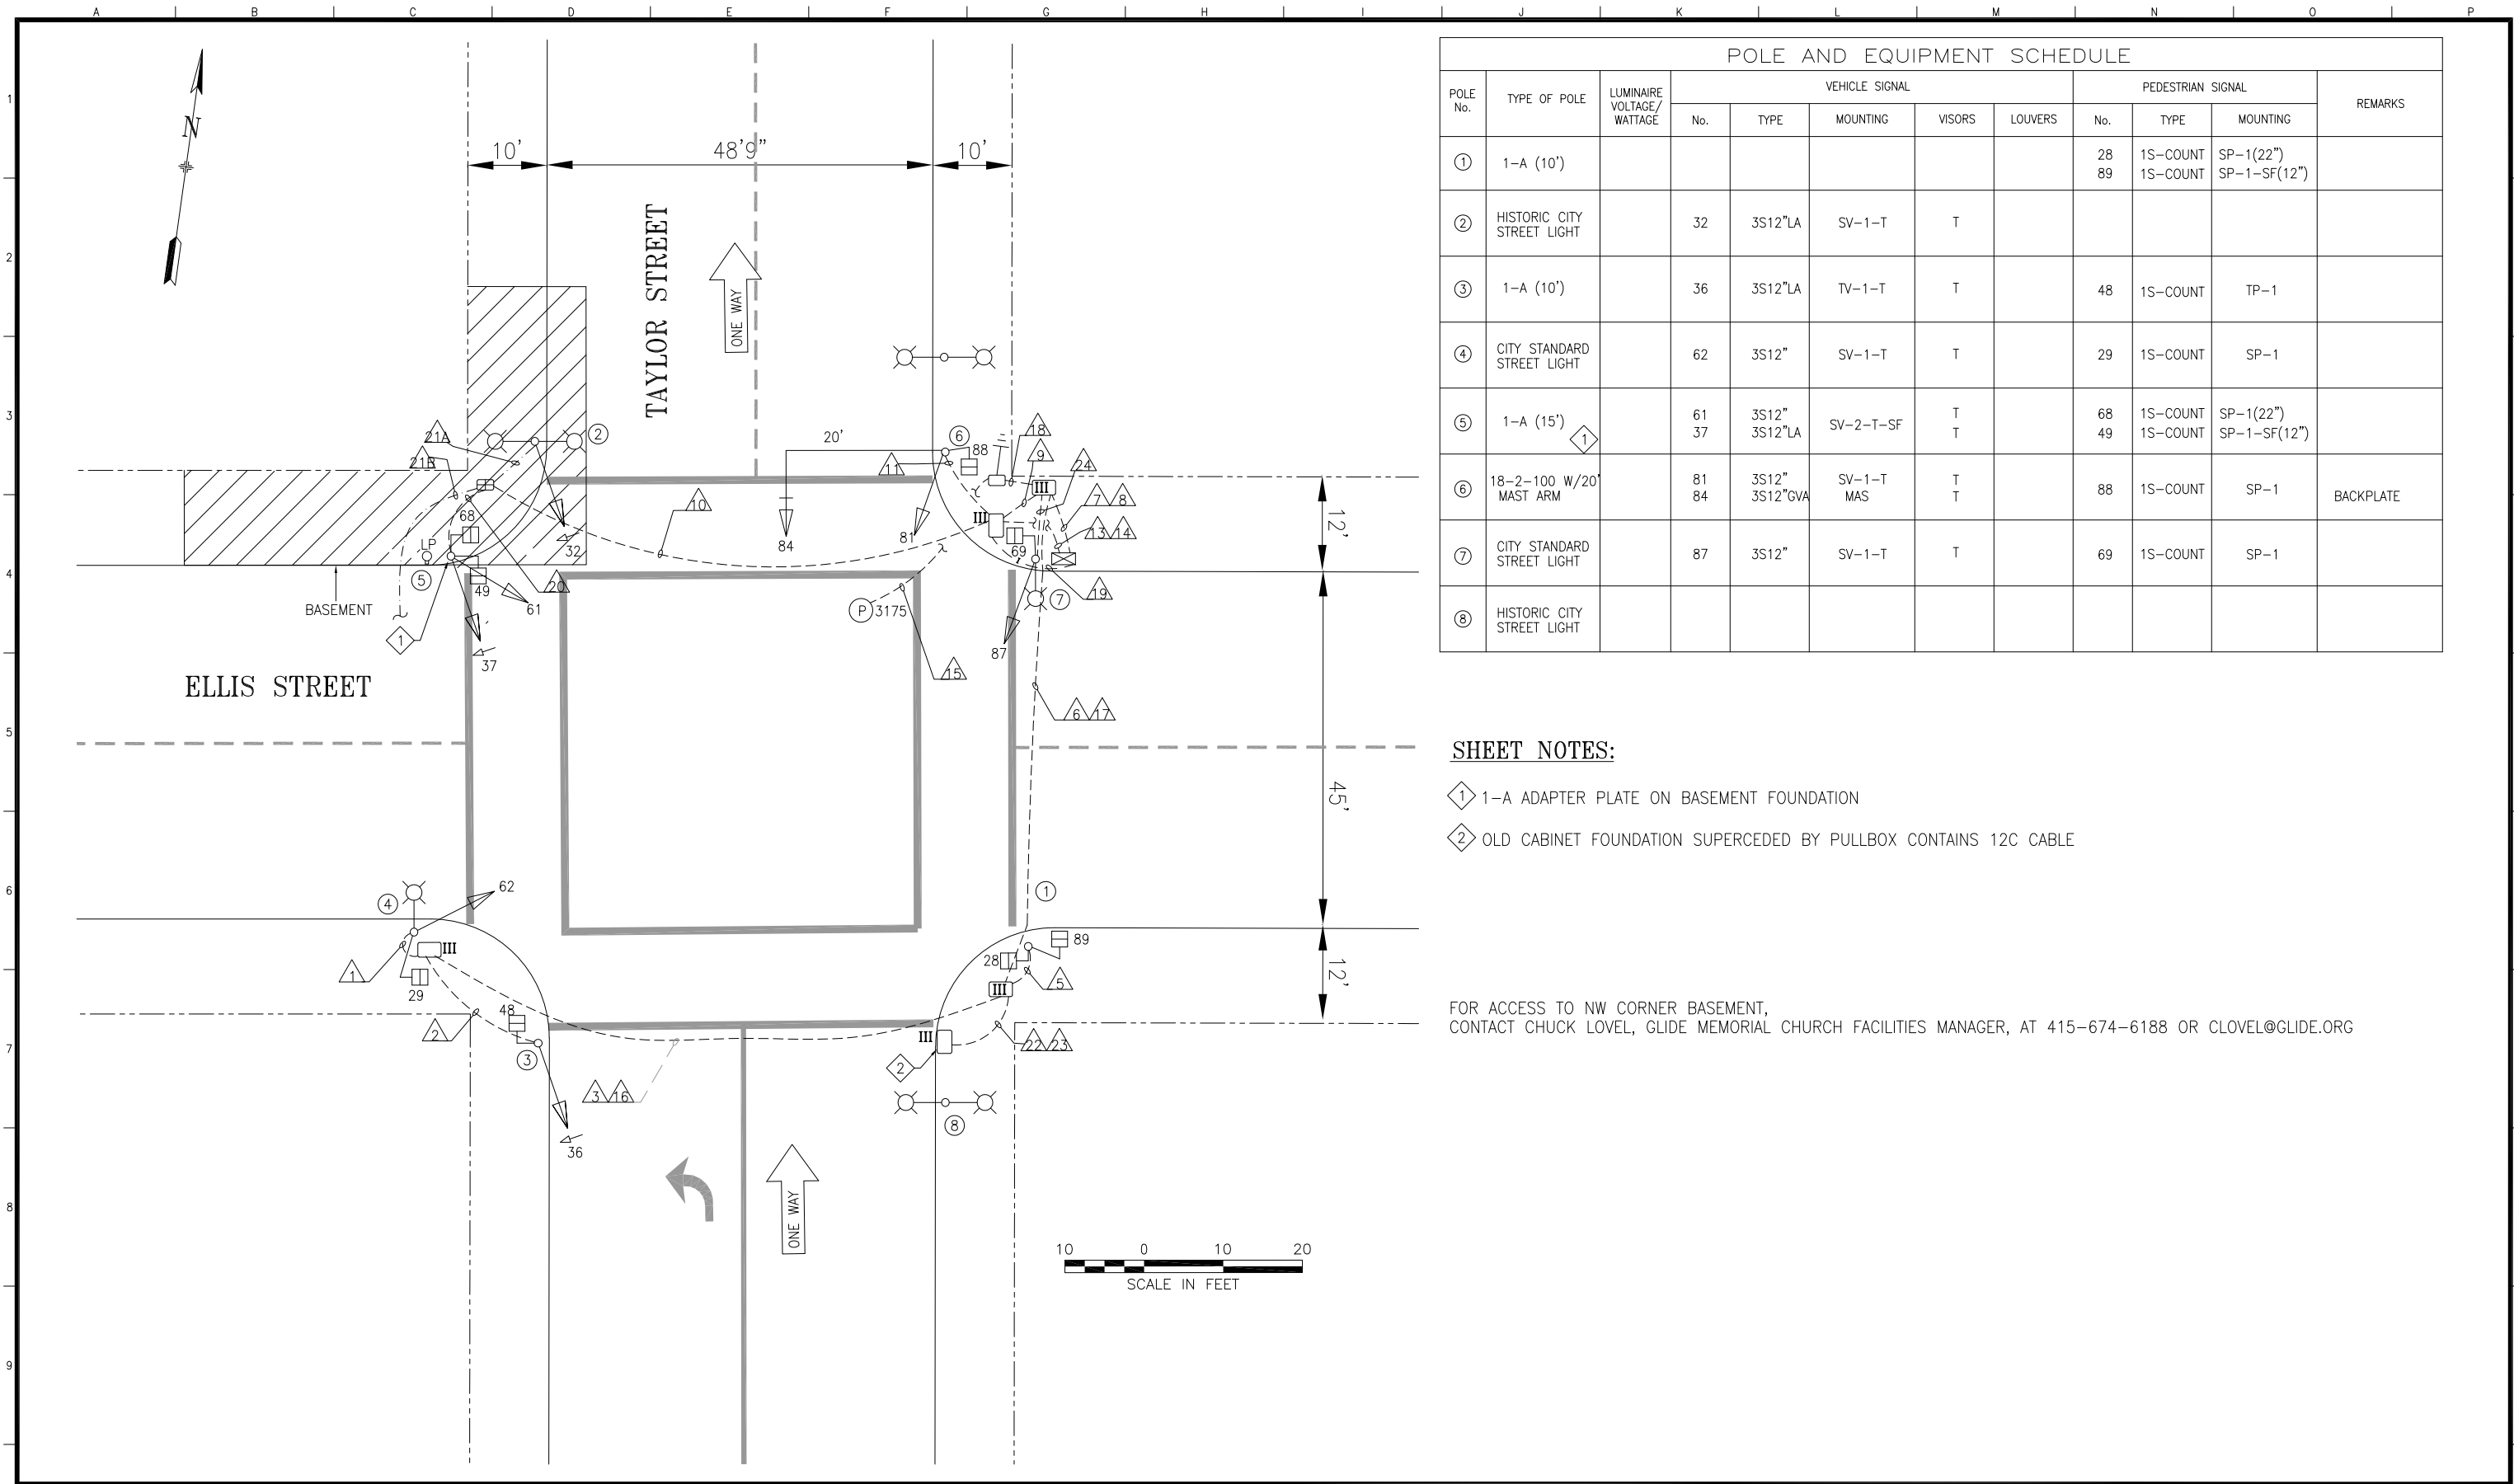

POLE AND EQUIPMENT SCHEDULE											
POLE No.	TYPE OF POLE	LUMINAIRE VOLTAGE/ WATTAGE	VEHICLE SIGNAL					PEDESTRIAN SIGNAL			REMARKS
			No.	TYPE	MOUNTING	VISORS	LOUVERS	No.	TYPE	MOUNTING	
①	1-A (10')							28 89	1S-COUNT 1S-COUNT	SP-1(22") SP-1-SF(12")	
②	HISTORIC CITY STREET LIGHT		32	3S12"LA	SV-1-T	T					
③	1-A (10')		36	3S12"LA	TV-1-T	T		48	1S-COUNT	TP-1	
④	CITY STANDARD STREET LIGHT		62	3S12"	SV-1-T	T		29	1S-COUNT	SP-1	
⑤	1-A (15') 1		61 37	3S12" 3S12"LA	SV-2-T-SF	T T		68 49	1S-COUNT 1S-COUNT	SP-1(22") SP-1-SF(12")	
⑥	18-2-100 W/20' MAST ARM		81 84	3S12" 3S12"GVA	SV-1-T MAS	T T		88	1S-COUNT	SP-1	BACKPLATE
⑦	CITY STANDARD STREET LIGHT		87	3S12"	SV-1-T	T		69	1S-COUNT	SP-1	
⑧	HISTORIC CITY STREET LIGHT										

SHEET NOTES:

- ① 1-A ADAPTER PLATE ON BASEMENT FOUNDATION
- ② OLD CABINET FOUNDATION SUPERCEDED BY PULLBOX CONTAINS 12C CABLE

FOR ACCESS TO NW CORNER BASEMENT,
CONTACT CHUCK LEVEL, GLIDE MEMORIAL CHURCH FACILITIES MANAGER, AT 415-674-6188 OR CLOVEL@GLIDE.ORG

TABLE OF REVISIONS			
NO.	DATE	DESCRIPTION	BY APP.
1	06/19/19	ADD NBLT PHASE 3 VIA SRC 2019-181	GHo MSaloberry
0	11/2/17	SIGNAL UPGRADE BY 2478J, CONVERTED FROM AS-BUILT	DYeung GDeLeon

CHECK WITH TRACING TO SEE IF YOU HAVE LATEST REVISION

REFERENCE INFORMATION & FILE NO. OF SURVEYS



SAN FRANCISCO MUNICIPAL TRANSPORTATION AGENCY

CITY AND COUNTY OF SAN FRANCISCO

DRAWN:	DATE:
DYeung	6/2019
CHECKED:	DATE:
GDeLeon	6/2019

SCALE:
AS SHOWN
SHEET OF SHEETS
1 OF 2

TRAFFIC SIGNAL INVENTORY DIAGRAM
ELLIS STREET AND TAYLOR STREET

CNN NO.
24926000
REV NO.
1

		A	B	C	D	E	F	G	H	I	J	K	L	M	N	O	P															
CONDUIT AND WIRING SCHEDULE (FURNISH AND INSTALL CONDUIT AND WIRES)																																
CONDUIT RUN NUMBER		△1	△2	△3	△5	△6	△7	△8	△9	△10	△11		△13	△14	△15	△16	△17	△18	△19	△20	△21A	△21B	△22	△23	△24							
CONDUIT SIZE (INCH)		2	2	2	2	2	3	2	2	2	2		3	2	3	2	2	2	2	2	2	2	2	2	2							
									SP	GRS				SP		SP	SP			GRS	GRS	GRS	SP	SP								
NOTES																																
	VEHICLE SIGNAL 62	3		3		3	3																									
	PED SIGNAL 29	2		2		2	2																									
	VEHICLE SIGNAL 36		3	3		3	3																									
	PED SIGNAL 48		2	2		2	2																									
	PED SIGNAL 89				2	2	2																									
	PED SIGNAL 28				2	2	2																									
	VEHICLE SIGNAL 61									3			3							3												
	VEHICLE SIGNAL 37									3			3							3												
	VEHICLE SIGNAL 32									3			3								3											
	PED SIGNAL 49									2			2							2												
	PED SIGNAL 68									2			2							2												
	VEHICLE SIGNAL 81										3		3																			
	VEHICLE SIGNAL 84										3		3																			
	PED SIGNAL 88										2		2																			
	VEHICLE SIGNAL 87						3																		3							
	PED SIGNAL 69						2																		2							
	#14 NEUTRAL	2	2		3						3									3	1				2							
	#14 SPARE			3		6	6			3			3								4											
	TOTAL #14 WIRES	7	7	13	10	20	25			16	11		24							13					7							
	#10 WIRES NEUTRAL			1		2	2			1			1																			
	#10 WIRES STREET LIGHT																				2	2										
	#8 WIRES STREET LIGHT																															
	#8 WIRES (120 V SERVICE)							2						2				2														
	#6 BSCW (SEE SHEET NOTE 1)																															
	INTERCONNECT 12C CABLE																		2													

				REFERENCE INFORMATION & FILE NO. OF SURVEYS		 SAN FRANCISCO MUNICIPAL TRANSPORTATION AGENCY CITY AND COUNTY OF SAN FRANCISCO				SCALE:		TRAFFIC SIGNAL INVENTORY DIAGRAM		CNN NO.	
										AS SHOWN				24926000	
1	06/19/19	ADD NB/LT PHASE 3 VIA SRC 2019-181		GHo	MSallaby			DRAWN: DATE:		SHEET OF SHEETS		ELLIS STREET AND TAYLOR STREET		REV NO.	
0	11/2/17	SIGNAL UPGRADE BY 2478J, CONVERTED FROM AS-BUILT		DYeung	GDeLeon			DYeung 6/2019							
NO.	DATE	DESCRIPTION		BY	APP.			CHECKED: DATE:		2 OF 2				1	
TABLE OF REVISIONS CHECK WITH TRACING TO SEE IF YOU HAVE LATEST REVISION								GDeLeon 6/2019							