


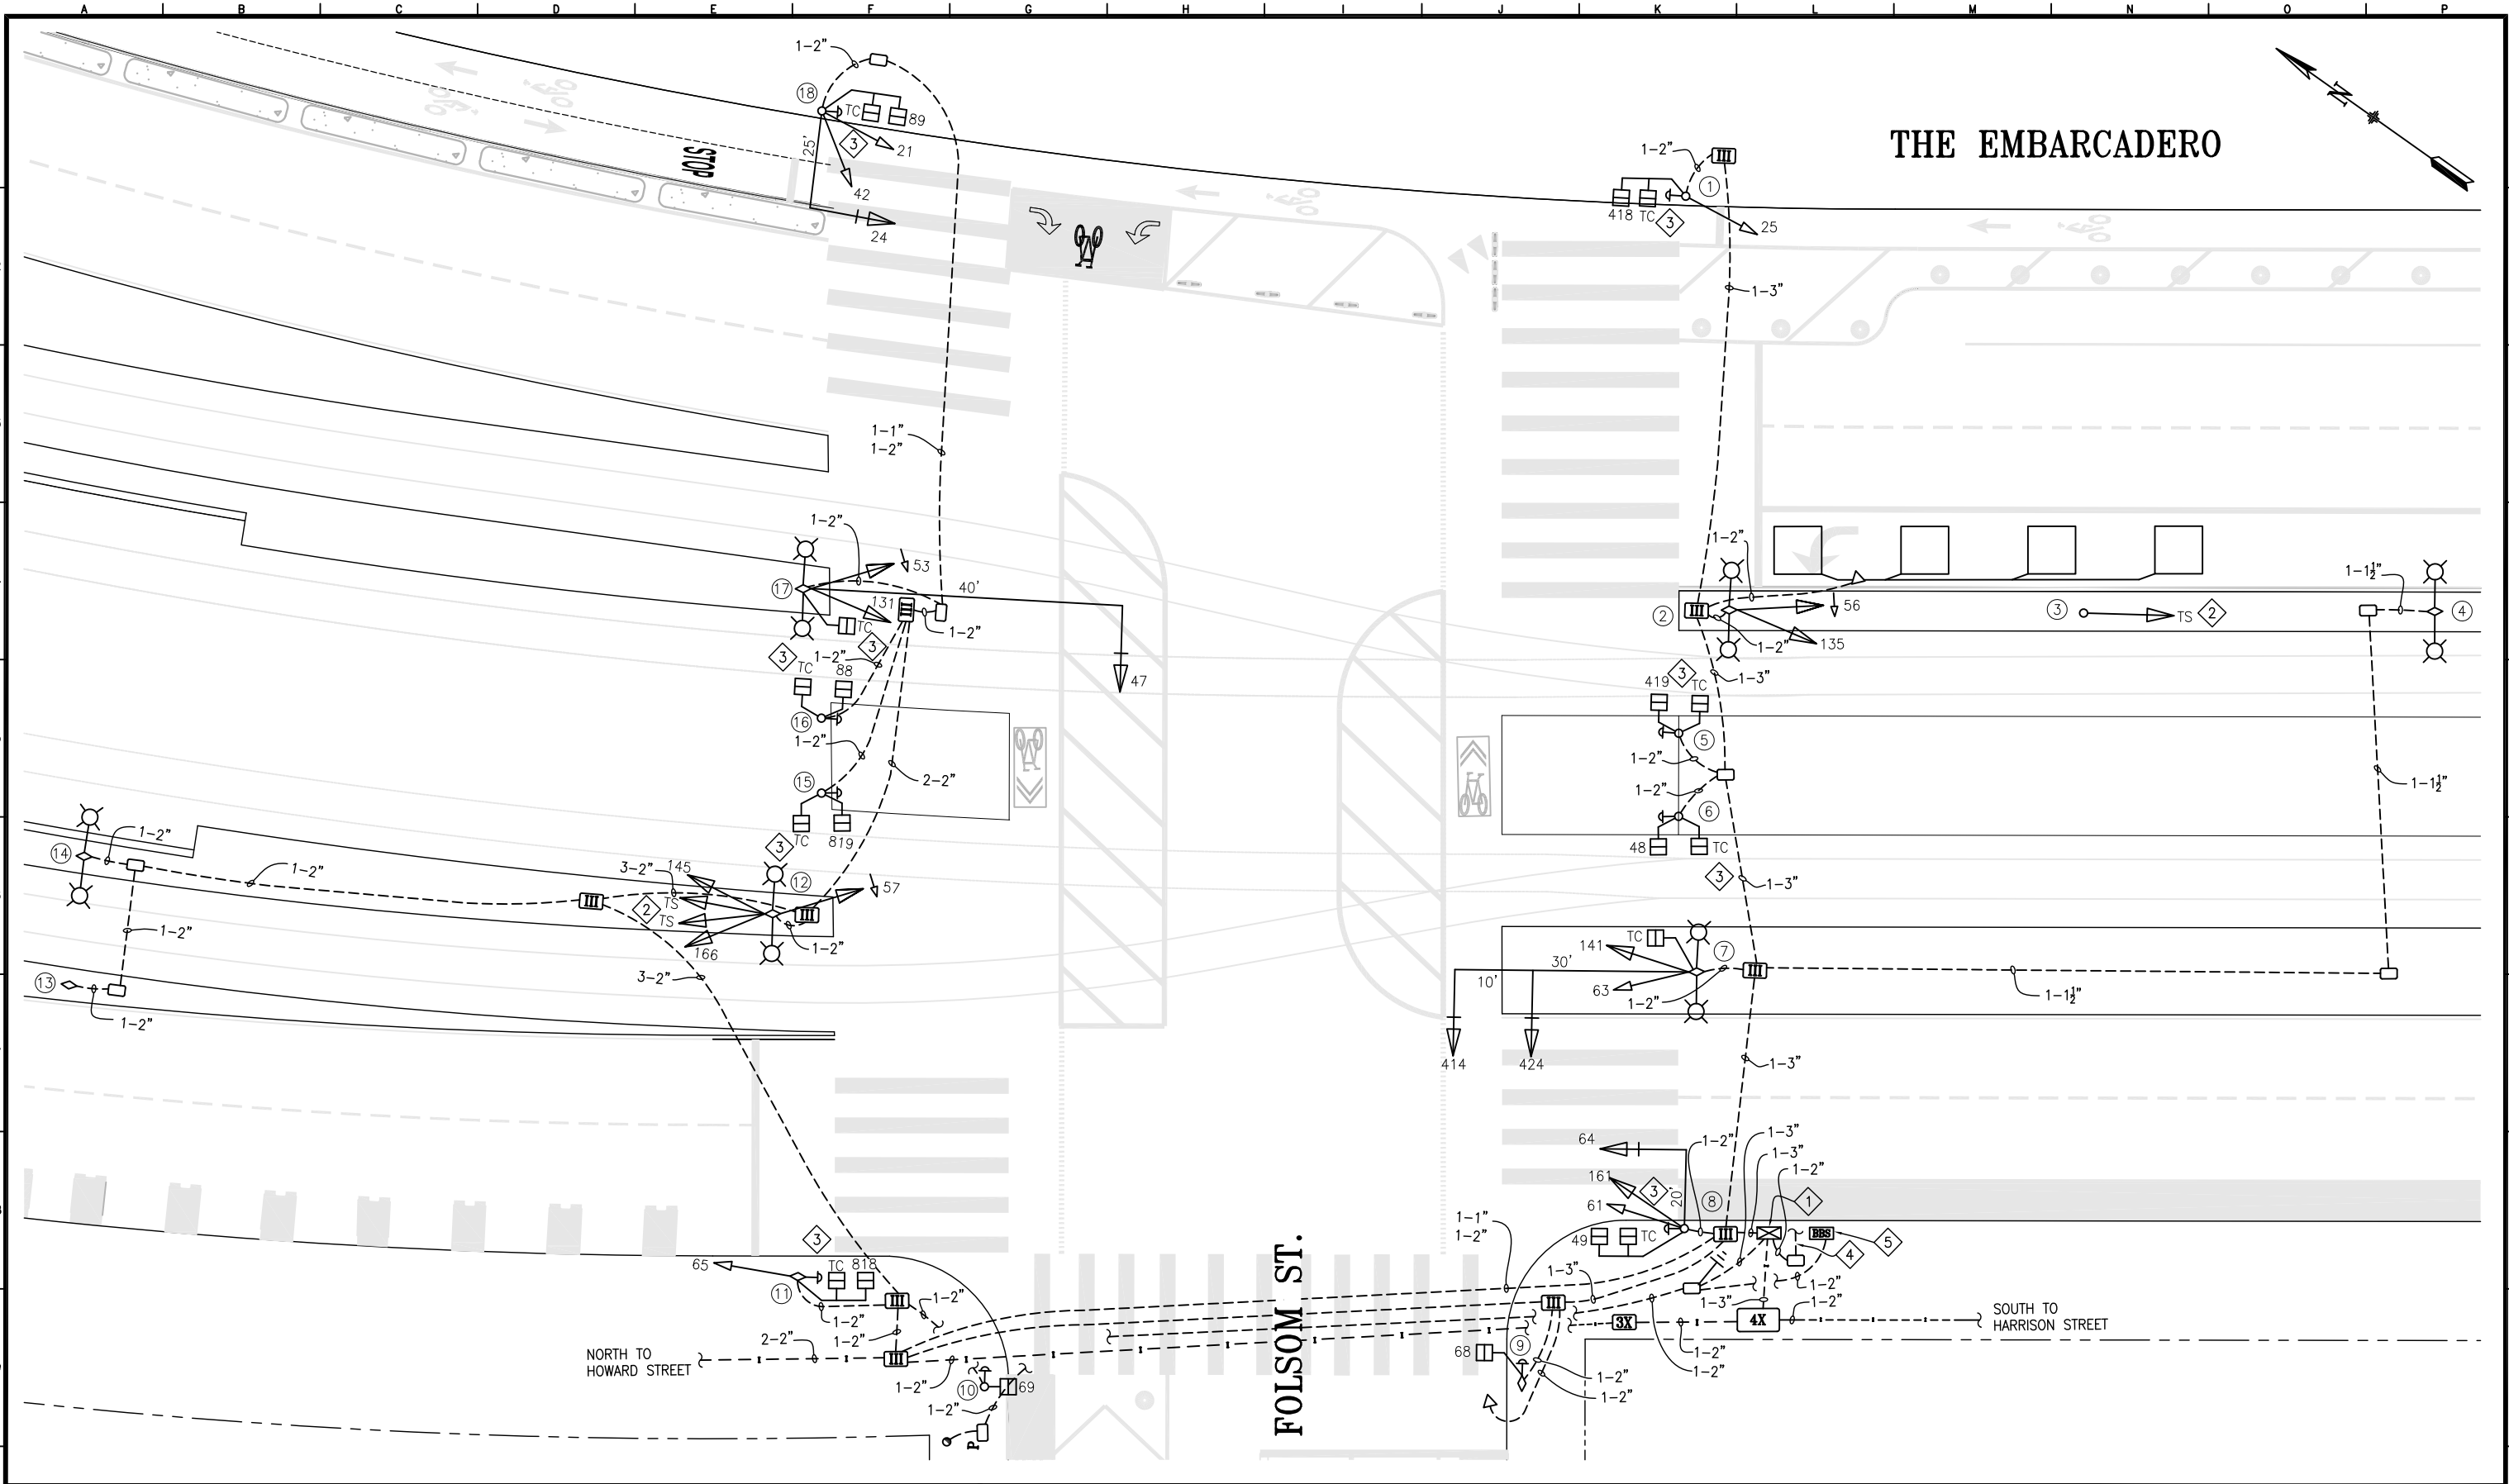

11/20/21	SRC 2021-038: INSTALLED 24"x24" FTCs ON POLES 7 & 17, CONVERTED FROM MSID/CONTRACT 6094Q AS-BUILTS & PER FIELD CHECK		T. YOUNG	M. VELASCO	
NO.	DATE	DESCRIPTION	BY	APPROVED	
TABLE OF REVISIONS CHECKOUT DRAWING THROUGH THE SID CUSTODIAN FOR THE LATEST REVISION					



SFMTA


DRAWN BY:
T. YOUNG
CHECKED BY:
M. VELASCO
DATE:
5/2022
DATE:
5/2022

SCALE
1" = 20'
SHEET OF SHEETS
1 OF 2

TRAFFIC SIGNAL INVENTORY DIAGRAM
THE EMBARCADERO & FOLSOM STREET

CNN NO:
23605000
REV NO:
0

POLE AND EQUIPMENT SCHEDULE											
POLE No.	TYPE OF POLE	LUMINAIRE TYPE	VEHICLE SIGNAL					PEDESTRIAN SIGNAL			REMARKS
			No.	TYPE	MOUNTING	VISORS	LOUVERS/BP	No.	TYPE	MOUNTING	
①	1-A (12')		25	3S8"	TV-1	FC		418 TC	1S-COUNT 1S 16"x16"		APS
②	COMBINATION POLE (POLE #301)		56 135	3S12"LA 2S12"LB	SV-1 SV-1	T T					
③	1-A (10')		TS	4S12"	TV-1-T	T					②
④	NOT USED										
⑤	1-A (7')							419 TC	1S-COUNT 1S 16"x16"	SP-2-T	APS
⑥	1-A (7')							48 TC	1S-COUNT 1S 16"x16"	SP-2-T	APS
⑦	COMBINATION POLE (POLE #302) W/30' MAST ARM		63 141 414 424 TC	3S8" 2S12"LB 3S12" 3S12" 1S 24"x24"	SV-1 SV-1 MAS MAS SP-1	FC T T T T					BACKPLATE BACKPLATE
⑧	16-1-70 W/20' MAST ARM		161 61 64	2S12"LB 3S8" 3S12"	SV-1 SV-1 MAS	T FC T		49 TC	1S-COUNT 1S 16"x16"		APS BACKPLATE
⑨	COMBINATION POLE (POLE #356)							68	1S-COUNT	SP-1	APS
⑩	1-A (7')							69	1S-COUNT	TP-1	APS
⑪	COMBINATION POLE (POLE #352)		65	3S8"	SV-1	FC		818 TC	1S-COUNT 1S 16"x16"		APS
⑫	COMBINATION POLE (POLE #353)		57 145 166 TS TS	3S12"LA 2S12"LB 2S12"LB 3S12" 3S12"	SV-1 SV-1 SV-1 SV-2-T	T T T T T					
⑬	NOT USED										
⑭	NOT USED										
⑮	1-A (7')							819 TC	1S-COUNT 1S 16"x16"	TP-2-T	APS
⑯	1-A (7')							88 TC	1S-COUNT 1S 16"x16"	TP-2-T	APS
⑰	COMBINATION POLE (POLE #354) W/40' MAST ARM		131 53 47 TC	2S12"LB 3S12"LA 3S12" 1S 24"x24"	SV-1 SV-1 MAS SP-1	T T T T					BACKPLATE
⑱	18-1-70 W/25' MAST ARM		42 21 24	3S8" 3S8" 3S12"	SV-2 MAS	FC FC T		49 TC	1S-COUNT 1S 16"x16"		APS BACKPLATE

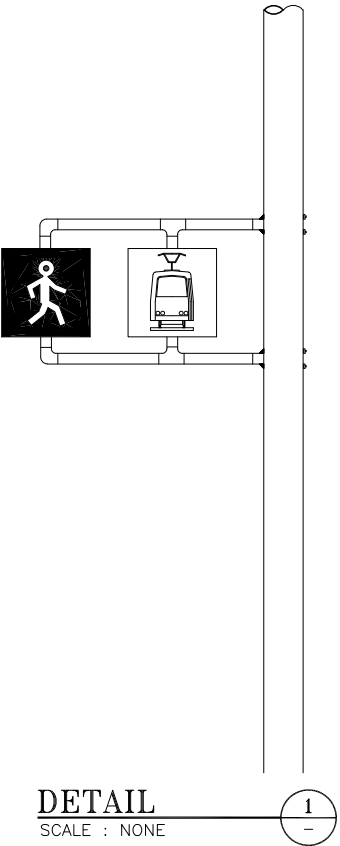

SHEET NOTES:

- ① CABINET FOUNDATION TYPE: M-SF
- ② TS = TRACK SWITCH (4 SECTION (1) - POLE 3: WHITE BALL, AMBER BAR (STRAIGHT), AMBER BAR (R), RED CROSSBUCK
3 SECTION (2) - POLE 12: WHITE BALL, AMBER BAR (STRAIGHT), RED CROSSBUCK
MAINTAINED BY MOW - SHOWN FOR REFERENCE ONLY)
- ③ TC = TRAIN COMING
- ④ TO VTS CABINET - SEE CONTRACT 6094Q, SHEET TE-34 FOR FURTHER DETAILS
- ⑤ BBS = BATTERY BACKUP SYSTEM

--	--	