


PIER 15

The Embarcadero

Green St

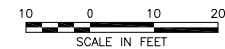

NO.	DATE	DESCRIPTION	BY	APP
	2/17/20	UPDATES PER FIELD.	CXL	CL
	1/16/17	SRC 2019-255: UPGRADED 24"x24" TC ON POLES 2 & 10		
	8/30/14	SRC 2016-354: RELOCATED SIGNALS 135 & 137	AL	MV
	2/19/14	SRC 2014-151: CHANGED PHASE 13 TO LUNAR BARS	JT	BW
		SRC 2013-182: REMOVED SIGNAL HEADS 11, 12, 16,	PPY	JT
		82, 84, 85, 87		
TABLE OF REVISIONS CHECK WITH TRACING TO SEE IF YOU HAVE LATEST REVISION				

REFERENCE INFORMATION & FILE NO. OF SURVEYS
SPECIFICATION NO. 7151E DRAWINGS ET-8, ET-20 & ET-21
CONTRACT NO. 1975J DRAWING E-1.0



SAN FRANCISCO MUNICIPAL TRANSPORTATION AGENCY
CITY AND COUNTY OF SAN FRANCISCO

DRAWN:	DATE:
JT/MFR	11/2013
CHECKED:	DATE:
BBD	11/2013

SCALE: AS SHOWN	TRAFFIC SIGNAL INVENTORY DIAGRAM	CNN NO. 50158000
SHEET OF SHEETS 1 OF 2	THE EMBARCADERO AND GREEN STREET	REV NO. 4

POLE No.	TYPE OF POLE	LUMINAIRE VOLTAGE/WATTAGE	VEHICLE SIGNAL					PEDESTRIAN SIGNAL			REMARKS
			No.	TYPE	MOUNTING	VISORS	LOUVERS	No.	TYPE	MOUNTING	
①	18-1-70 WITH 25' SIGNAL ARM		61 64	3S8" 3S12"	SV-1 MAS	T T		49 68	1S-COUNT 1S-COUNT	SP-2	PPB; SIGNAL 82 IS BAGGED
②	MUNI STREETLIGHT WITH 35' SIGNAL ARM		44 45 133	3S12" 3S12" 2S12" LB	MAS MAS SV-1	T T T		48 419 TC	1S-COUNT 1S-COUNT 1S 24"x24"	DETAIL 1	SIGNALS 11 & 87 ARE BAGGED
③	STREETLIGHT		56 135	3S12"LA 2S12" LB	SV-1 SV-1	T T		418 429 TC	1S-COUNT 1S-COUNT TRAIN COMING	DETAIL 1	SIGNAL 12 IS BAGGED
④	MUNI STREETLIGHT		25	3S8"	SV-1	T		428	1S-COUNT	SP-1	PPB; SIGNAL 23 IS A BIKE SIGNAL
⑤	16-1-70 WITH 20' SIGNAL ARM		24	3S12"	MAS	T					
⑥	MUNI STREETLIGHT WITH 40' SIGNAL ARM		47 131	3S12" 2S12" LB	MAS SV-1	T T					SIGNALS 84 & 85 ARE BAGGED
⑦	1-A (12')		52	3S12"LA	TV-1-T	T		818 829 TC	1S-COUNT 1S-COUNT TRAIN COMING	DETAIL 1	PPB; SIGNAL 16 IS BAGGED
⑧	1-A (10')		65	3S8"	TV-1	T		828 69	1S-COUNT 1S-COUNT	SP-2	PPB
⑨	1-A (10')		21 42	3S12" 3S12"	TV-2-T	T T		89	1S-COUNT	SP-1	PPB; SIGNAL 27 IS A BIKE SIGNAL
⑩	1-A (12')		51	3S12"LA	TV-1-T	T		88 819 TC TC	1S-COUNT 1S-COUNT TRAIN COMING 1S 24"x24"	DETAIL 1 SP-1	PPB
⑪	PPB POST										PPB
⑫	PPB POST										PPB
⑬	MUNI STREETLIGHT										NOT USED
⑭	STREETLIGHT										NOT USED
⑮	STREETLIGHT		137	2S12" LB	SV-1	T					

NOTES:

- NOTES:
1. CABINET FOUNDATION TYPE: M
 2. TO VETAG CABINET - SEE SPECIFICATION NO. 6094Q, SHEET TE-22 FOR FURTHER DETAILS
 3. TC = TRAIN COMING

A	2/17/20	UPDATES PER FIELD.	CXL	CL
A	1/16/17	SRC 2019-255: UPGRADED 24"x24" TC ON POLES 2 & 10		
A	8/30/14	SRC 2016-354: RELOCATED SIGNALS 135 & 137	AL	MV
A	2/19/14	SRC 2014-151: CHANGED PHASE 13 TO LUNAR BARS	JT	BW
A	2/19/14	SRC 2013-182: REMOVED SIGNAL HEADS 11, 12, 16, 82, 84, 85, 87	PPY	JT
NO.	DATE	DESCRIPTION	BY	APP.
TABLE OF REVISIONS CHECK WITH TRACING TO SEE IF YOU HAVE LATEST REVISION				

REFERENCE INFORMATION
& FILE NO. OF SURVEYS

SPECIFICATION NO. 7151E
DRAWINGS ET-8, ET-20 &
ET-21

CONTRACT NO. 1975J
DRAWING E-1.0



SAN FRANCISCO MUNICIPAL TRANSPORTATION AGENCY
CITY AND COUNTY OF SAN FRANCISCO

DRAWN:	DATE:
JT/MFR	11/2013
CHECKED:	DATE:
BBD	11/2013

SCALE:

NO SCALE


SHEET OF SHEETS

2 OF 2

TRAFFIC SIGNAL INVENTORY DIAGRAM
THE EMBARCADERO AND GREEN STREET

CNN NO. 50158000
REV NO. 4

DETAIL: REFERENCE 1

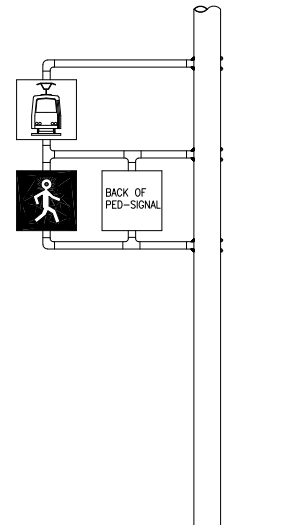

DETAIL

SCALE : NONE

