



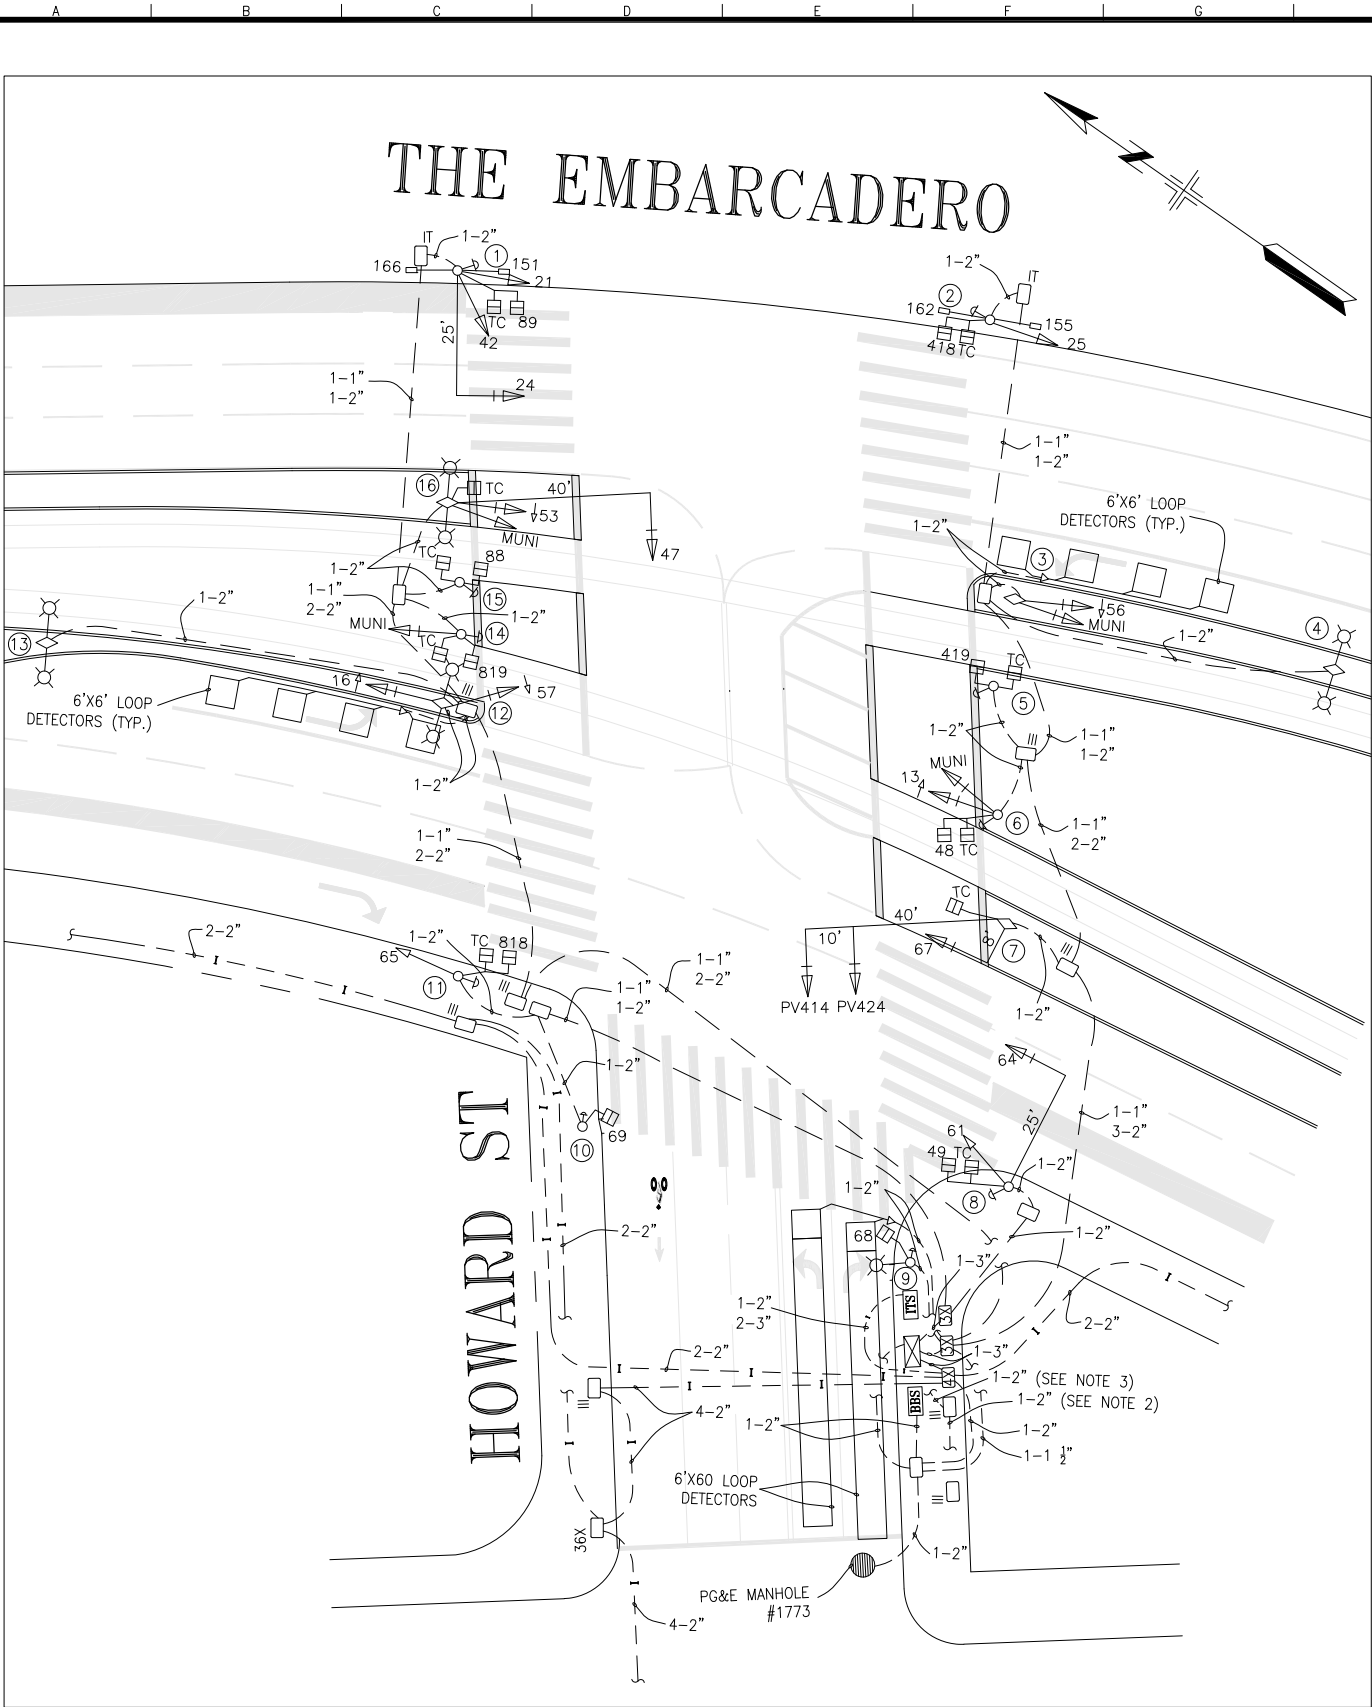

POLE AND EQUIPMENT SCHEDULE										
POLE No.	TYPE OF POLE	VEHICLE SIGNAL					PEDESTRIAN SIGNAL			REMARKS
		No.	TYPE	MOUNTING	VISORS	LOUVERS	No.	TYPE	MOUNTING	
①	18-1-70 WITH 25' MAST ARM	24 21 42 151 166	3S12" 3S12" 3S12" 3S8"BIKE 3S8"BIKE	MAS SV-2-TC SV-2-TC	T T T T T		89 TC	1S-COUNT 1S 16"X16"		BACKPLATE, PPB 21/42 MOUNTED AT 11.5' 151/166 MOUNTED AT 8' 151/166 SPLICED TO 21
②	1-A (12')	25 162 155	3S12" 3S8"BIKE 3S8"BIKE	TV-1-T SV-2-TA	T T T		418 TC	1S-COUNT 1S 16"X16"		PPB 162/155 MOUNTED AT 9' 155 SPLICED TO 162
③	COMBINATION POLE (POLE #328)	56 MUNI	3S12"LA 2S12" LB	SV-1 SV-1	T T					BACKPLATE BACKPLATE
④	COMBINATION POLE (POLE #329)									NOT USED
⑤	1-A (7')						419 TC	1S-COUNT 1S 16"X16"	TP-2-T	PPB
⑥	1-A (15')	13 MUNI	3S12"LA 2S12" LB	SV-1 TV-1	T T		48 TC	1S-COUNT 1S 16"X16"	 SP-1	BACKPLATE, PPB BACKPLATE
⑦	COMBINATION POLE (POLE #325) (WITH 8' & 40' MAST ARMS)	67 PV414 PV424	3S12" 3S12" PV 3S12" PV	MAS MAS MAS	T T T		TC	1S 24"X24"		BACKPLATE BACKPLATE BACKPLATE
⑧	18-1-70 WITH 25' MAST ARM	61 64	3S8" 3S12"	SV-1 MAS	T T		49 TC	1S-COUNT 1S 16"X16"		PPB BACKPLATE
⑨	CITY STANDARD STREETLIGHT POLE						68	1S-COUNT	SP-1	APS
⑩	1-A (7')						69	1S-COUNT	TP-1	APS
⑪	1-A (12')	65	3S8"	TV-1	T		818 TC	1S-COUNT 1S 16"X16"		PPB
⑫	COMBINATION POLE (POLE #323)	16 57	3S12"LA 3S12"LA	SV-1 SV-1	T T					BACKPLATE BACKPLATE
⑬	COMBINATION POLE (POLE #321)									NOT USED
⑭	1-A (15')	MUNI	2S12" LB	TV-1-T	T		819 TC	1S-COUNT 1S 16"X16"	SV-1 SV-1	BACKPLATE, PPB
⑮	1-A (7')						88 TC	1S-COUNT 1S 16"X16"	TP-2-T	PPB
⑯	COMBINATION POLE (POLE #324) (WITH 40' MAST ARM)	47 53 MUNI	3S12" 3S12"LA 2S12" LB	MAS SV-1 SV-1	T T T		TC	1S 24"X24"		BACKPLATE BACKPLATE

NOTES:
1. CABINET FOUNDATION TYPE: M
2. TO VETAG CABINET - SEE SPECIFICATION NO. 6094Q, SHEET TE-35 FOR FURTHER DETAILS
3. TO M-SF CABINET
4. TC = TRAIN COMING
5. BBS = BATTERY BACKUP SYSTEM

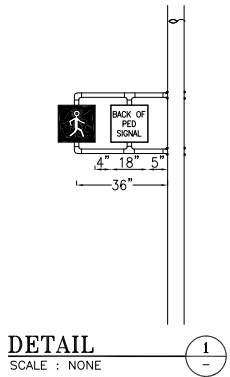

NO.	DATE	DESCRIPTION	BY	APPROVED
1	11/20/21	SRC 2021-038: INSTALLED 24"x24" FTC SIGNALS ON POLES 7 & 16, REMOVED 16"x16" FROM POLE 6	T. YOUNG	M. VELASCO
2	11/20/20	CONVERTED FROM MSID; UPDATE PER FIELD; SRC 2020-274 BIKE SIGNALS	P. PANYAM	G. HO
TABLE OF REVISIONS CHECKOUT DRAWING THROUGH THE SID CUSTODIAN FOR THE LATEST REVISION				



SFMTA

DRAWN BY:
P. PANYAM

DATE:
2/23/2022

CHECKED BY:
G. HO

DATE:
2/23/2022

SCALE
1" = 20'

SHEET OF SHEETS
01 OF 01

TRAFFIC SIGNAL INVENTORY DIAGRAM

THE EMBARCADERO AND HOWARD STREET

CNN NO:
23597000

REV NO:
1