


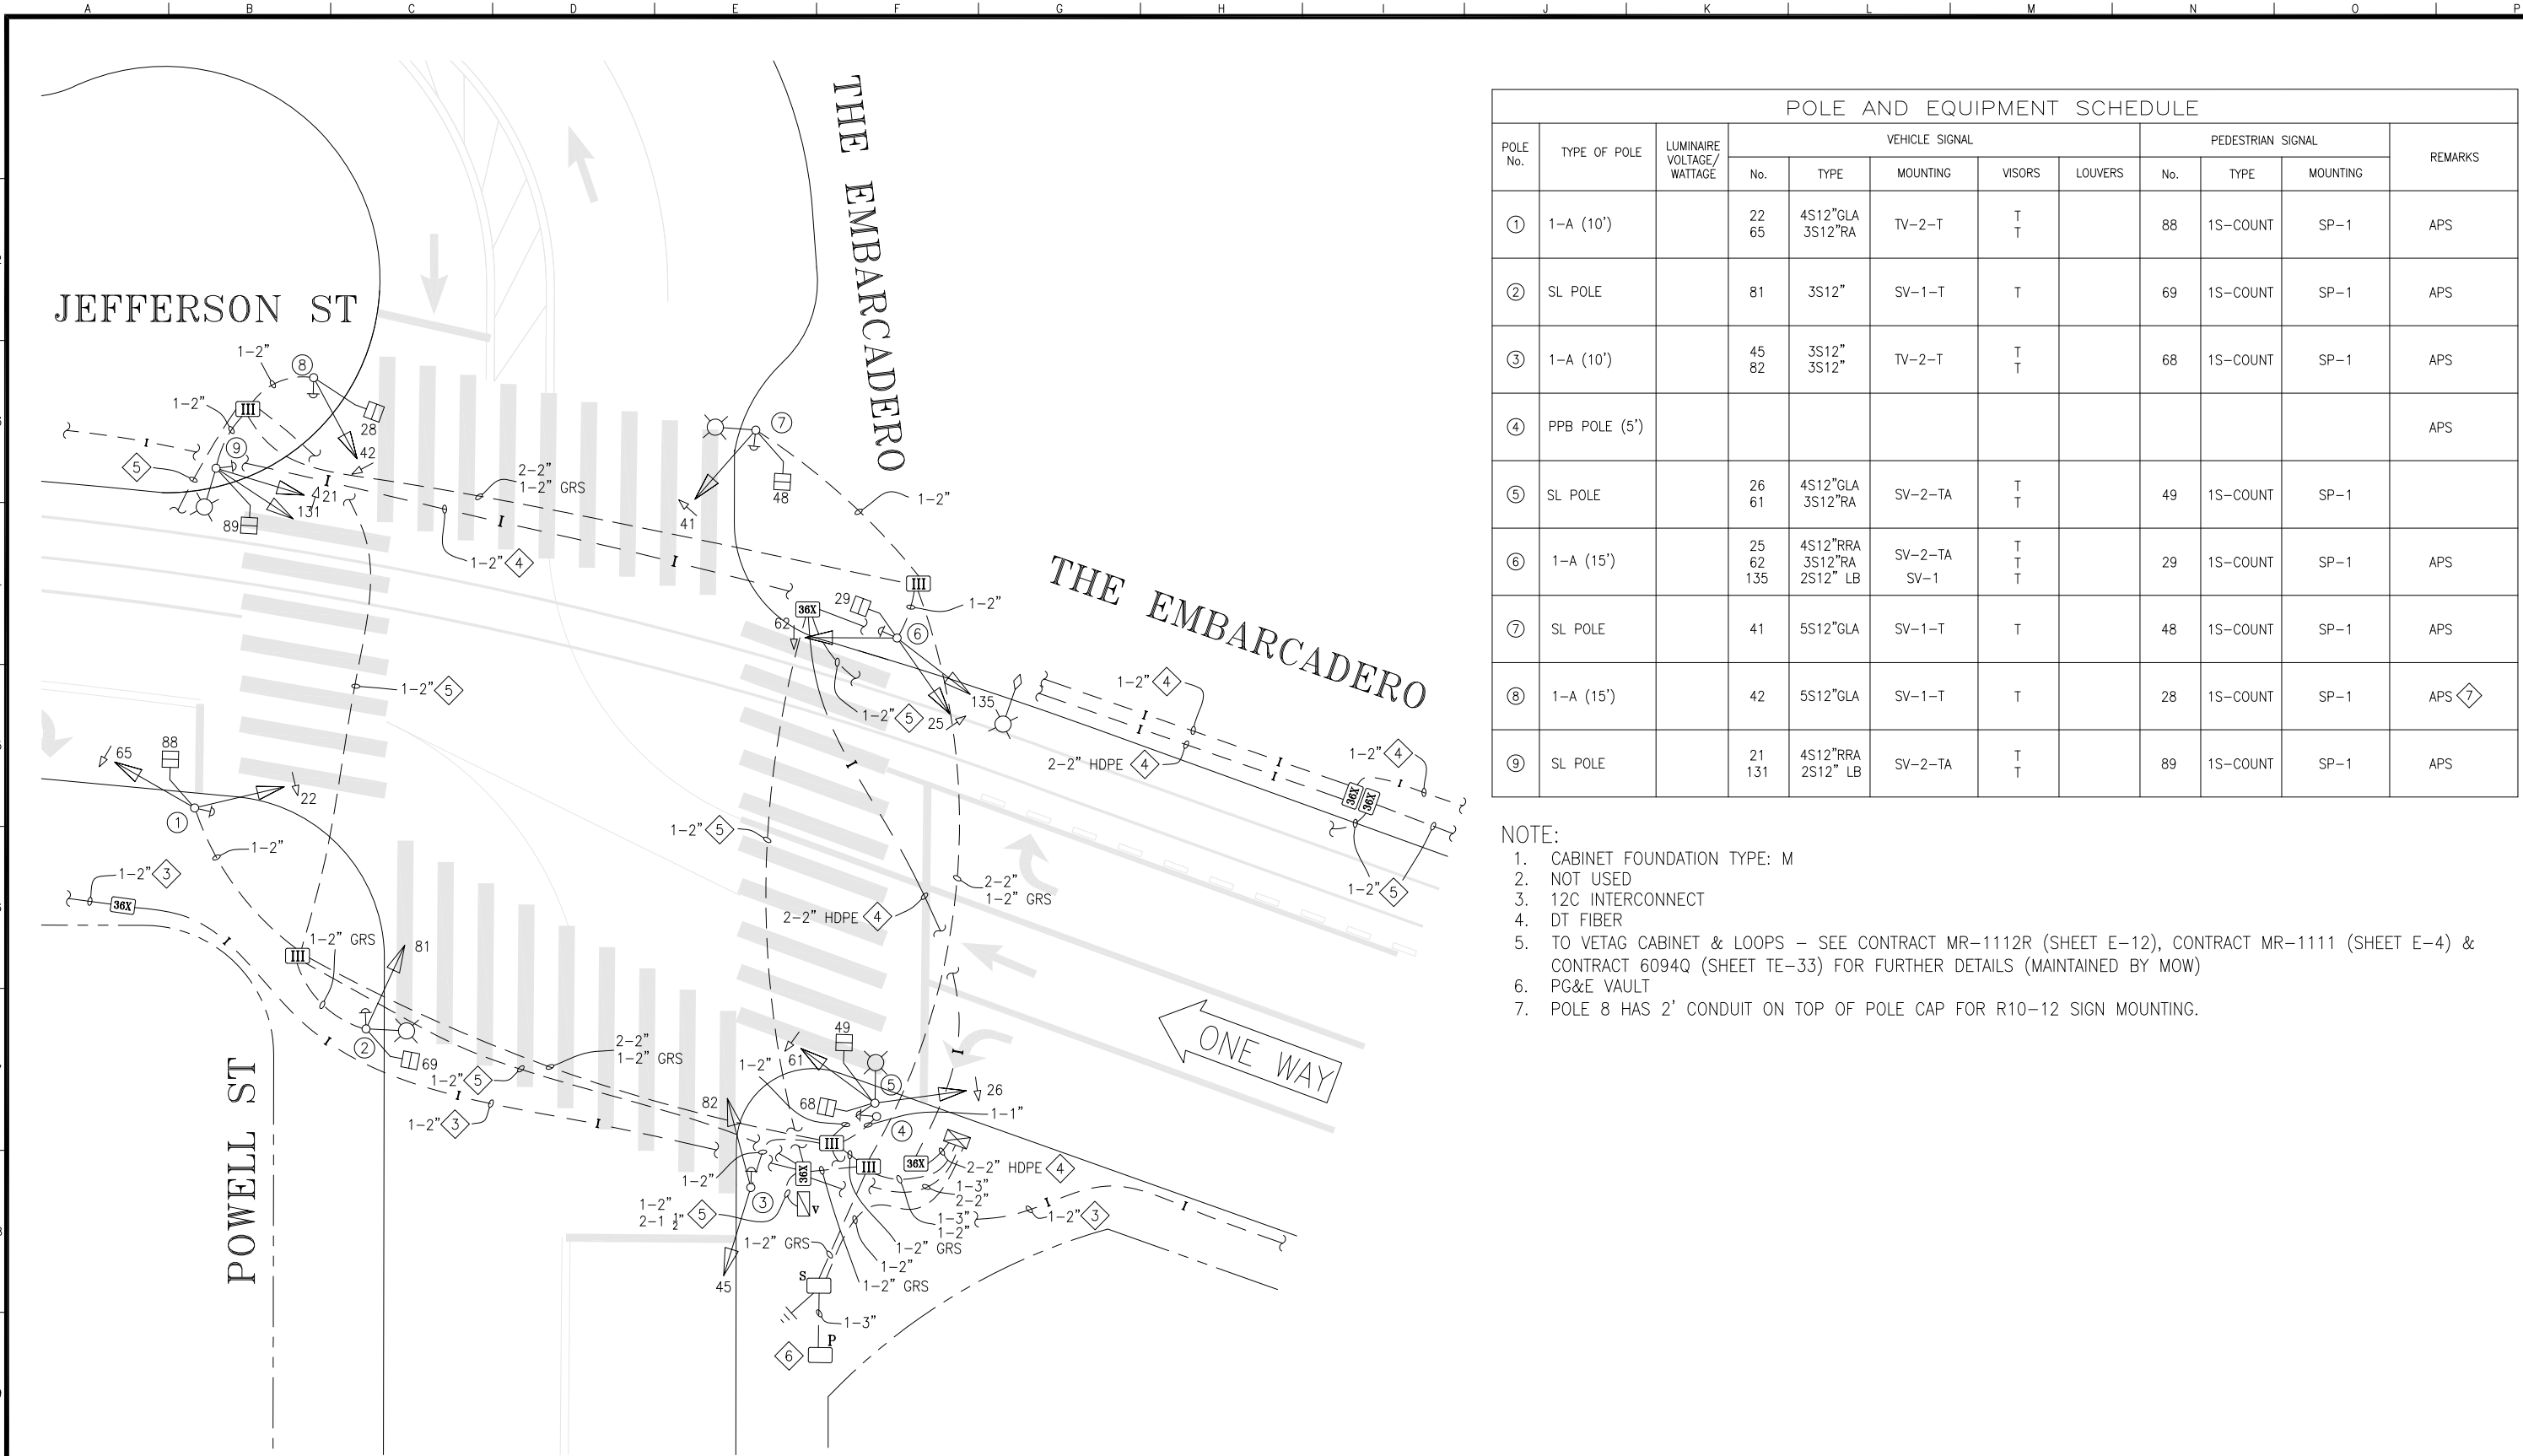

POLE AND EQUIPMENT SCHEDULE											
POLE No.	TYPE OF POLE	LUMINAIRE VOLTAGE/ WATTAGE	VEHICLE SIGNAL					PEDESTRIAN SIGNAL			REMARKS
			No.	TYPE	MOUNTING	VISORS	LOUVERS	No.	TYPE	MOUNTING	
①	1-A (10')		22 65	4S12"GLA 3S12"RA	TV-2-T	T T		88	1S-COUNT	SP-1	APS
②	SL POLE		81	3S12"	SV-1-T	T		69	1S-COUNT	SP-1	APS
③	1-A (10')		45 82	3S12" 3S12"	TV-2-T	T T		68	1S-COUNT	SP-1	APS
④	PPB POLE (5')										APS
⑤	SL POLE		26 61	4S12"GLA 3S12"RA	SV-2-TA	T T		49	1S-COUNT	SP-1	
⑥	1-A (15')		25 62 135	4S12"RRA 3S12"RA 2S12" LB	SV-2-TA SV-1	T T T		29	1S-COUNT	SP-1	APS
⑦	SL POLE		41	5S12"GLA	SV-1-T	T		48	1S-COUNT	SP-1	APS
⑧	1-A (15')		42	5S12"GLA	SV-1-T	T		28	1S-COUNT	SP-1	APS 
⑨	SL POLE		21 131	4S12"RRA 2S12" LB	SV-2-TA	T T		89	1S-COUNT	SP-1	APS

NOTE:

1. CABINET FOUNDATION TYPE: M
2. NOT USED
3. 12C INTERCONNECT
4. DT FIBER
5. TO VETAG CABINET & LOOPS – SEE CONTRACT MR-1112R (SHEET E-12), CONTRACT MR-1111 (SHEET E-4) & CONTRACT 6094Q (SHEET TE-33) FOR FURTHER DETAILS (MAINTAINED BY MOW)
6. PG&E VAULT
7. POLE 8 HAS 2' CONDUIT ON TOP OF POLE CAP FOR R10-12 SIGN MOUNTING.

3	7/13/21	SRC 2021-127: INSTALLED APS	TY	MV
2	4/1/21	SRC 2021-002: CHANGED SIGNALS 41/42 TO 5S12"GLA, CHANGED POLE 8 TO 1-A (15') CUSTOM & CHANGED SIGNAL 42 MOUNTING TO SV-1-T	AL	ET
1	3/1/21	CONTRACT 2768J/1000011498 (PC06): CHANGED POLE 6 TO 1-A (15') & CHANGED SIGNALS 25/62 MOUNTING TO SV-2-TA	TY	MV
0	8/26/20	SRC 2020-179: CONTRACT 2768J/1000011498 SWITCHOVER CONVERTED FROM 1949J/MR-11112R AS-BUILTS	TY	MV
NO.	DATE	DESCRIPTION	BY	APP.
TABLE OF REVISIONS CHECK WITH TRACING TO SEE IF YOU HAVE LATEST REVISION				

REFERENCE INFORMATION & FILE NO. OF SURVEYS

CONTRACT MR-1112R
DRAWINGS E-12 & E-20
SPECIFICATION NO. 1949J
DRAWING E-PC07
CONTRACT 2768J/1000011498
DRAWINGS ET-4.1 & ET-4.2
SPECIFICATION NO. 7443E
DRAWINGS P-4, P-4.1 & P-4.2
CONTRACT MR-1111
DRAWING E-4
CONTRACT 6094Q
DRAWING TE-33



SAN FRANCISCO MUNICIPAL TRANSPORTATION AGENCY

CITY AND COUNTY OF SAN FRANCISCO

DRAWN:	DATE:
TY	04/2021
CHECKED:	DATE:
MV	04/2021

SCALE:
1" = 10'
SHEET OF SHEETS
1 OF 1

TRAFFIC SIGNAL INVENTORY DIAGRAM
EMBARCADERO, JEFFERSON ST & POWELL ST

CNN NO.
25484000
REV NO.
3