


EMBARCADERO / DELANCEY (MIDBLOCK OF TOWNSEND / BRANNAN)

* 88, 89B are two head PED signals.

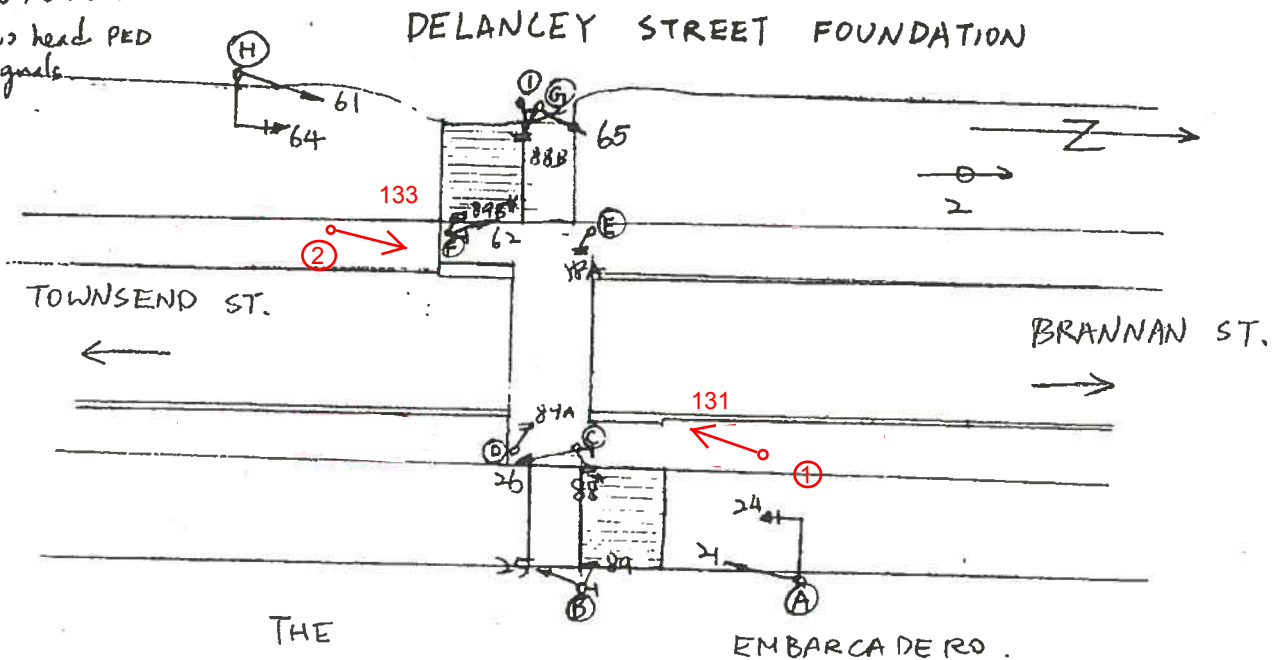

4/9/2017

[illegible]

CONTROLLER CABINET SIZE: Type R BASE CABINET: LMD 40 CONTROLLER.

COMMENTS:

REMOVED AND RENUMBERED TRANSIT SIGNALS PER SRC 2017-070 - A. LAM