


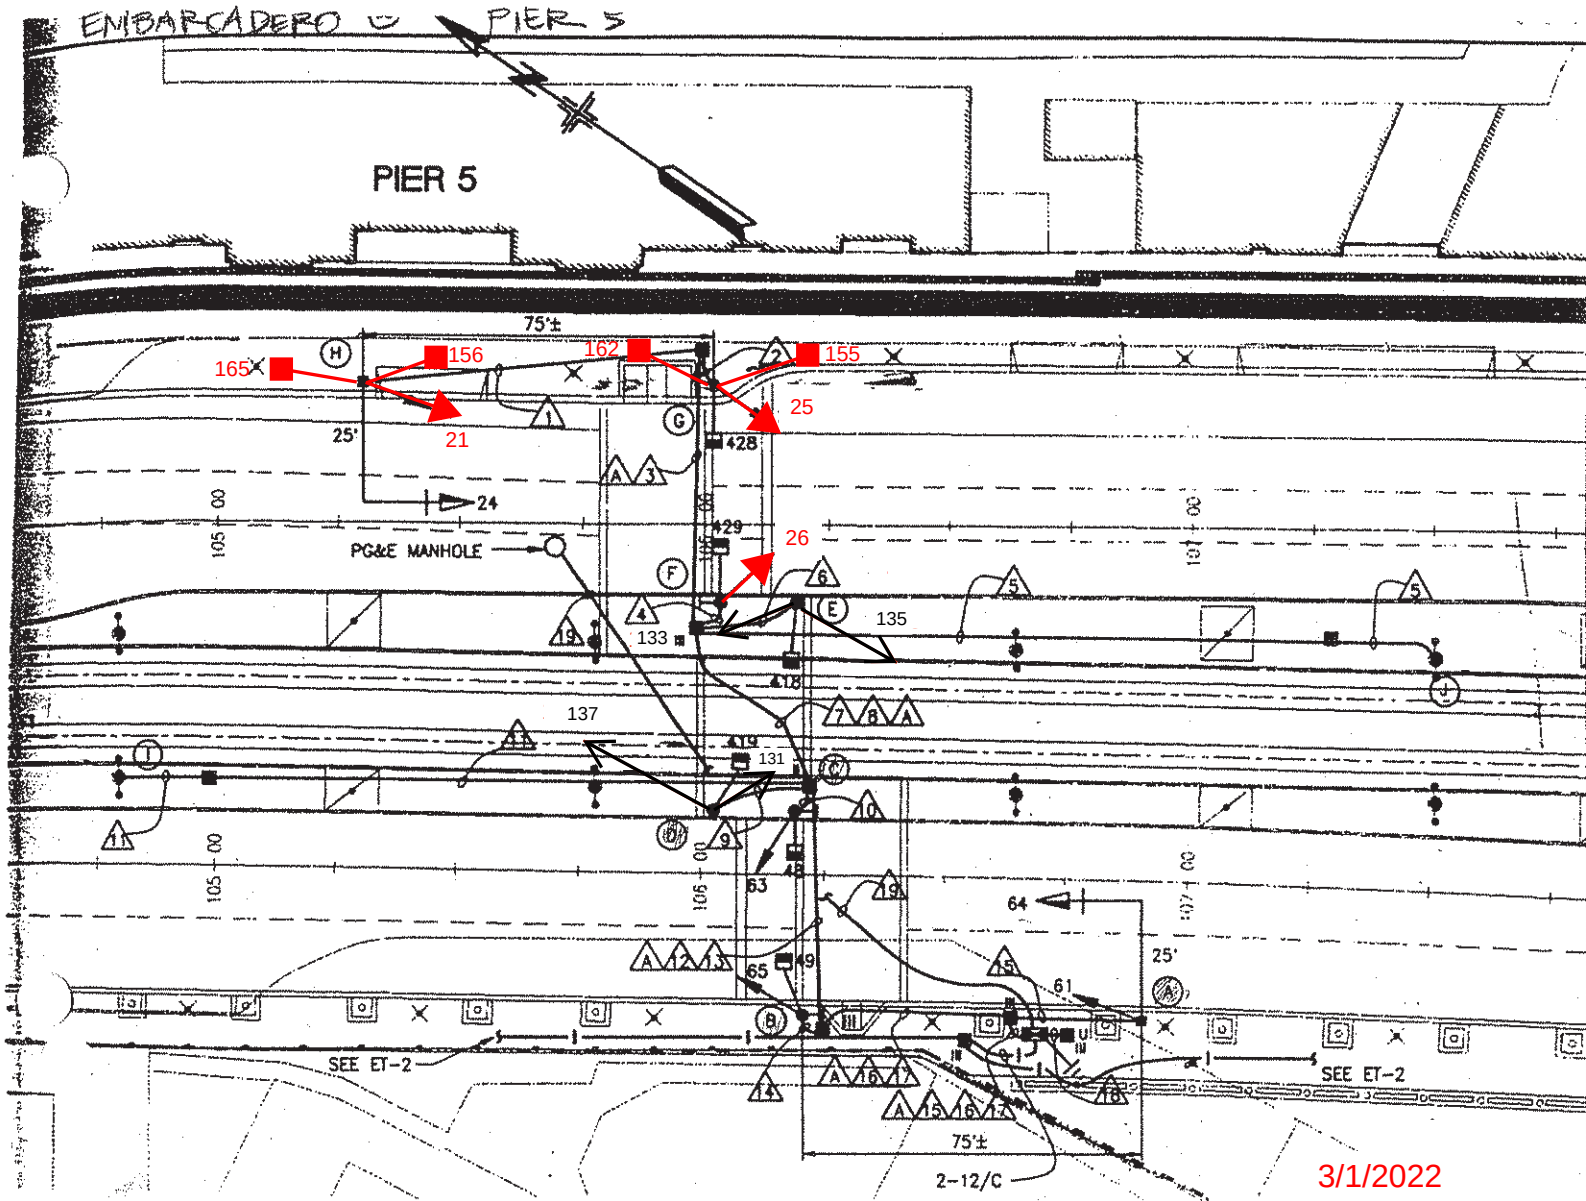

POLE	FUNC.	MAT'L	SIGNAL NO.	MAKE	NO. OF SECT.	SIZE	VISOR	B.P. OR LOUVERS	MOUNT	PED SIGNAL NO.	LEGEND	MESSAGE		MAKE	MOUNT
A	S	S	61	TCT	3S	8" RYG	T	—	SV-1	49	I	1S-IN	W/OR	ICC	SP
B	S	S	64	TCT	3S	12" RYG	T	B.P.	MAS	48	I	1S-IN	W/OR	ICC	SP
C	S	S	65	TCT	3S	8" RYG	T	—	TV-1	419	I	1S-IN	W/OR	ICC	SP
D	S	S	63	TCT	3S	8" RYG	T	—	TV-1	418	I	1S-IN	W/OR	ICC	SP
E	S	S	133	TCT	2S	12" LB	T	BP	TV-2	429	I	1S-IN	W/OR	ICC	SP
F	S	S	135	TCT	2S	12" LB	T	BP	TV-2	428	I	1S-IN	W/OR	ICC	SP
G	S	S	25	TCT	3S	3S12"	T	—	TV-1-T						
H	S	S	26	TCT	3S	3S12"	T	—	TV-1-T						
I	M	S	21	TCT	3S	3S12"	T	—	SV-1-T@11.5'						
J	M	S	24	TCT	3S	12" RYG	T	B.P.	MAS						
			137	TCT	2S	12" LB	T	BP	TV-2						
			131	TCT	2S	12" LB	T	BP	TV-2						
			165			3S8" bike	T		SV-2-TA@8'						
			156			3S8" bike	T		SV-2-TA@8'						

CONTROLLER CABINET SIZE : M-cabinet BASE CABINET: _____

COMMENTS :

Add signals 155, 156, 162, 165. Update 21, 25, 26 to 3S12" per SRC 2021-300. - G. Ho

SIGNAL NO.	MAKE	NO. OF SECT.	SIZE	VISOR	B.P. OR LOUVERS	MOUN'T
162		3	8"bike	T		SV-2-T*@8'
155		3	8"bike	T		SV-2-T*@8'

* Custom SV-2-T per figure below. 162 in Position A

